
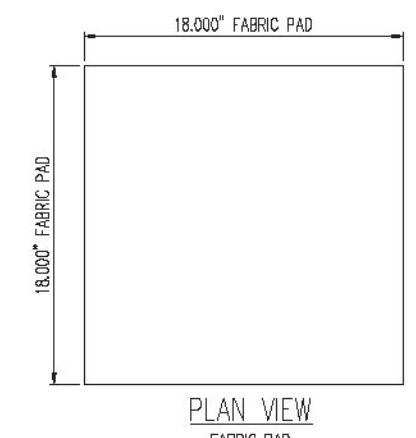


SOLE PLATE
 (4) REQ'D @ BRIDGE 11, ABUTMENT 1
 (4) REQ'D @ BRIDGE 11, ABUTMENT 2
 (8) REQ'D TOTAL

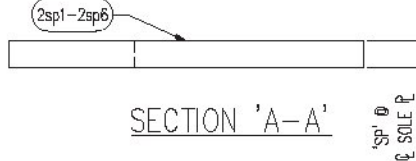

FABRIC PAD
 (4) REQ'D @ BRIDGE 11, ABUTMENT 1
 (4) REQ'D @ BRIDGE 11, ABUTMENT 2
 (8) REQ'D TOTAL

BRIDGE	ABUTMENT	ORDER	ASSN. NO.	SOLE PL. THICK.	QTY	T1	T2	SP
11	1	1	26	261	3	1.500"	1.500"	1.500"
11	1	4	26	262	1	1.400"	1.500"	1.500"
11	2	1	20	203	1	1.500"	1.500"	1.500"
11	2	2	20	204	1	2.800"	2.800"	2.750"
11	2	3	20	205	1	1.600"	1.360"	1.360"
11	2	4	20	206	1	1.900"	1.360"	1.360"

GENERAL NOTES:

- MATERIALS SHALL CONFORM TO STATE OF VERMONT AGENCY OF TRANSPORTATION STANDARD SPECIFICATIONS FOR CONSTRUCTION, DATED 2011 AND THE LATEST REVISIONS, INCLUDING SUPPLEMENTARY SPECIFICATIONS, CONTRACT PLANS, AND THE SPECIAL PROVISIONS. GENERAL SHOP PRACTICES, STRUCTURAL FABRICATION, WELDING AND ASSEMBLY SHALL BE COVERED BY AWS/AASHTO/AWS D1.5 BRIDGE WELDING CODE.
- THIS SHOP DRAWING WAS PREPARED IN ACCORDANCE WITH THE CONTRACT PLANS AND SPECIFICATIONS. THE U.S. BROWN COMPANY DOES NOT ACCEPT LIABILITY FOR THE DESIGN OF THE PRODUCTS DETAILED IN THIS SHOP DRAWING.
- THE U.S. BROWN COMPANY TO SUPPLY ONLY THE PARTS SHOWN ON THIS SHOP DRAWING.
- ALL STEEL SHALL BE PRODUCED IN THE UNITED STATES OF AMERICA.
- ALL CORNERS AND EDGES OF STEEL PLATES SHALL BE ROUNDED TO A 1/16" RADIUS FOR GALVANIZING.
- ALL EXTERNAL STEEL SHALL BE GALVANIZED IN ACCORDANCE WITH AASHTO M111 AND M333 (ASTM 123 & 133) SPECIFICATIONS. IN ACCORDANCE WITH SECTION 726.08 OF THE STANDARD SPECIFICATIONS, REPAIR DAMAGED HOT DIPPED GALVANIZING PER ASTM A780, ANNEAL A2. THE PAINT USED IN THE REPAIR SHALL BE ORGANIC-ZINC, CONTAINING 92% MINIMUM ZINC BY WEIGHT IN THE DRY FILM. THE PAINT SHALL BE APPLIED PER MANUFACTURER'S RECOMMENDATIONS TO A THICKNESS EQUIVALENT TO THE SURROUNDING GALVANIZING.
- CALCULATED LIFTING DEVICES MAY BE WELDED TO PARTS IF NECESSARY. WHEN THEIR USE IS COMPLETE, REMOVE AND GRIND FLUSH ALL CONNECTION LOCATIONS. REPAIR AREA PER ASTM A780 ANNEX A2.
- BEARING MANUFACTURING FACILITY AND REPRESENTATIVE FOR COORDINATING PRODUCTION:
 THE U.S. BROWN COMPANY
 200 EAST CHERRY STREET
 NORTH BALTIMORE, OHIO 43812
 CSR - ERIC JOHNSON - (419) 257-1581

MARKING NOTES:

- EACH BEARING SHALL BE PERMANENTLY MARKED. THE MARKING SHALL CONSIST OF THE ORDER NUMBER, LOT NUMBER, PAD IDENTIFICATION NUMBER, AND SP STATION. WHERE POSSIBLE, THE MARKING SHALL BE ON A FACE WHICH IS VISIBLE AFTER ERECTION OF THE STRUCTURE.
- MARK THE THICKER EDGE OF THE BEVELED PLATE FOR IDENTIFICATION IN THE FIELD.

CONTRACTOR NOTES:

- WELDING PROCEDURES SHALL BE ESTABLISHED BY THE CONTRACTOR TO RESTRICT THE TEMPERATURE TO A MAXIMUM OF 200°F (93°C) FOR SURFACES IN CONTACT WITH THE ELASTOMER. TEMPERATURES SHALL BE DETERMINED BY TEMPERATURE INDICATING WAX PENCILS OR OTHER SUITABLE MEANS.

NO.	QTY	DESCRIPTION	MATERIAL	LENGTH	REMARKS	WT (LBS)
261	3	SOLE PLATE	S18111011	20.000'	M111-HSD (A133)	187
262	1	SOLE PLATE	M270 GR 50 (A109)	20.000'	M11-HSD (A133)	181
263	1	SOLE PLATE	S18111011	20.000'	M11-HSD (A133)	179
264	1	SOLE PLATE	M270 GR 50 (A109)	20.000'	M11-HSD (A133)	179
265	1	SOLE PLATE	S18111011	20.000'	M11-HSD (A133)	170
266	1	SOLE PLATE	M270 GR 50 (A109)	20.000'	M11-HSD (A133)	170
267	1	SOLE PLATE	S18111011	20.000'	M11-HSD (A133)	167
268	1	SOLE PLATE	M270 GR 50 (A109)	20.000'	M11-HSD (A133)	167
269	1	SOLE PLATE	S18111011	20.000'	M11-HSD (A133)	184
270	1	SOLE PLATE	M270 GR 50 (A109)	20.000'	M11-HSD (A133)	184
271	1	SOLE PLATE	S18111011	20.000'	M11-HSD (A133)	217
272	1	SOLE PLATE	M270 GR 50 (A109)	20.000'	M11-HSD (A133)	217
273	8	FABRIC PAD	VT 731.00	18.000'		3
274	8	FABRIC PAD	VT 731.00	18.000'		3

DESCRIPTION	TOLERANCE (INCHES U.N.C.)
STEEL PLATE THICKNESS	±0.003
STEEL PLATE FLATNESS	±0.003
STEEL PLATE FLATNESS IN CONTACT WITH BEARING	±0.001 X NOM. DIMENSION
STEEL PLATE FLATNESS: BRIDGE OR CONCRETE SIDE	±0.002 X NOM. DIMENSION
STEEL PLATE FLATNESS: STEEL ORDER SIDE	±0.002 X NOM. DIMENSION
STEEL PLATE FLATNESS: STEEL PLATE SIDE	±0.001 X NOM. DIMENSION
STEEL PLATE SURFACE FINISH IN CONTACT WITH BEARING	125 μ INCH
BEVEL SLOPE	±0.002 INCH
PIPE THICKNESS	±0.001 ±0.001
PIPE FLATNESS	-0.001, +0.000
PIPE FLATNESS	±0.001 X NOM. DIMENSION

NOTE: SURFACE FINISH & FLATNESS TOLERANCES ARE PRIOR TO COATING.

Vermont Agency of Transportation
RECEIVED
 CK'D BY T1Lin OK'D BY T1Lin
 February 13, 2017
 RESUBMITTED No Approved
 BY Kinston Higgins DATE 2/14/2017

T.Y. LIN INTERNATIONAL
 THE STAMPED DOCUMENTS ARE HEREBY:
 APPROVED AS NOTED
 REVISION AND/OR SUBMIT
 SEE TRANSMITTAL FOR ADDITIONAL INFORMATION AS APPLICABLE.
 THIS REVIEW IS FOR GENERAL CONFORMANCE WITH DESIGN
 CONCEPT ONLY. ANY DESIGN VARIATION FROM THE PLANS OR
 SPECIFICATIONS NOT CLEARLY NOTED BY THE CONTRACTOR HAS
 NOT BEEN REVIEWED. DESIGN BY THE CONTRACTOR SHALL NOT
 BEAR IN THE CONTRACTOR OF THE CONTRACTUAL RESPONSIBILITY
 FOR ANY ERRORS OR OMISSIONS FROM THE CONTRACT
 REQUIREMENTS.
 JOHN CLINE February 14, 2017
 T.Y. LIN



NO.	DESCRIPTION	DATE	BY	CHK'D BY
1	NEW SHEET	2/10/17	EMF	T2Lin
2	REV. DESCRIPTION			
	LOCATION - VT ROUTE 110			
	BRIDGE - 11			
	PROJECT - CHELSEA BIF 0169 (3) & CHELSEA BIF 0169 (10)			
	P.O. NO. - 1			
	DESIGNER - T.Y. LIN INTERNATIONAL			
	CUSTOMER - CDM CONSTRUCTORS			

NO.	DESCRIPTION	DATE	BY	CHK'D BY
1	VERSIFLEX ELASTOMERIC BEARING	2/10/17	EMF	T2Lin
2	REV. DESCRIPTION			
	LOCATION - VT ROUTE 110			
	BRIDGE - 11			
	PROJECT - CHELSEA BIF 0169 (3) & CHELSEA BIF 0169 (10)			
	P.O. NO. - 1			
	DESIGNER - T.Y. LIN INTERNATIONAL			
	CUSTOMER - CDM CONSTRUCTORS			