


STATE OF VERMONT  
 AGENCY OF TRANSPORTATION  
 PROPOSED PREFABRICATED  
 BRIDGE UNIT SUBMITTAL

BRIDGE #9  
 TOWN OF CHELSEA  
 COUNTY OF ORANGE

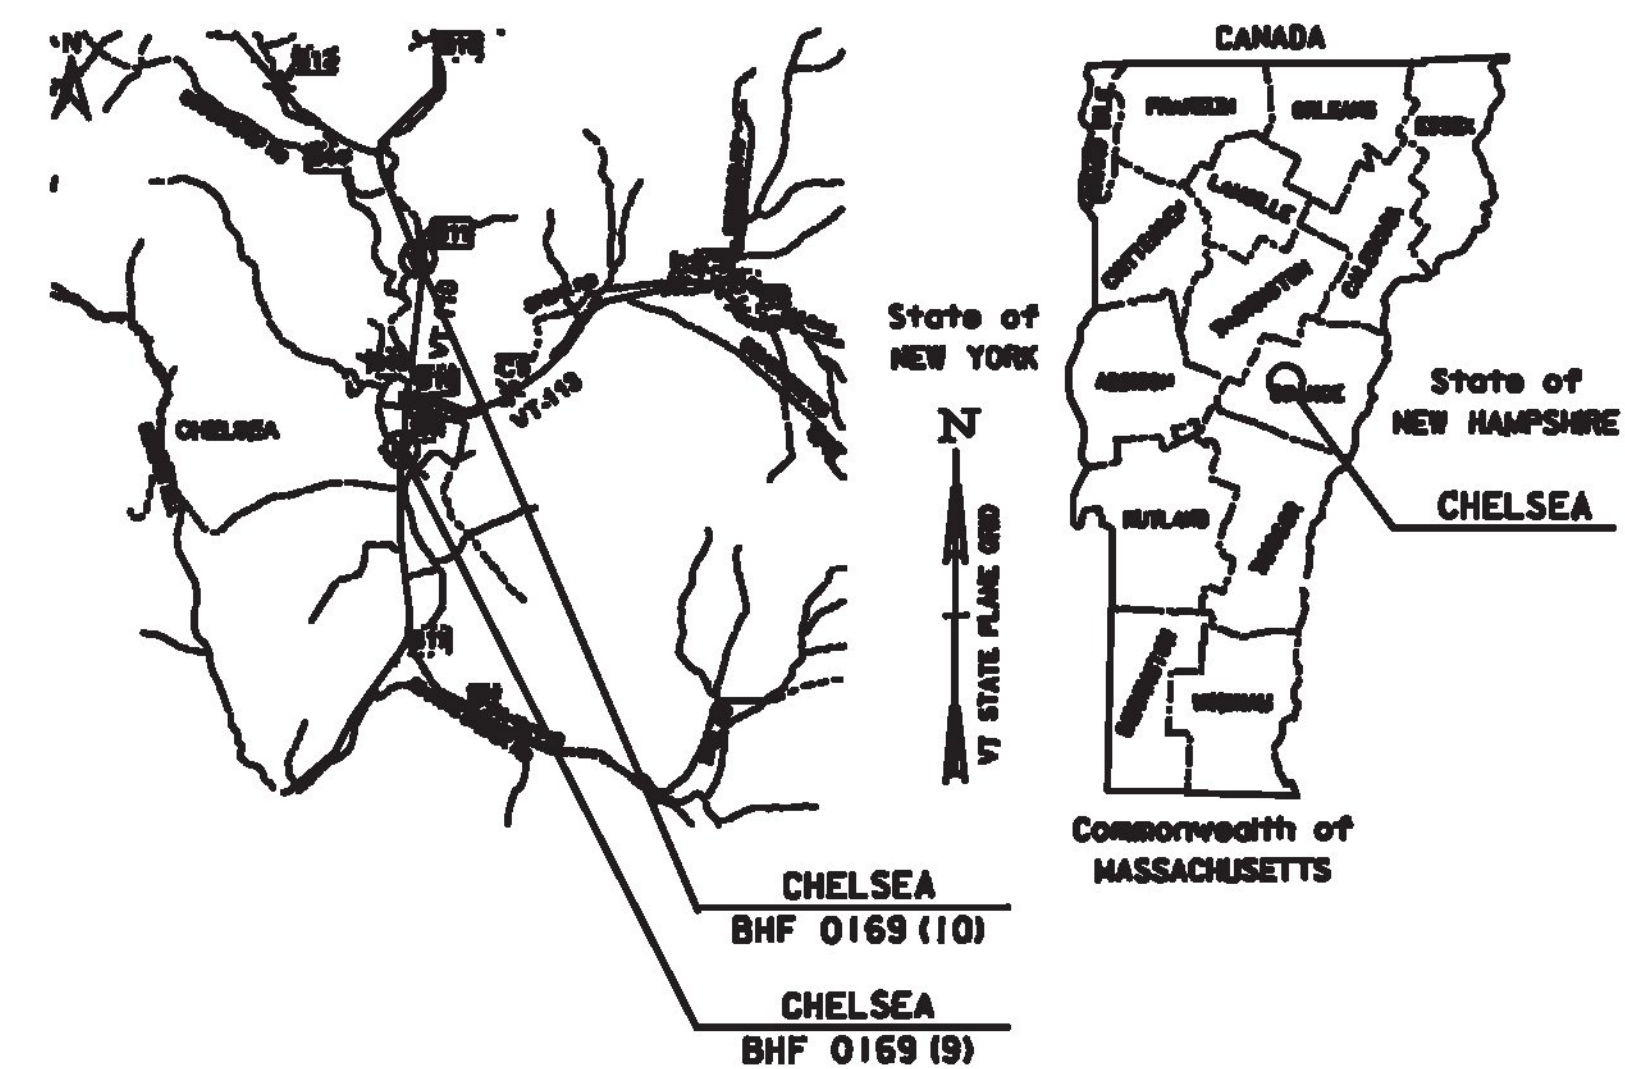

**LIST OF DRAWINGS**

- SHEET 1 - TITLE SHEET
- SHEET 2 - PBU PLAN
- SHEET 3 - TYPICAL PBU SECTION
- SHEET 4 - PBU 1 & 2 DETAILS
- SHEET 5 - PBU 3 & 4 DETAILS
- SHEET 6 - PBU CLOSURE POUR DETAILS
- SHEET 7 - CURTAIN WALL DETAILS
- SHEET 8 - INSERT DETAILS
- SHEET 9 - TEMPORARY SUPPORT ELEVATIONS
- SHEET 10 - QC PROCEDURE AND PLAN
- SHEET 11 - REPAIR PROCEDURE / SHIPPING AND HANDLING PROCEDURE / TEMPORARY ASSEMBLY PLAN AND PROCEDURE
- APPENDIX "A" - LIFTING ATTACHMENT, TEMPORARY ABUTMENT BRACING & BOTTOM OF SLAB ELEVATIONS DETAILS
- APPENDIX "B" - TYPICAL DECK FORMWORK DETAILS
- APPENDIX "C" - REBAR DETAILS
- APPENDIX "D" CONCRETE MIX DESIGN

**CHELSEA BHF 0169 (9)**

ROUTE NO · VT ROUTE 110, RURAL MAJOR COLLECTOR

BRIDGE NO · 9

PROJECT LOCATION 0.2 MILES SOUTH OF THE JUNCTION WITH VT ROUTE 113

Vermont Agency of Transportation  
**RECEIVED**  
 CK'D BY TYLin OK'D BY TYlin  
 April 5, 2017  
 RESUBMIT No Approved AsNoted  
 BY Kristin Higgins DATE 4/7/2017

**T.Y. LIN INTERNATIONAL**  
 THE STAMPED DOCUMENTS ARE HEREBY:  
 APPROVED  
 APPROVED AS NOTED  
 REVISE AND RESUBMIT  
 SEE TRANSMITTAL FOR ADDITIONAL INFORMATION AS APPLICABLE.  
 THIS REVIEW IS FOR GENERAL CONFORMANCE WITH DESIGN CONCEPT ONLY. ANY DEVIATION FROM THE PLANS OR SPECIFICATIONS NOT CLEARLY NOTED BY THE CONTRACTOR HAS NOT BEEN REVIEWED. REVIEW BY THE ENGINEER SHALL NOT RELIEVE THE CONTRACTOR OF THE CONTRACTUAL RESPONSIBILITY FOR ANY ERRORS OR DEVIATION FROM THE CONTRACT REQUIREMENTS.  
 JOSH OLUND REVIEWER April 5, 2017 DATE

	<b>CPM CONSTRUCTORS</b> <small>80 BOURNET STREET        P.O. BOX 9        FERRISBURGH, VERMONT 05753-0009        (802) 885-0000 FAX (802) 885-0008</small>
<b>PROJECT INFORMATION</b>	<b>TITLE SHEET</b> <b>BHF 0169 (09)</b> <b>CHELSEA, VERMONT</b>
<b>SHEET NUMBER</b> <div style="font-size: 2em; font-weight: bold; margin: 0;">1</div>	<b>OF 11</b>