


**BRIDGE NO. 9
PBU PLAN**

NOTES:

1. FINISHES
 - TOP: SCREED
 - SIDEWALK: PROVIDE RAKE FINISH WITHIN LIMITS OF THE SIDEWALK AND RAILING STIRRUPS. SEE STRUCTURES DETAIL SHEETS SD-501.00 AND 502.00.
 - SIDES AND ENDS: 1/8" ROUGHEN SURFACE WITH EXPOSED AGGREGATE ON ALL SURFACES THAT WILL COME IN CONTACT WITH RAPID SET CONCRETE (CLOSURE POURS). EUCLID FORMULA "F" CONCRETE SURFACE RETARDER SHALL BE ADDED TO FORMS TO OBTAIN THIS FINISH.
 - CONSTRUCTION JOINTS: THE CONSTRUCTION JOINT BETWEEN THE CURTAIN WALL AND DECK OF EACH PBU SHALL BE PREPARED IN ACCORDANCE WITH SUBSECTION 501.13 (b). JOINING FRESH CONCRETE TO PREVIOUSLY SET CONCRETE.
 - BOTTOM: FORM
2. CONCRETE. VERMONT CLASS HPC A ($f_c=4000$ PSI).
3. BRIDGE RAIL AND CURB TO BE CAST AFTER PBU'S ARE INSTALLED ON SITE AND GRATED TOGETHER

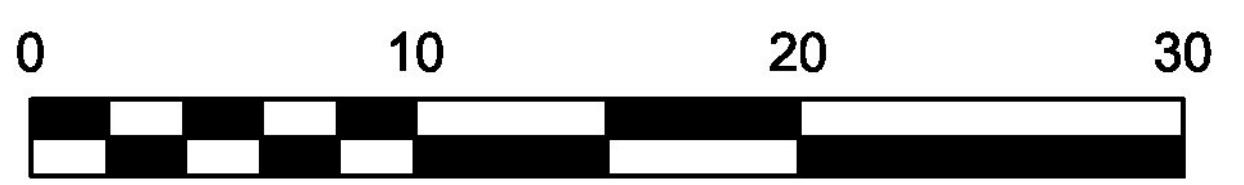

Vermont Agency of Transportation
RECEIVED
CK'D BY TYLin OK'D BY TYLin
April 5, 2017
RESUBMIT No Approved
BY Kristin Higgins DATE 4/7/2017

T.Y. LIN INTERNATIONAL
THE STAMPED DOCUMENTS ARE HEREBY:
 APPROVED
 APPROVED AS NOTED
 REVISE AND RESUBMIT
SEE TRANSMITTAL FOR ADDITIONAL INFORMATION AS APPLICABLE.
THIS REVIEW IS FOR GENERAL CONFORMANCE WITH DESIGN CONCEPT ONLY. ANY DEVIATION FROM THE PLANS OR SPECIFICATIONS NOT CLEARLY NOTED BY THE CONTRACTOR HAS NOT BEEN REVIEWED. REVIEW BY THE ENGINEER SHALL NOT RELIEVE THE CONTRACTOR OF THE CONTRACTUAL RESPONSIBILITY FOR ANY ERRORS OR DEVIATION FROM THE CONTRACT REQUIREMENTS.
JOSH OLUND REVIEWER April 5, 2017 DATE

CPM CONSTRUCTORS
80 BOURNET STREET
P.O. BOX 9
WATERBURY, VT 05671
(802) 244-0000 FAX (802) 862-0000



PROJECT INFORMATION	
JOB NAME:	BRIDGE NO. 9
JOB NUMBER:	09-09
APPROVED BY:	MARK HALL
DATE:	04/05/2017
SCALE:	1" = 10'

PROJECT INFORMATION	
DESIGNER:	
P.E. REVIEWER:	

**BRIDGE 09 PBU
PLAN**
BHF 0169(09)
CHELSEA, VERMONT

SHEET NUMBER
2
OF 11