


This needs to run in the railing and outlet through the curtain walls as shown in the contract documents

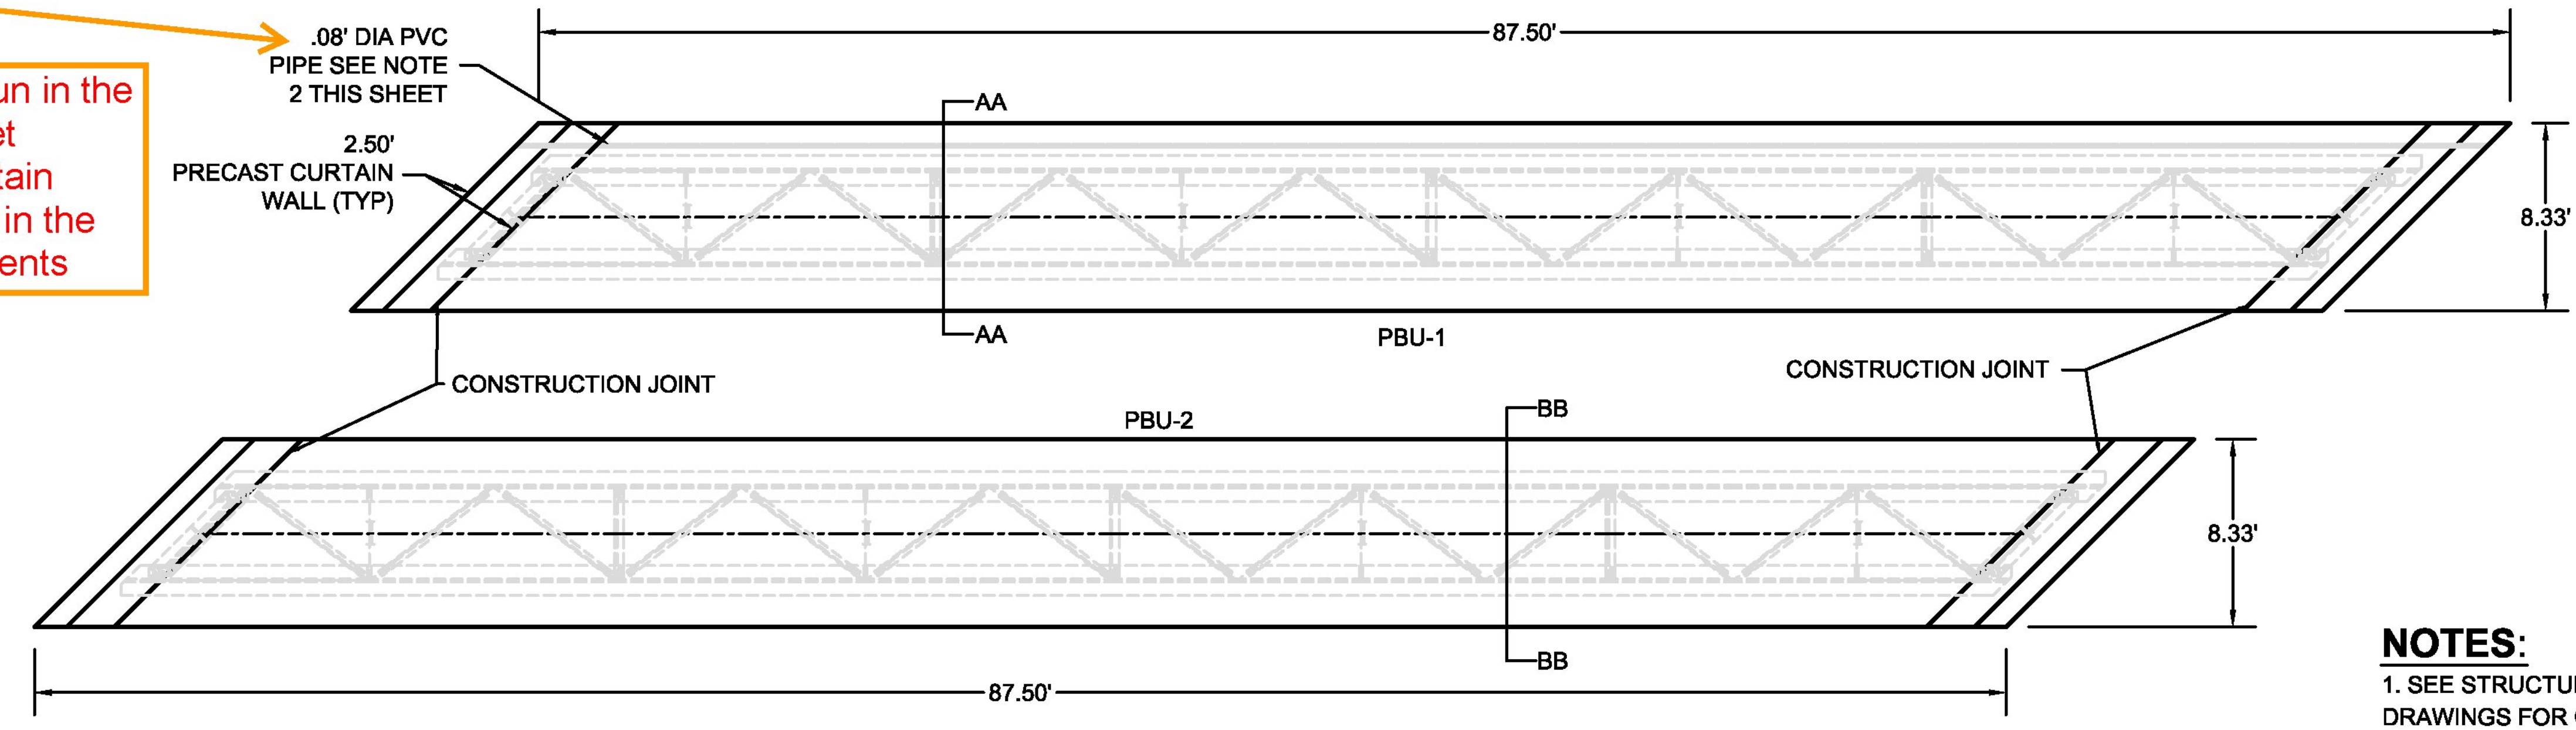

**BRIDGE NO. 9**  
**PBU 1&2 PLAN**  
SCALE: 1"=10'

- NOTES:**
1. SEE STRUCTURAL STEEL SHOP DRAWINGS FOR GIRDER INFORMATION.
  2. ONE INCH SCHEDULE 80 PVC CONFORMING TO ASTM D 1784 SPECIFICATIONS.

**CPM CONSTRUCTORS**  
80 BOURNET STREET  
P.O. BOX 9  
FERRISBURGH, VT 05753-0009  
(802) 885-0000 FAX (802) 885-0008




DESIGNER	
CHECKED	
DATE	
APPROVED	
DATE	
SCALE	1" = 10'

PROJECT INFORMATION	
JOB NAME	
JOB NUMBER	
APPROVED BY	
DATE	
SCALE	1" = 10'


**PBU 1 & 2**  
**DETAILS**  
**BHF 0169(09)**  
**CHELSEA, VERMONT**

**SHEET NUMBER**  
**4**  
**OF 11**

This needs to run in the railing and outlet through the curtain walls as shown in the contract documents

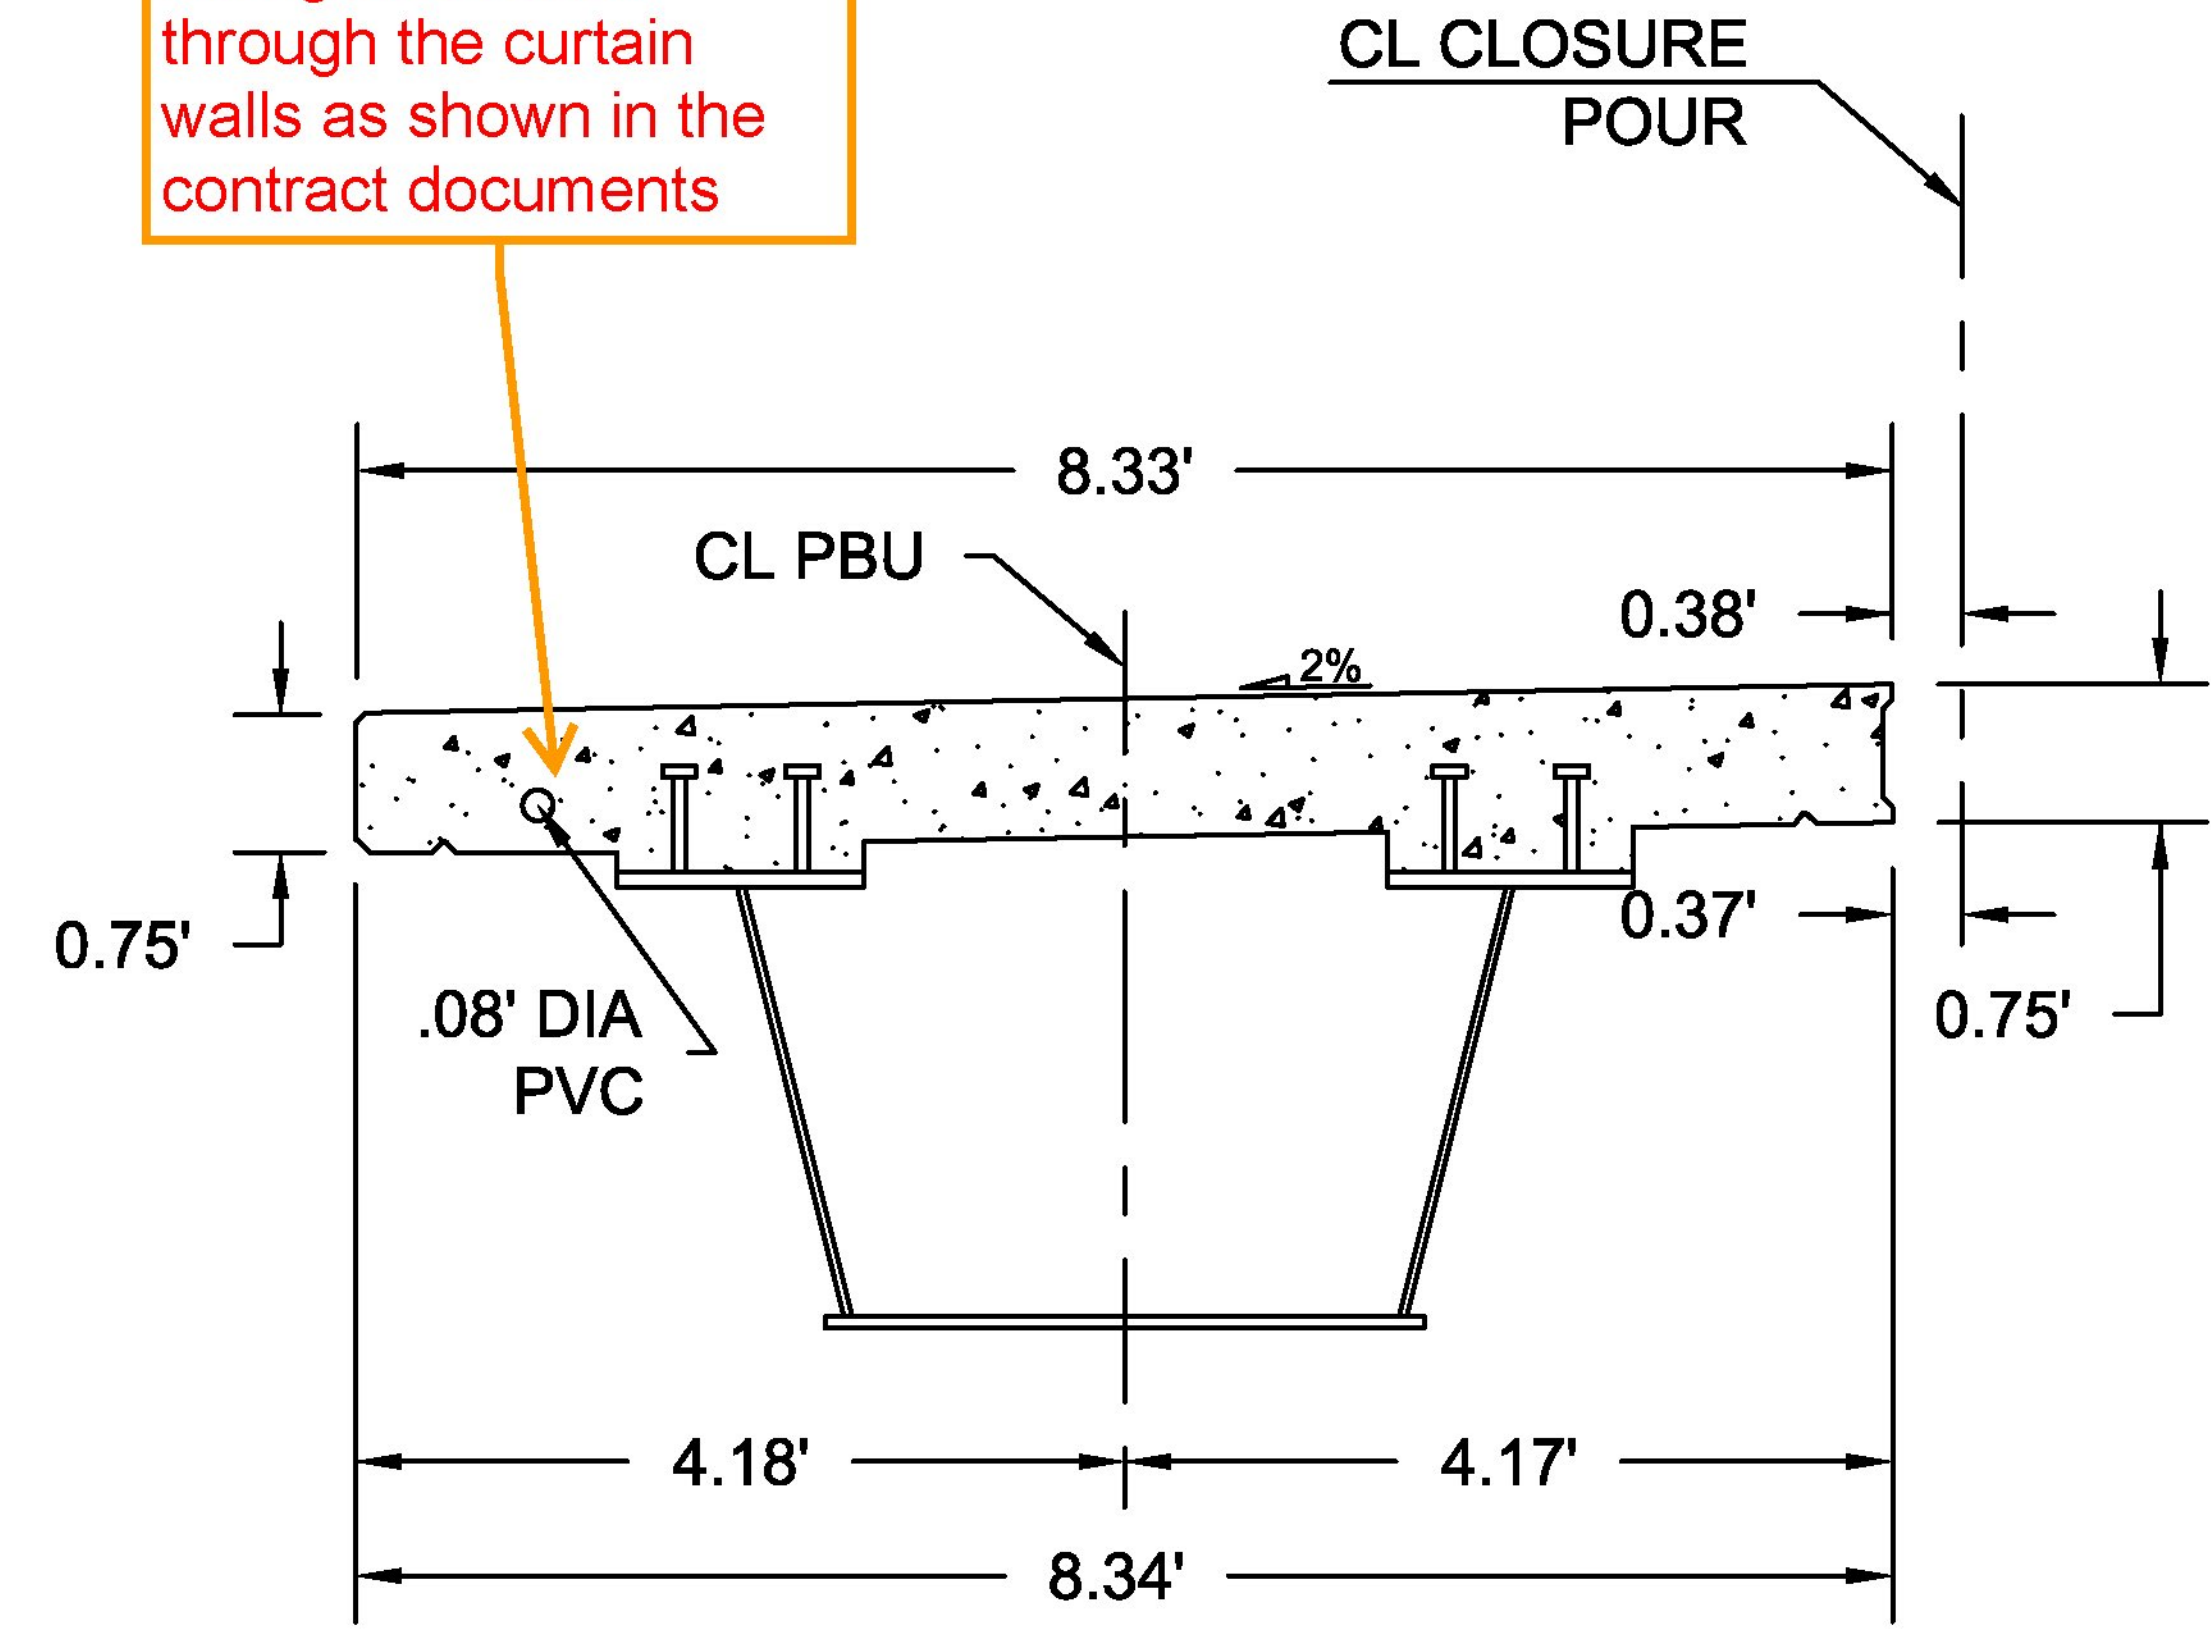

**PBU 1 SECTION "AA"**  
**N.T.S.**

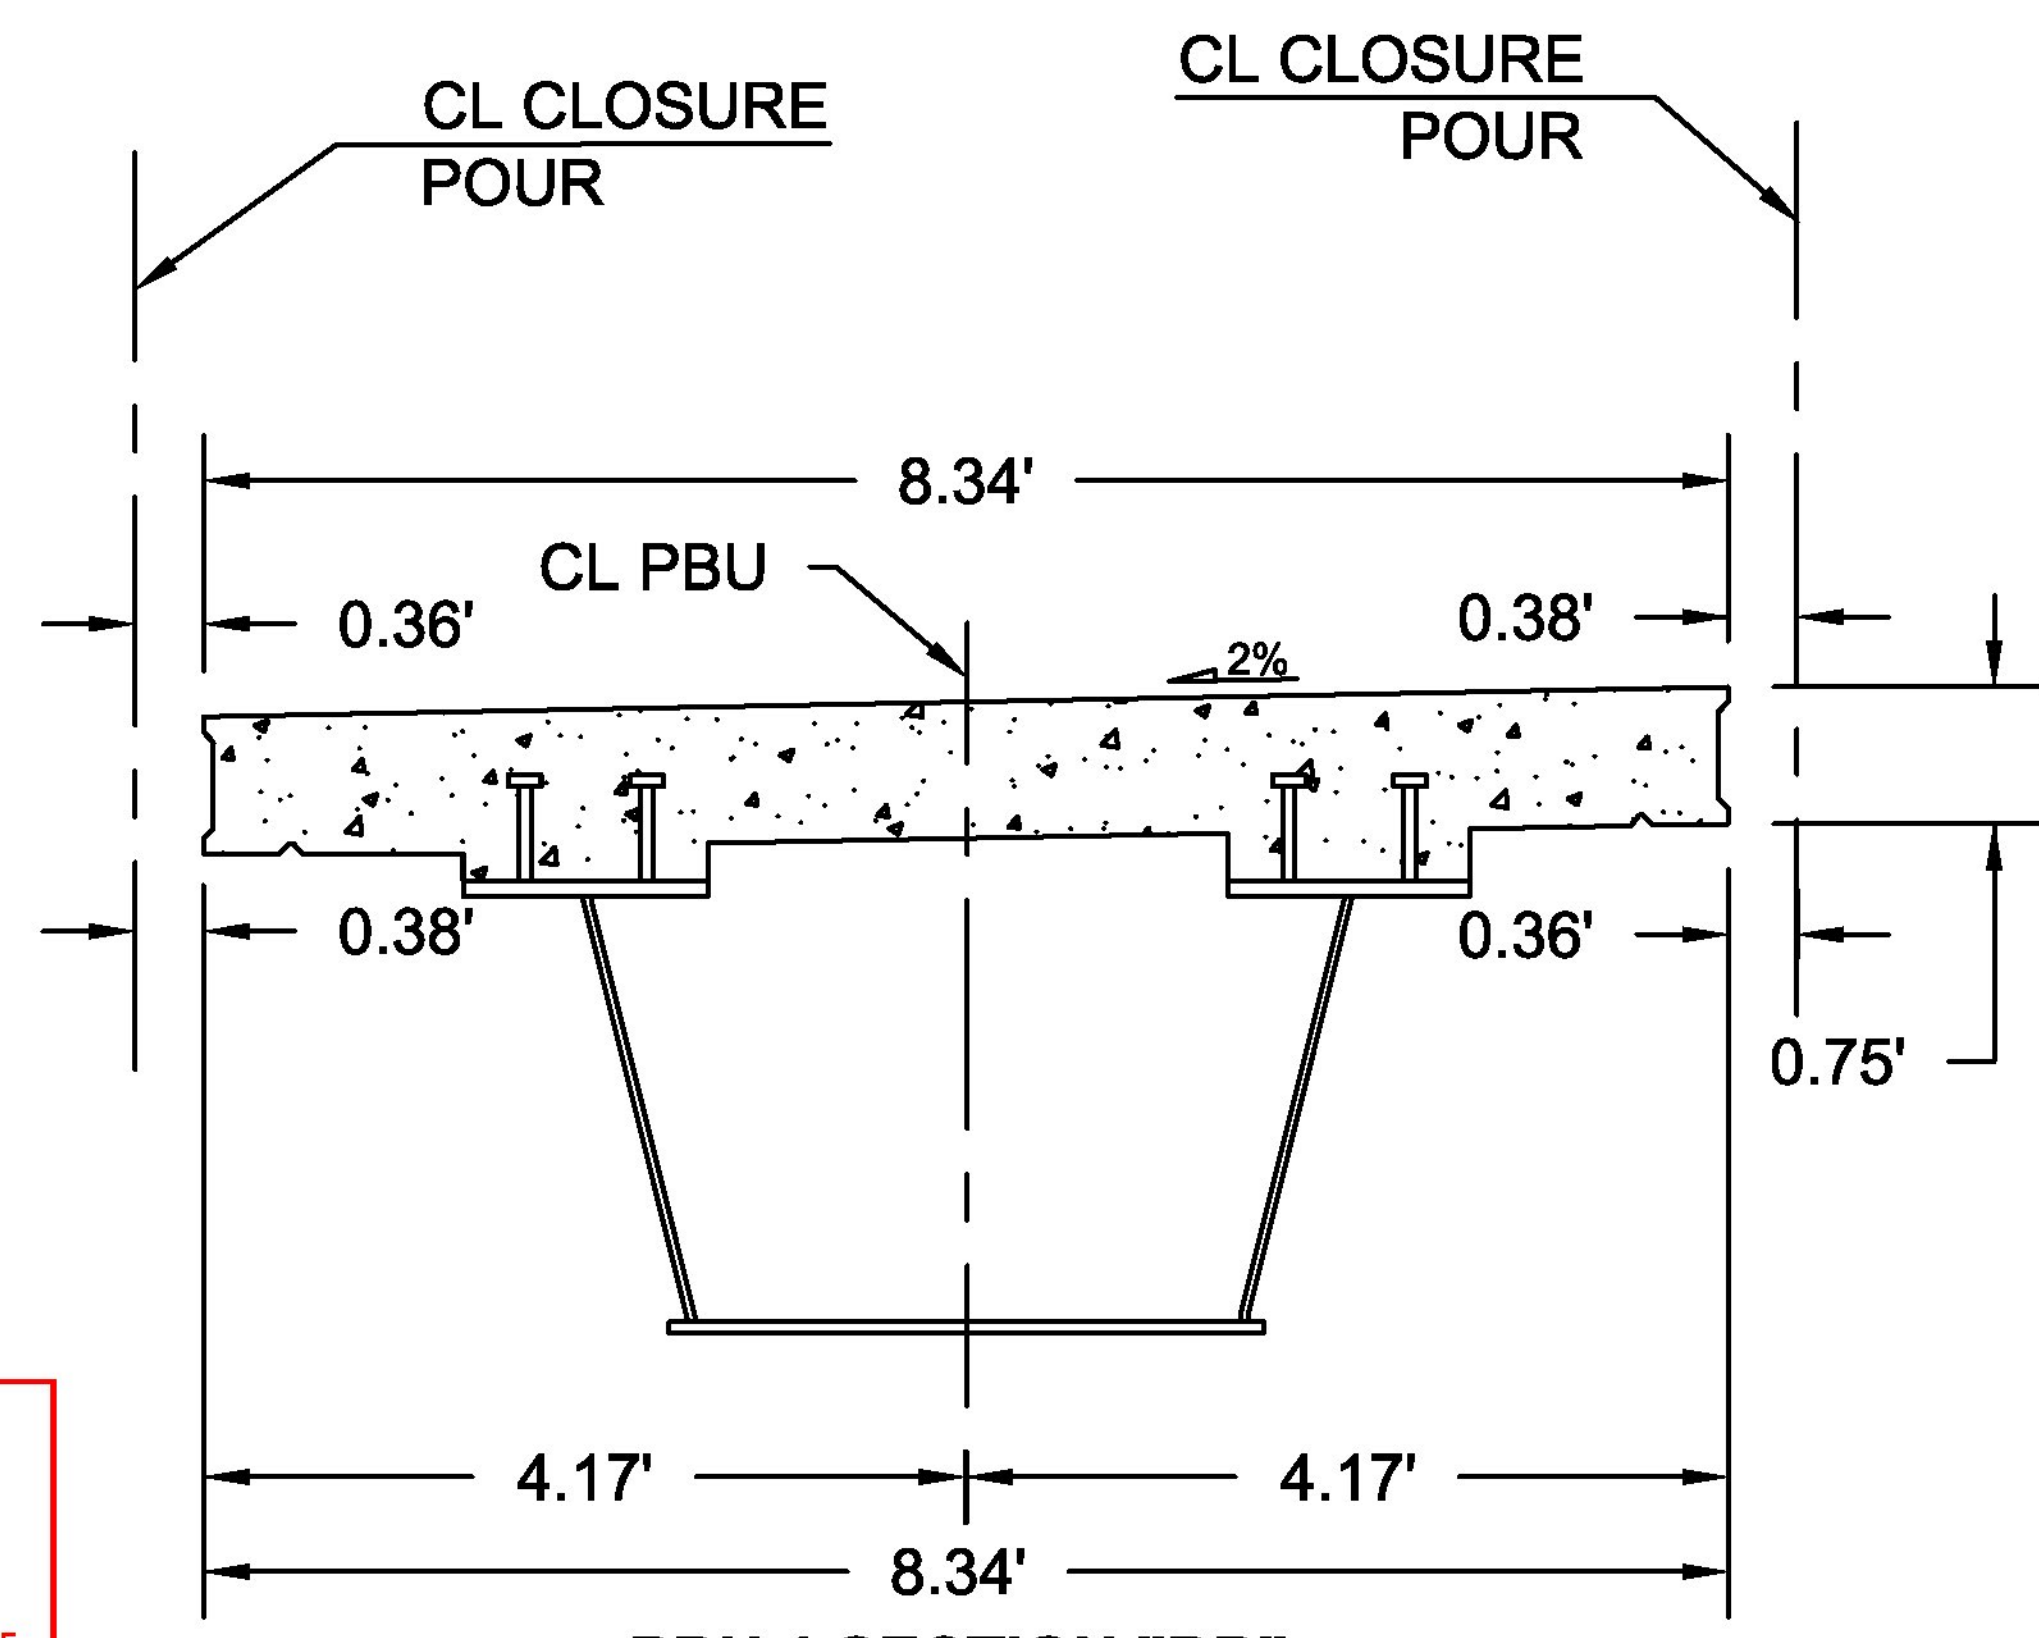

**PBU 1 SECTION "BB"**  
**N.T.S.**

Vermont Agency of Transportation  
**RECEIVED**  
CK'D BY TYLin OK'D BY TYLin  
April 5, 2017  
RESUBMIT No Approved AsNoted  
BY Kristin Higgins DATE 4/7/2017

**T.Y. LIN INTERNATIONAL**  
THE STAMPED DOCUMENTS ARE HEREBY:

APPROVED  
 APPROVED AS NOTED  
 REVISE AND RESUBMIT

SEE TRANSMITTAL FOR ADDITIONAL INFORMATION AS APPLICABLE.  
THIS REVIEW IS FOR GENERAL CONFORMANCE WITH DESIGN CONCEPT ONLY. ANY DEVIATION FROM THE PLANS OR SPECIFICATIONS NOT CLEARLY NOTED BY THE CONTRACTOR HAS NOT BEEN REVIEWED. REVIEW BY THE ENGINEER SHALL NOT RELIEVE THE CONTRACTOR OF THE CONTRACTUAL RESPONSIBILITY FOR ANY ERRORS OR DEVIATION FROM THE CONTRACT REQUIREMENTS.

JOSH OLUND REVIEWER April 5, 2017 DATE