


INTERIOR PBU'S  
 1/2" X 4" COIL LOOPS  
 @ 5.33' OC, MAX.  
 (SWL 1,200 #)  
 (17 PER SIDE)

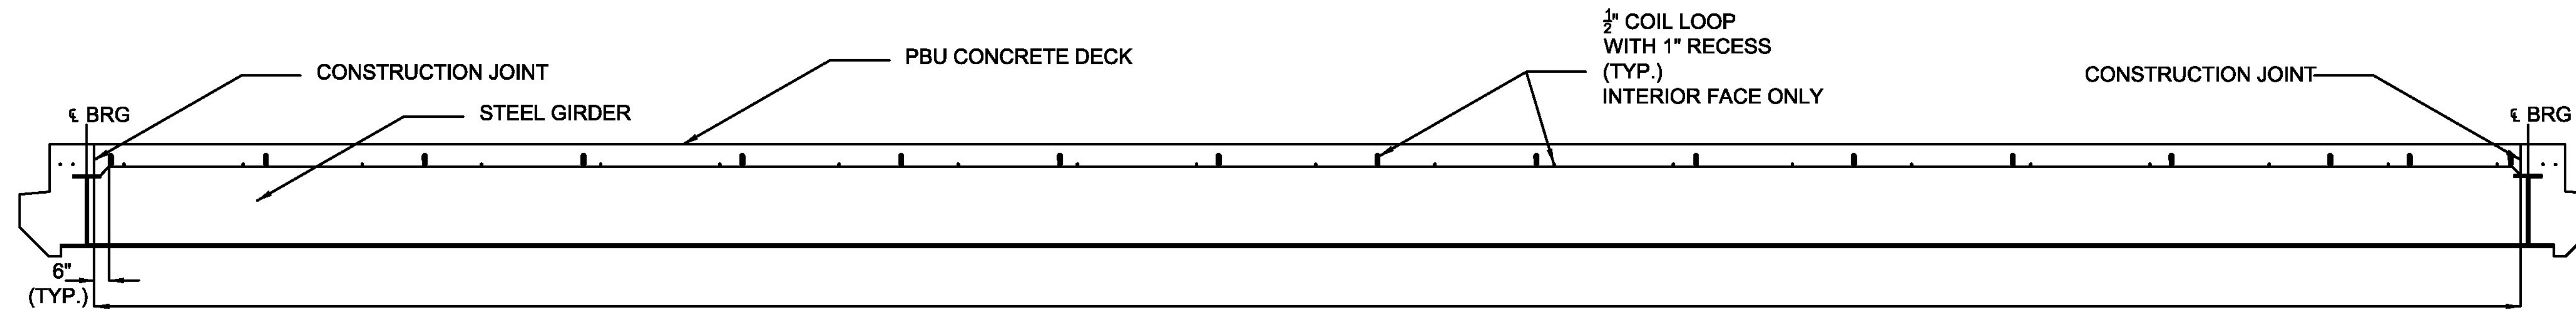

EXTERIOR PBU'S- FASCIA  
 14" - 45° ADJUSTABLE  
 HALF- ANGLE HANGER  
 W/ (2) STIRRUP CLIPS.  
 (SWL 3,000#) WITH  
 DAYTON C- 49 OVERHANG  
 BRACKET SPACED @ 4.00'  
 O/C. NO SCREED LOAD TO  
 BE APPLIED

2 X 6" JOIST @ 11" MAX O/C  
 3/4" BB PLYFORM CLASS 1 DECKING

INTERIOR FACE  
 1/2" X 4" COIL LOOPS  
 @ 5.33' OC, MAX.  
 (SWL 1,200 #)  
 (17 PER SIDE)

EXTERIOR FACE  
 1/2" X 4" COIL LOOPS  
 @ 4.00' OC, MAX.  
 (SWL 1,200 #)

**NOTE:**  
 1. ALL INSERTS REMAINING IN THE CONCRETE  
 IN THE FINAL CONDITION SHALL BE GALVANIZED.

Vermont Agency of Transportation  
**RECEIVED**  
 CK'D BY TYLin OK'D BY TYLin  
 April 5, 2017  
 RESUBMIT No Approved  
 BY Kristin Higgins DATE 4/7/2017

**T.Y. LIN INTERNATIONAL**  
 THE STAMPED DOCUMENTS ARE HEREBY:  
 APPROVED  
 APPROVED AS NOTED  
 REVISE AND RESUBMIT  
 SEE TRANSMITTAL FOR ADDITIONAL INFORMATION AS APPLICABLE.  
 THIS REVIEW IS FOR GENERAL CONFORMANCE WITH DESIGN  
 CONCEPT ONLY. ANY DEVIATION FROM THE PLANS OR  
 SPECIFICATIONS NOT CLEARLY NOTED BY THE CONTRACTOR HAS  
 NOT BEEN REVIEWED. REVIEW BY THE ENGINEER SHALL NOT  
 RELIEVE THE CONTRACTOR OF THE CONTRACTUAL RESPONSIBILITY  
 FOR ANY ERRORS OR DEVIATION FROM THE CONTRACT  
 REQUIREMENTS.  
 JOSH OLUND April 5, 2017  
 REVIEWER DATE

CPM CONSTRUCTORS  
 80 BOURNET STREET  
 P.O. BOX 9  
 FERRISBURGH, VERMONT 05753-0009  
 (802) 885-0000 FAX (802) 885-0008



DESIGNER	
P.E. REVIEWER	
DATE	

JOB NAME	TRUST GENERAL
JOB NUMBER	800-49
APPROVED BY	MARK HALL
DATE	04/07/2017
SCALE	AS SHOWN

**INSERT DETAILS**  
**BHF 0169(9)**  
**CHELSEA, VERMONT**

**SHEET NUMBER**  
 8  
 of 11