

STATE OF VERMONT AGENCY OF TRANSPORTATION




PROPOSED IMPROVEMENT BRIDGE PROJECT

TOWN OF JAY
COUNTY OF ORLEANS
ROUTE NO: VT RTE 242, RURAL MAJOR COLLECTOR BRIDGE NO.10


PROJECT LOCATION: 2.3 MILES WEST OF JUNCTION WITH VT ROUTE 101

PROJECT DESCRIPTION: REPLACEMENT OF EXISTING BRIDGE WITH A GALVANIZED STEEL BEAM AND CAST-IN-PLACE CONCRETE DECK SUPERSTRUCTURE AND A CONCRETE SUBSTRUCTURE, WITH RELATED ROADWAY AND CHANNEL WORK.

LENGTH OF STRUCTURE: 50.20 FEET
LENGTH OF ROADWAY: 108.14 FEET
LENGTH OF PROJECT: 158.34 FEET


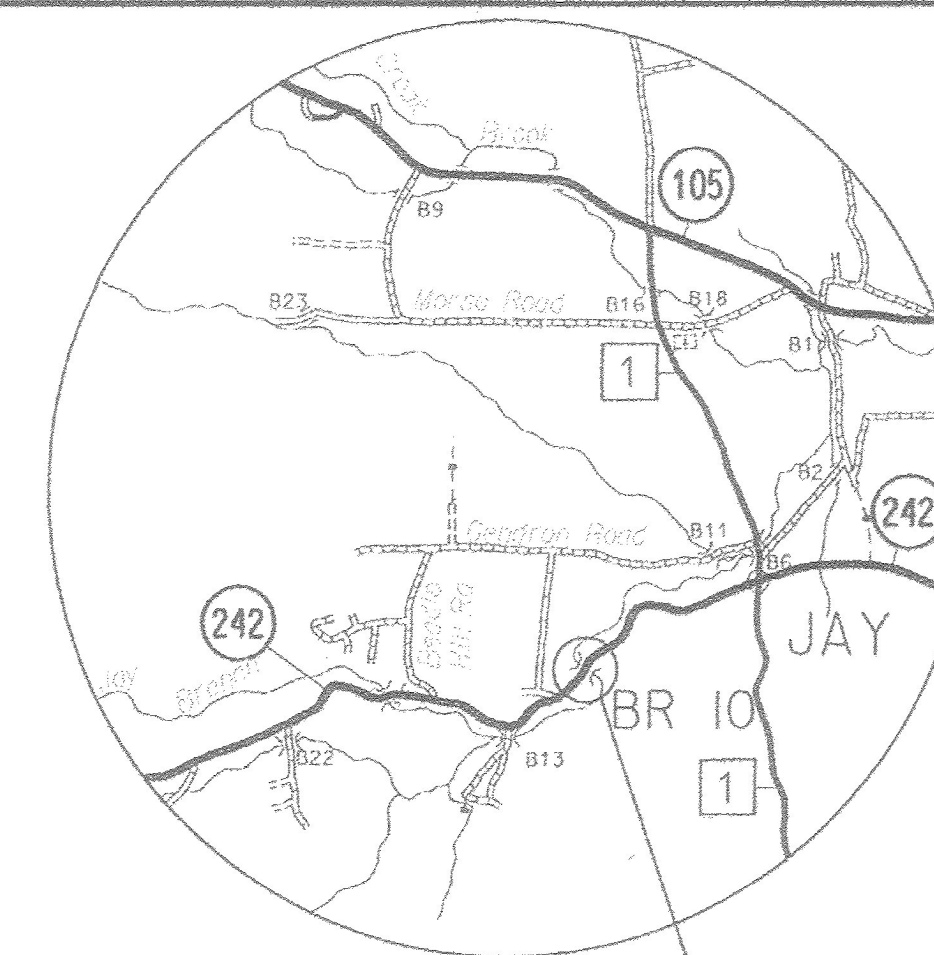


LOCATION MAP
NOT TO SCALE

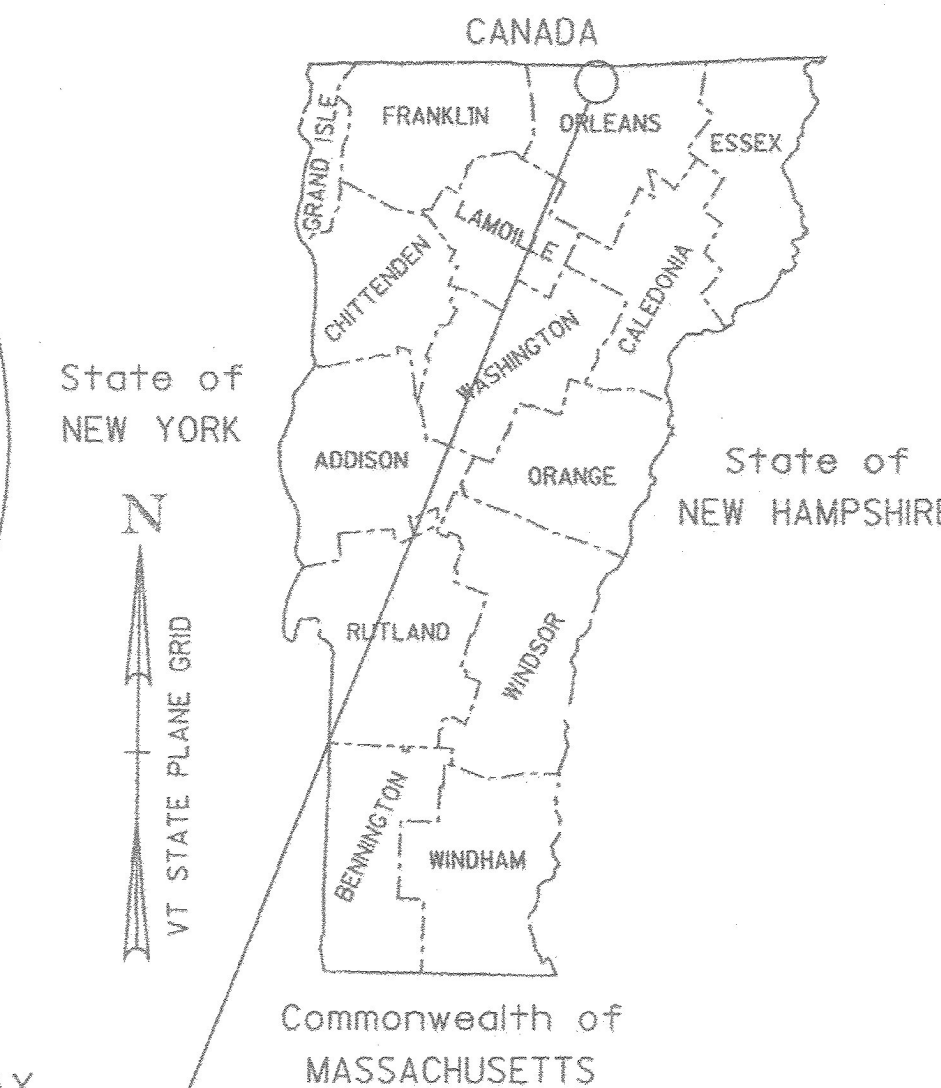

Commonwealth of MASSACHUSETTS

JAY
BHF 0278 (3)

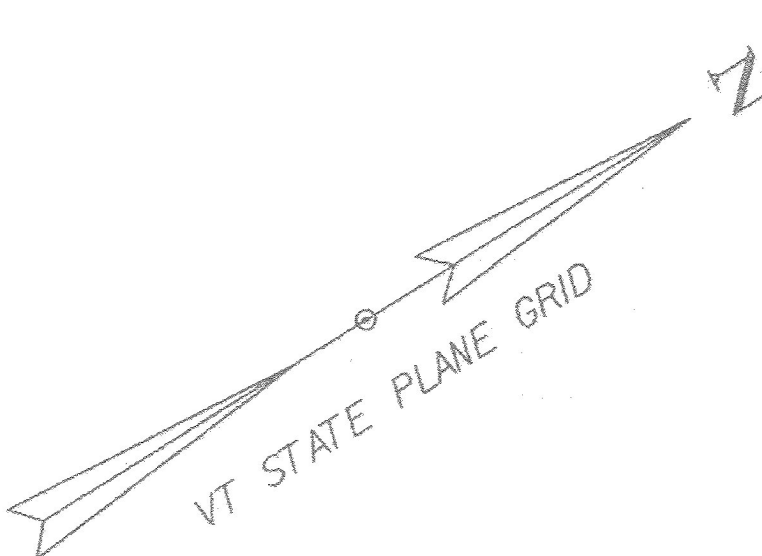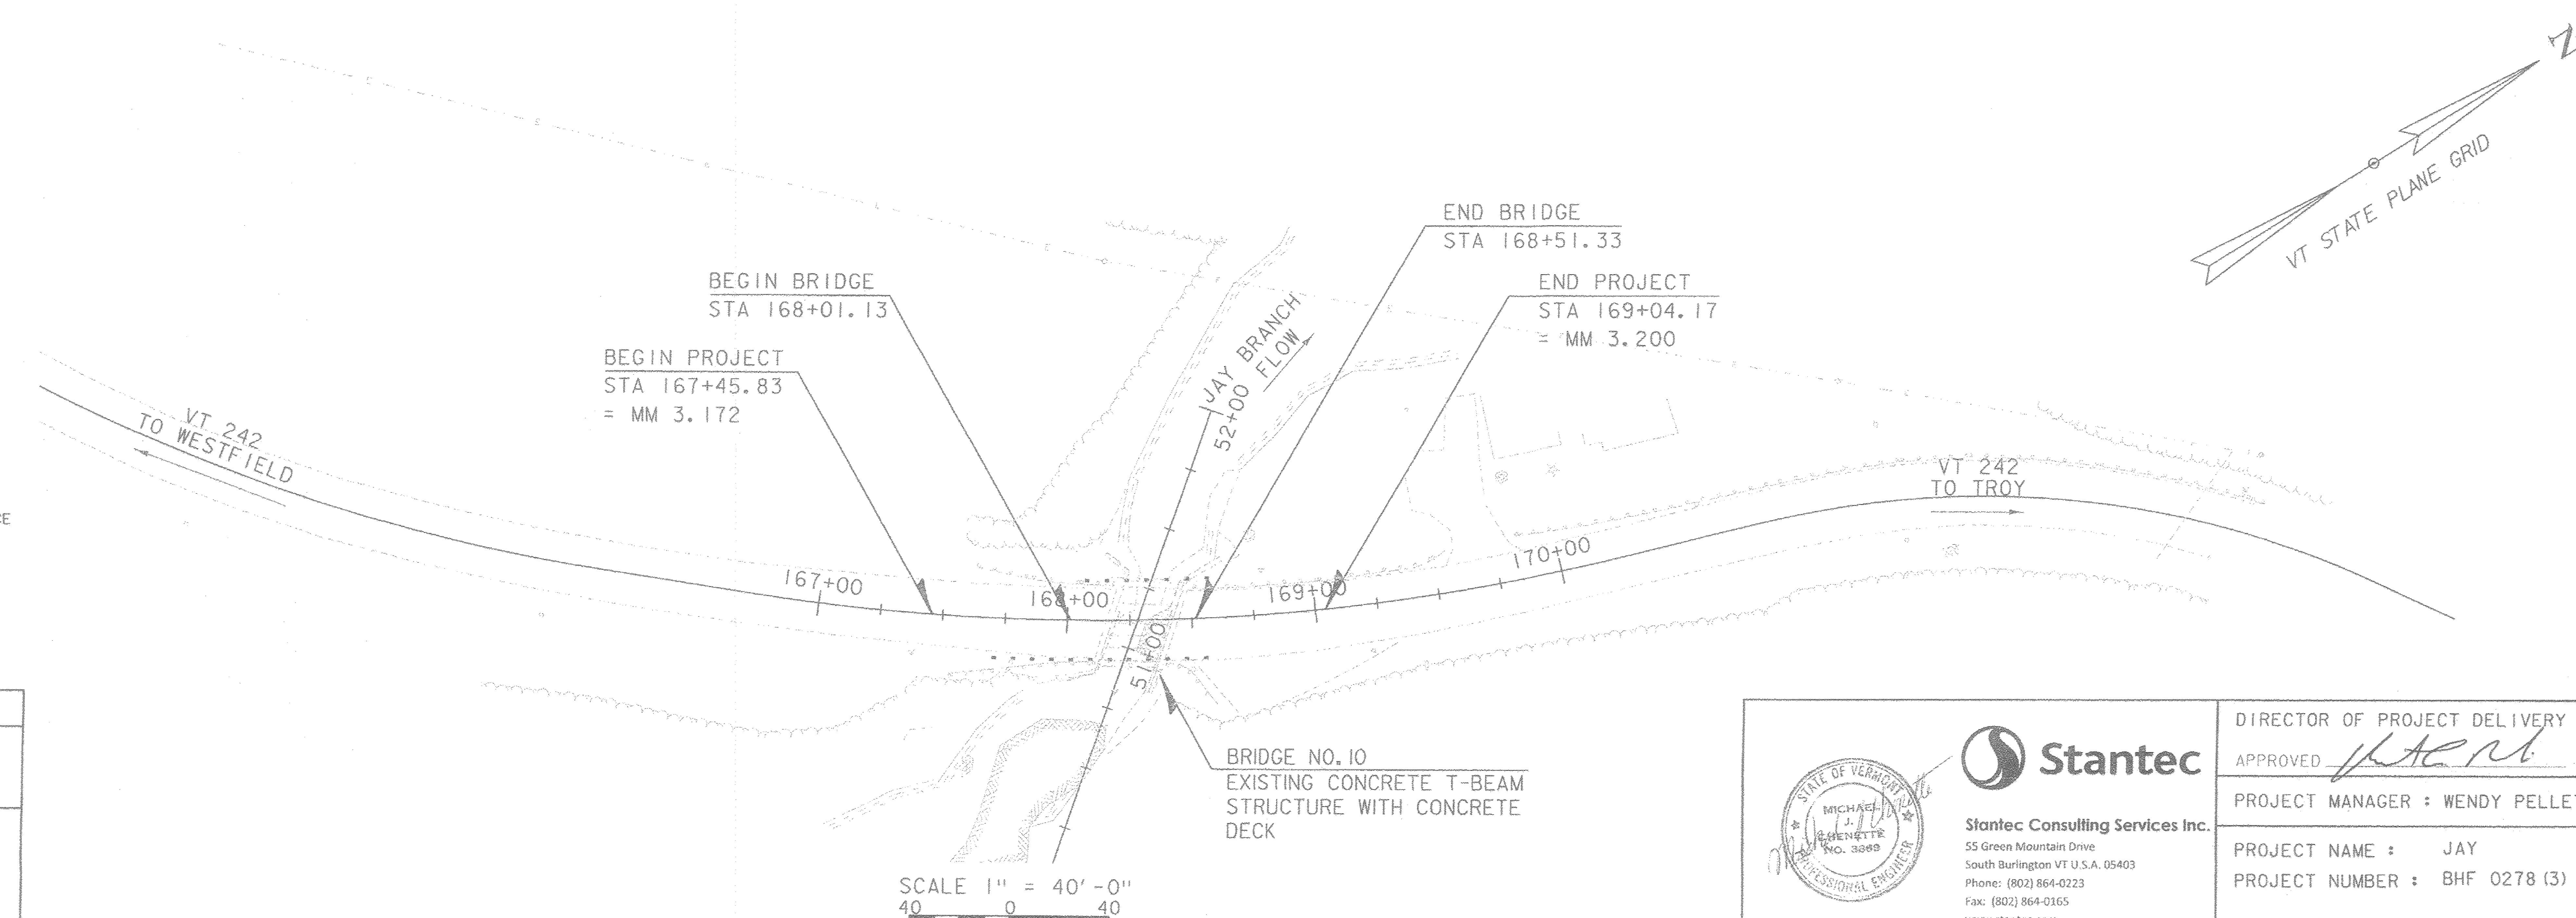


RECORD PLANS	
CONTRACTOR:	A.L. ST. ONGE CONTRACTOR, INC. - MONTGOMERY, VT.
RESIDENT ENGINEER:	SETH HISMAN
CONSTRUCTION BEGAN:	APRIL 18, 2017
CONSTRUCTION COMPLETE:	OCTOBER 18, 2017
RECORD PLANS BY:	SETH HISMAN & AARON WEAVER
I HEREBY CERTIFY THAT ALL THE CONSTRUCTION REQUIRED BY THIS SET OF DRAWINGS HAS BEEN ACCOMPLISHED AS INDICATED HEREIN.	
BY:	RESIDENT ENGINEER
DATE:	6/25/18
NOTE: Any further information concerning final quantities, amounts or other details relative to this project may be found at Central Files in the electronic archives.	

CONSTRUCTION IS TO BE CARRIED ON IN ACCORDANCE WITH THESE PLANS AND THE STANDARD SPECIFICATIONS FOR CONSTRUCTION DATED 2011, AS APPROVED BY THE FEDERAL HIGHWAY ADMINISTRATION ON JULY 20, 2011 FOR USE ON THIS PROJECT, INCLUDING ALL SUBSEQUENT REVISIONS AND SUCH REVISED SPECIFICATIONS AND SPECIAL PROVISIONS AS ARE INCORPORATED IN THESE PLANS.

QUALITY ASSURANCE PROGRAM : LEVEL 2

SURVEYED BY : R. GILMAN
SURVEYED DATE : 06-07-2012

DATUM
VERTICAL NAVD88
HORIZONTAL NAD83 (2007)

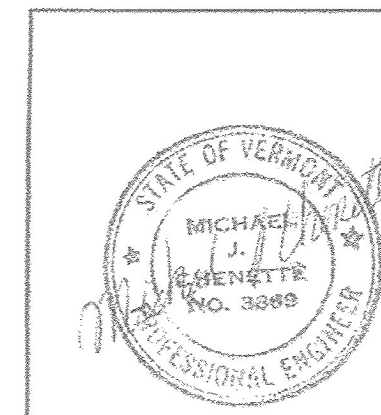

Stantec
Stantec Consulting Services Inc.
55 Green Mountain Drive
South Burlington VT U.S.A. 05403
Phone: (802) 864-0223
Fax: (802) 864-0165
www.stantec.com

DIRECTOR OF PROJECT DELIVERY
APPROVED: DATE 8/4/2016
PROJECT MANAGER : WENDY PELLETIER, P. E.
PROJECT NAME : JAY
PROJECT NUMBER : BHF 0278 (3)
SHEET 1 OF 72 SHEETS