



# QUANTITY SHEET 2

SUMMARY OF ESTIMATED QUANTITIES						TOTALS		DESCRIPTIONS				DETAILED SUMMARY OF QUANTITIES					
				ROADWAY	EROSION CONTROL	UTILITIES (NO FEDERAL PARTICIPATIO	BRIDGE NO. 10	FULL C.E. ITEMS	GRAND TOTAL	FINAL	UNIT	ITEMS	ITEM NUMBER	ROUND	QUANTITIES	UNIT	ITEMS
												BEGIN OPTION AA					
							1		1		LS	PRECAST CONCRETE STRUCTURE (APP SLAB 1)	540.10				
							1		1		LS	SPECIAL PROVISION (CONTRACTOR-FABRICATED PRECAST CONCRETE STRUCTURE)(APP SLAB 1)	900.645				
												END OPTION AA					
							60		60		CY	CONCRETE, CLASS C	541.30				
							500		500		CY	STONE FILL, TYPE IV	613.13				
				1					1		EACH	RELOCATE MAILBOX, SINGLE SUPPORT	617.10				
				100					100		LF	BOX BEAM GUARDRAIL	621.30				
				2					2		EACH	MANUFACTURED TERMINAL SECTION, TANGENT	621.51				
				4					4		EACH	GUARDRAIL APPROACH SECTION, GALVANIZED 3 RAIL BOX BEAM	621.725				
				250					250		LF	REMOVAL AND DISPOSAL OF GUARDRAIL	621.80				
				20					20		HR	UNIFORMED TRAFFIC OFFICERS	630.10				
				1000					1000		HR	FLAGGERS	630.15				
								1	1		LS	FIELD OFFICE, ENGINEERS	631.10				
								1	1		LS	TESTING EQUIPMENT, CONCRETE	631.16				
								1	1		LS	TESTING EQUIPMENT, BITUMINOUS	631.17				
								1	1		DL	FIELD OFFICE TELEPHONE (N.A.B.I.)	631.26				
				520					520		HR	EMPLOYEE TRAINEESHIP	634.10				
				1					1		LS	MOBILIZATION/DEMOBILIZATION	635.11				
				2					2		EACH	PORTABLE CHANGEABLE MESSAGE SIGN	641.15				
				900					900		LF	DURABLE 4 INCH WHITE LINE, THERMOPLASTIC	646.402				
				900					900		LF	DURABLE 4 INCH YELLOW LINE, THERMOPLASTIC	646.412				
							360		360		SY	GEOTEXTILE UNDER STONE FILL	649.31				
					45				45		SY	GEOTEXTILE FOR SILT FENCE	649.51				
					100				100		SY	GEOTEXTILE FOR FILTER CURTAIN 	649.61				
					20				20		LB	SEED	651.15				
					120				120		LB	FERTILIZER	651.18				
					1				1		TON	AGRICULTURAL LIMESTONE	651.20				
					1				1		TON	HAY MULCH	651.25				
					65				65		CY	TOPSOIL	651.35				
					360				360		SY	GRUBBING MATERIAL	651.40				
					1				1		LS	EPSC PLAN	652.10				
					20				20		HR	MONITORING EPSC PLAN	652.20				
					1				1		LU	MAINTENANCE OF EPSC PLAN (N.A.B.I.)	652.30				
					360				360		SY	TEMPORARY EROSION MATTING	653.20				
					2				2		CY	TEMPORARY STONE CHECK DAM, TYPE I	653.25				
					40				40		CY	VEHICLE TRACKING PAD	653.35				
					2				2		EACH	FILTER BAG	653.45				
					310				310		LF	BARRIER FENCE	653.50				
					320				320		LF	PROJECT DEMARCATION FENCE	653.55				

REVISIONS		
	09.27.16	QUANTITY ITEM ADDED

PROJECT NAME:	JAY	PLOT DATE:	9/26/2016
PROJECT NUMBER:	BHF 0278(3)	DRAWN BY:	I. MAYNARD
FILE NAME:	z12ci54frm.dgn	CHECKED BY:	G. SANTY
DESIGNED BY:	I. MAYNARD	QUANTITY SHEET 2 OF 3	SHEET 7 OF 72

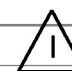