


VT RT 242 PROFILE

SCALE: HORIZONTAL 1" = 20' - 0"
 VERTICAL 1" = 10' - 0"

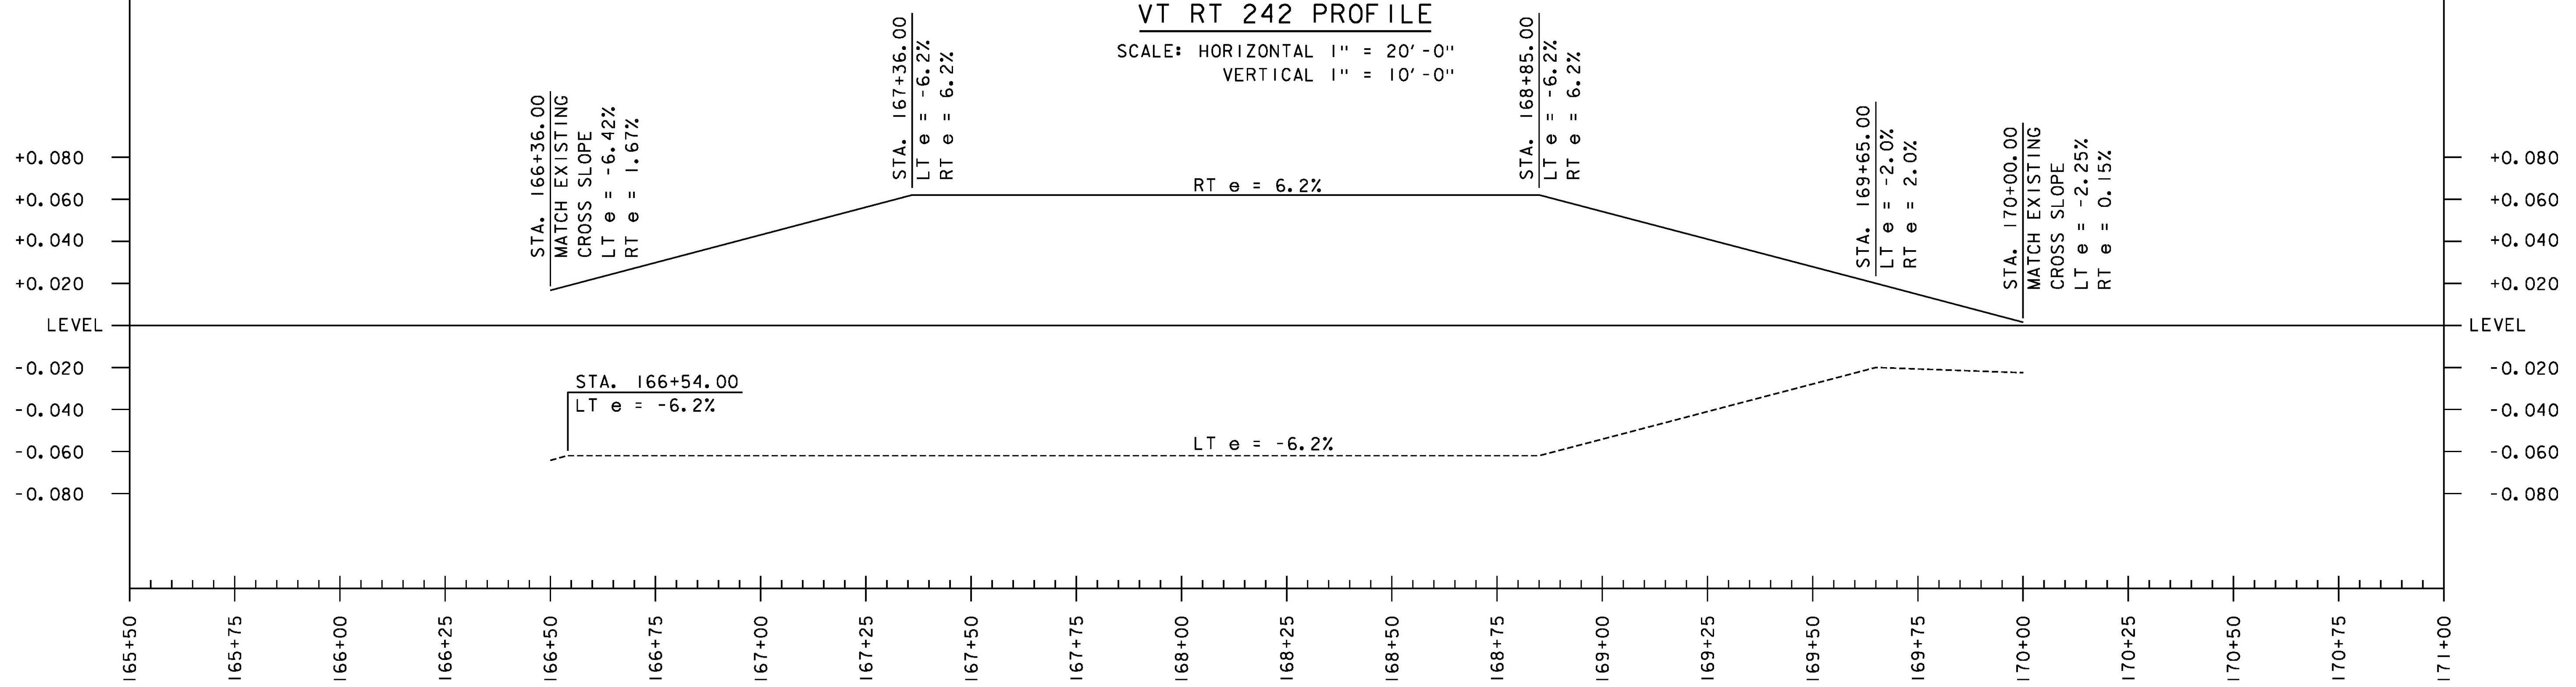

NOTE:
 GRADES SHOWN TO THE NEAREST TENTH ARE EXISTING GROUND ALONG C
 GRADES SHOWN TO THE NEAREST HUNDREDTH ARE FINISH GRADE ALONG C

VT RT 242 BANKING DIAGRAM

SCALE: HORIZONTAL 1" = 20' - 0"
 VERTICAL 1" = 4% SLOPE



PROJECT NAME:	JAY
PROJECT NUMBER:	BHF 0278(3)
FILE NAME:	z12ci54profile.dgn
PROJECT LEADER:	M. CHENETTE
DESIGNED BY:	I. MAYNARD
PROFILE & BANKING DIAGRAM SHEET	
PLOT DATE:	8/16/2016
DRAWN BY:	I. MAYNARD
CHECKED BY:	M. CHENETTE
SHEET	13 OF 72