


PLAN
SCALE: 1" = 10'-0"
0 10 20

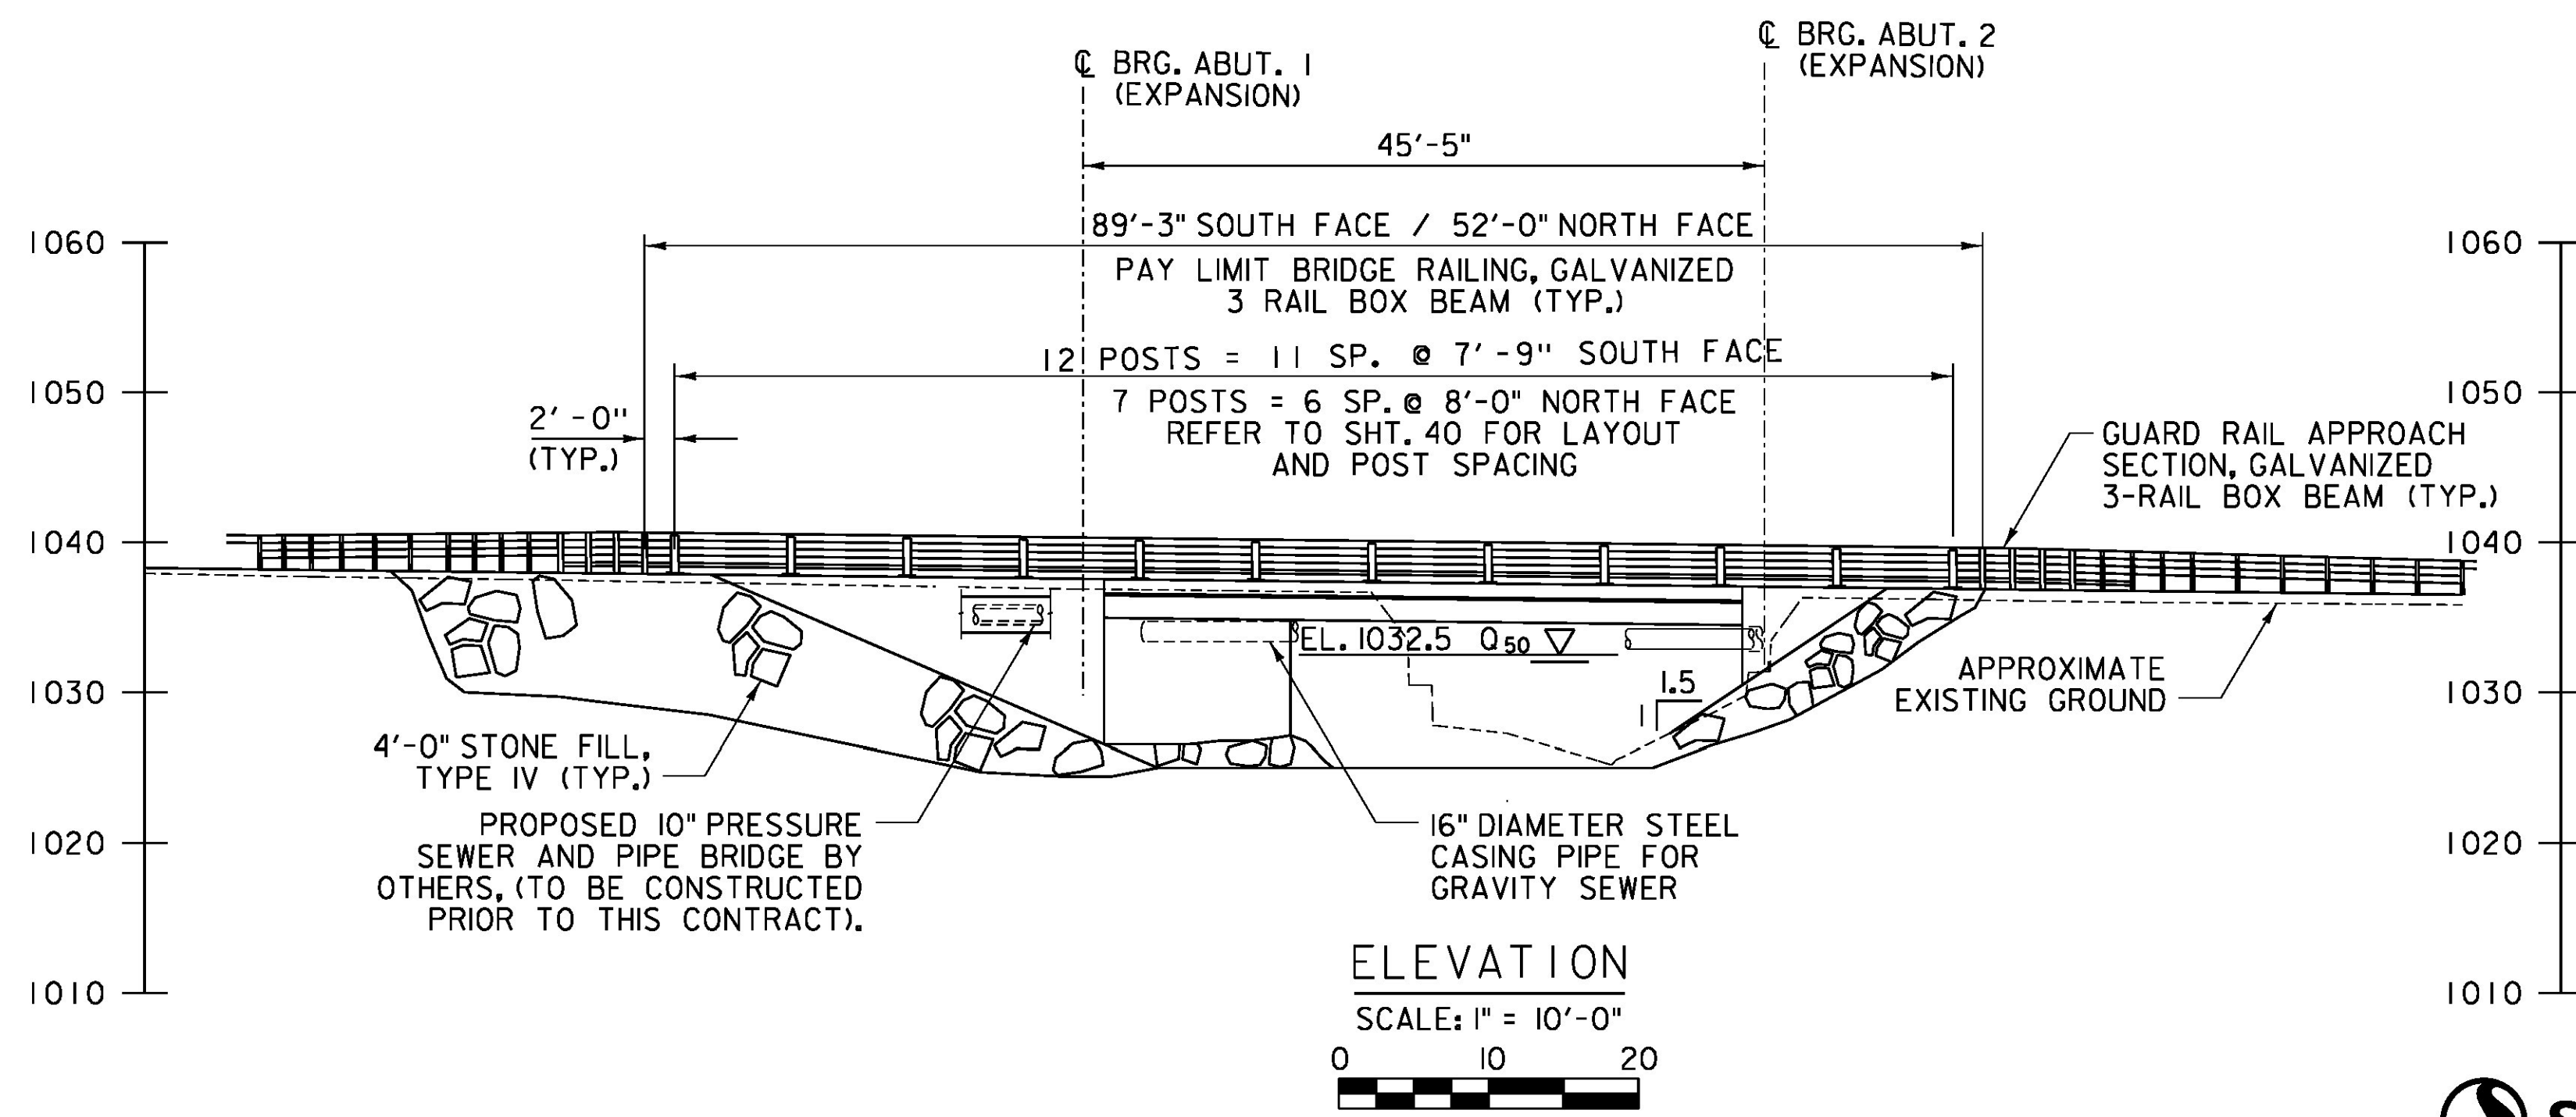

ELEVATION
SCALE: 1" = 10'-0"
0 10 20

PROJECT NAME:	JAY	PLOT DATE:	8/16/2016
PROJECT NUMBER:	BHF 0278(3)	DRAWN BY:	L. BUXTON
FILE NAME:	z12ci54bdr_pe.dgn	DESIGNED BY:	J. HUNGERFORD
PROJECT LEADER:	M. CHENETTE	CHECKED BY:	T. KNIGHT
PLAN AND ELEVATION		SHEET 22 OF 72	

