




166+25

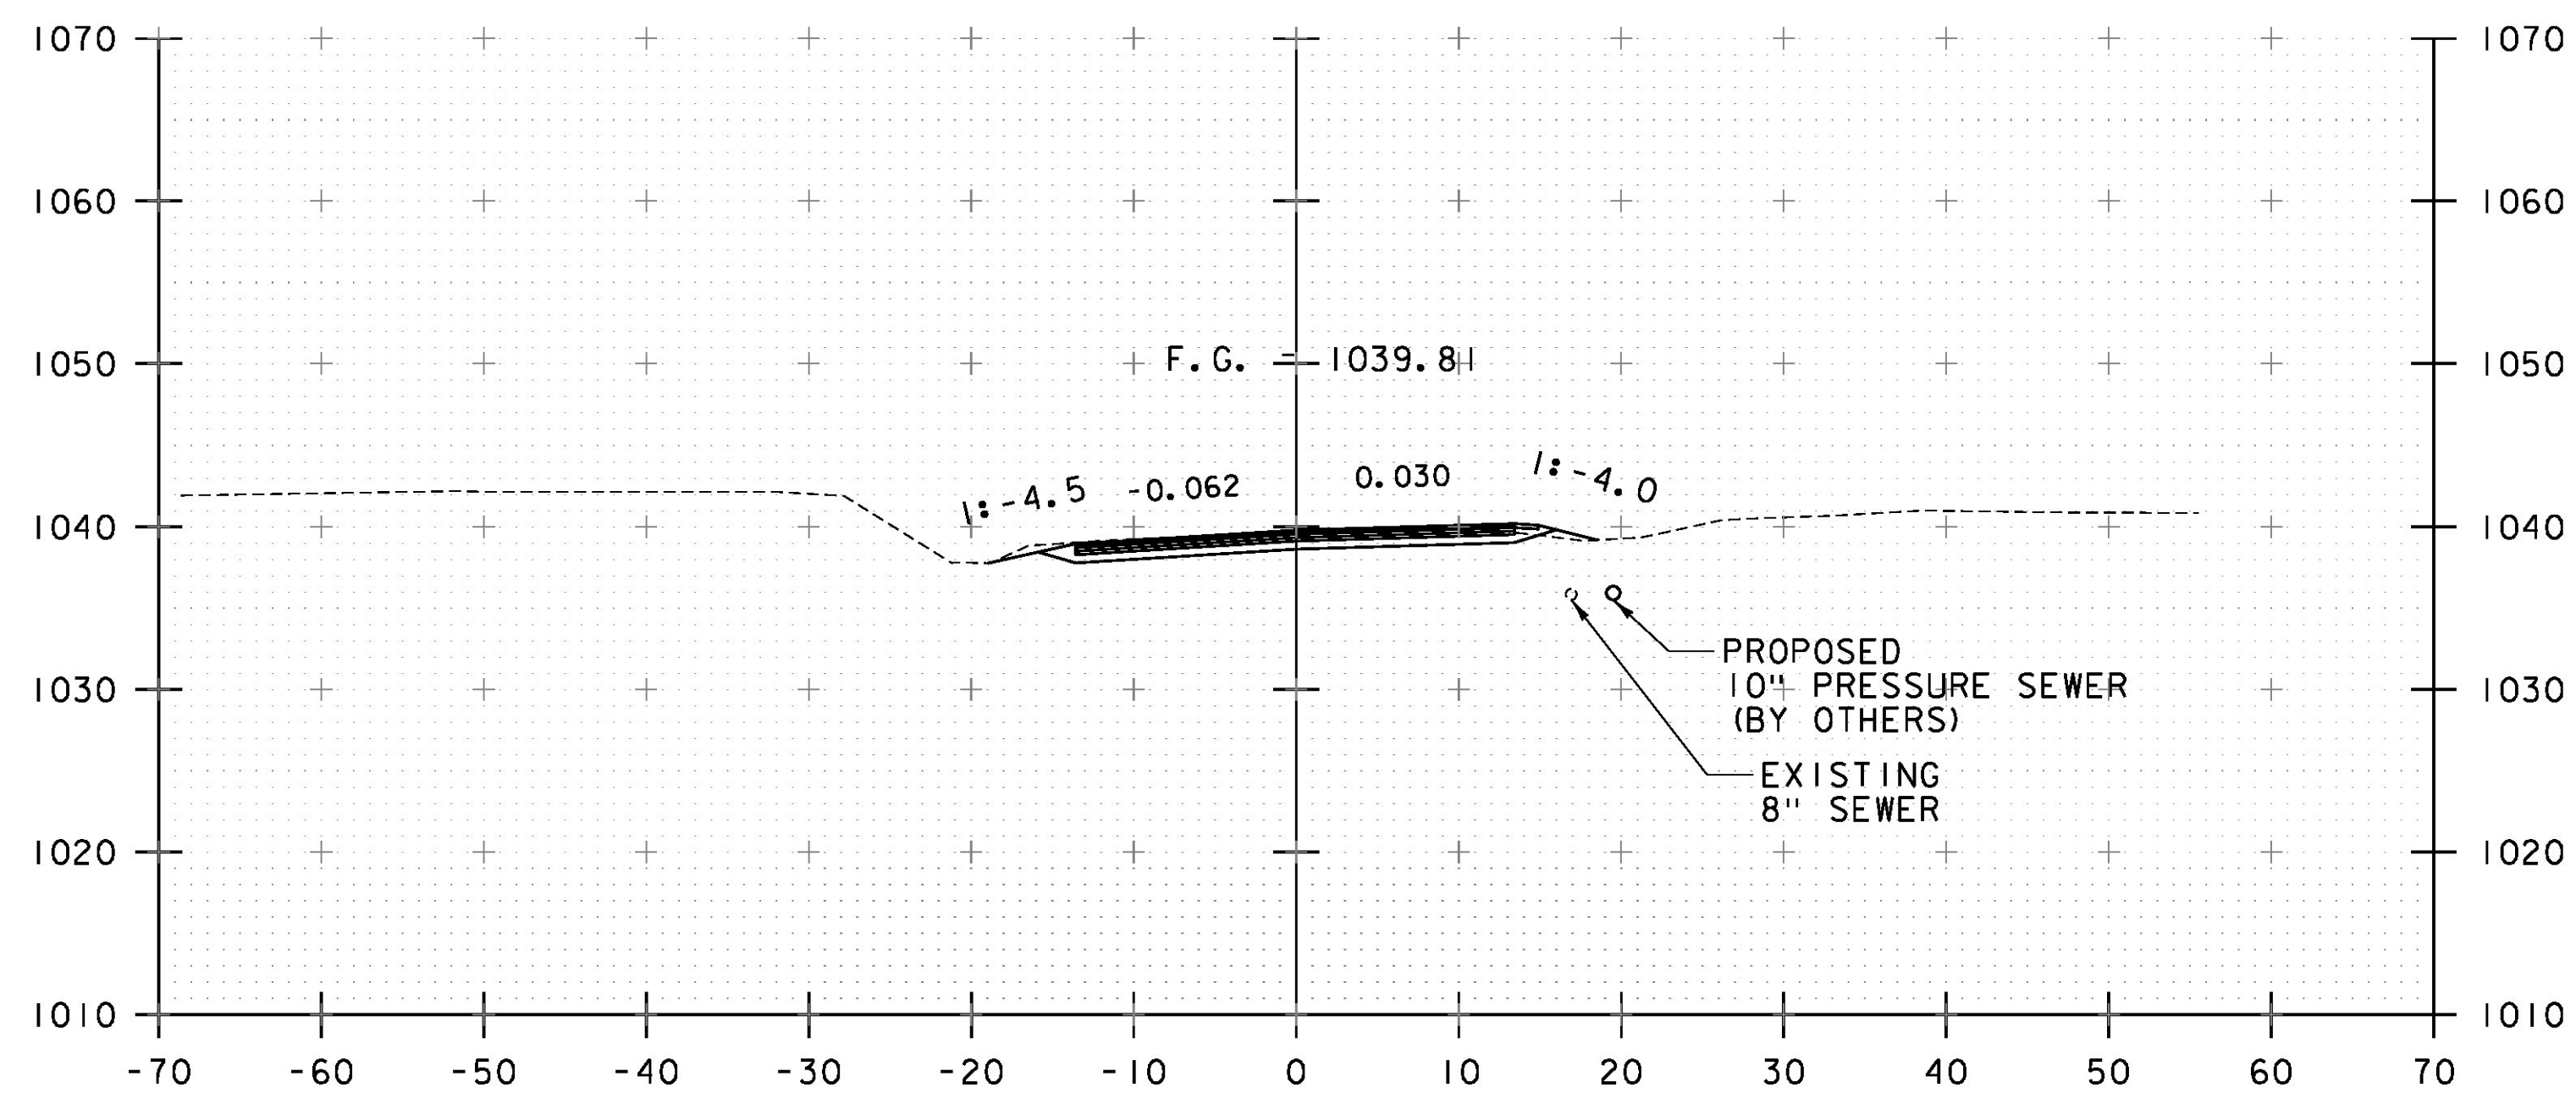

166+75

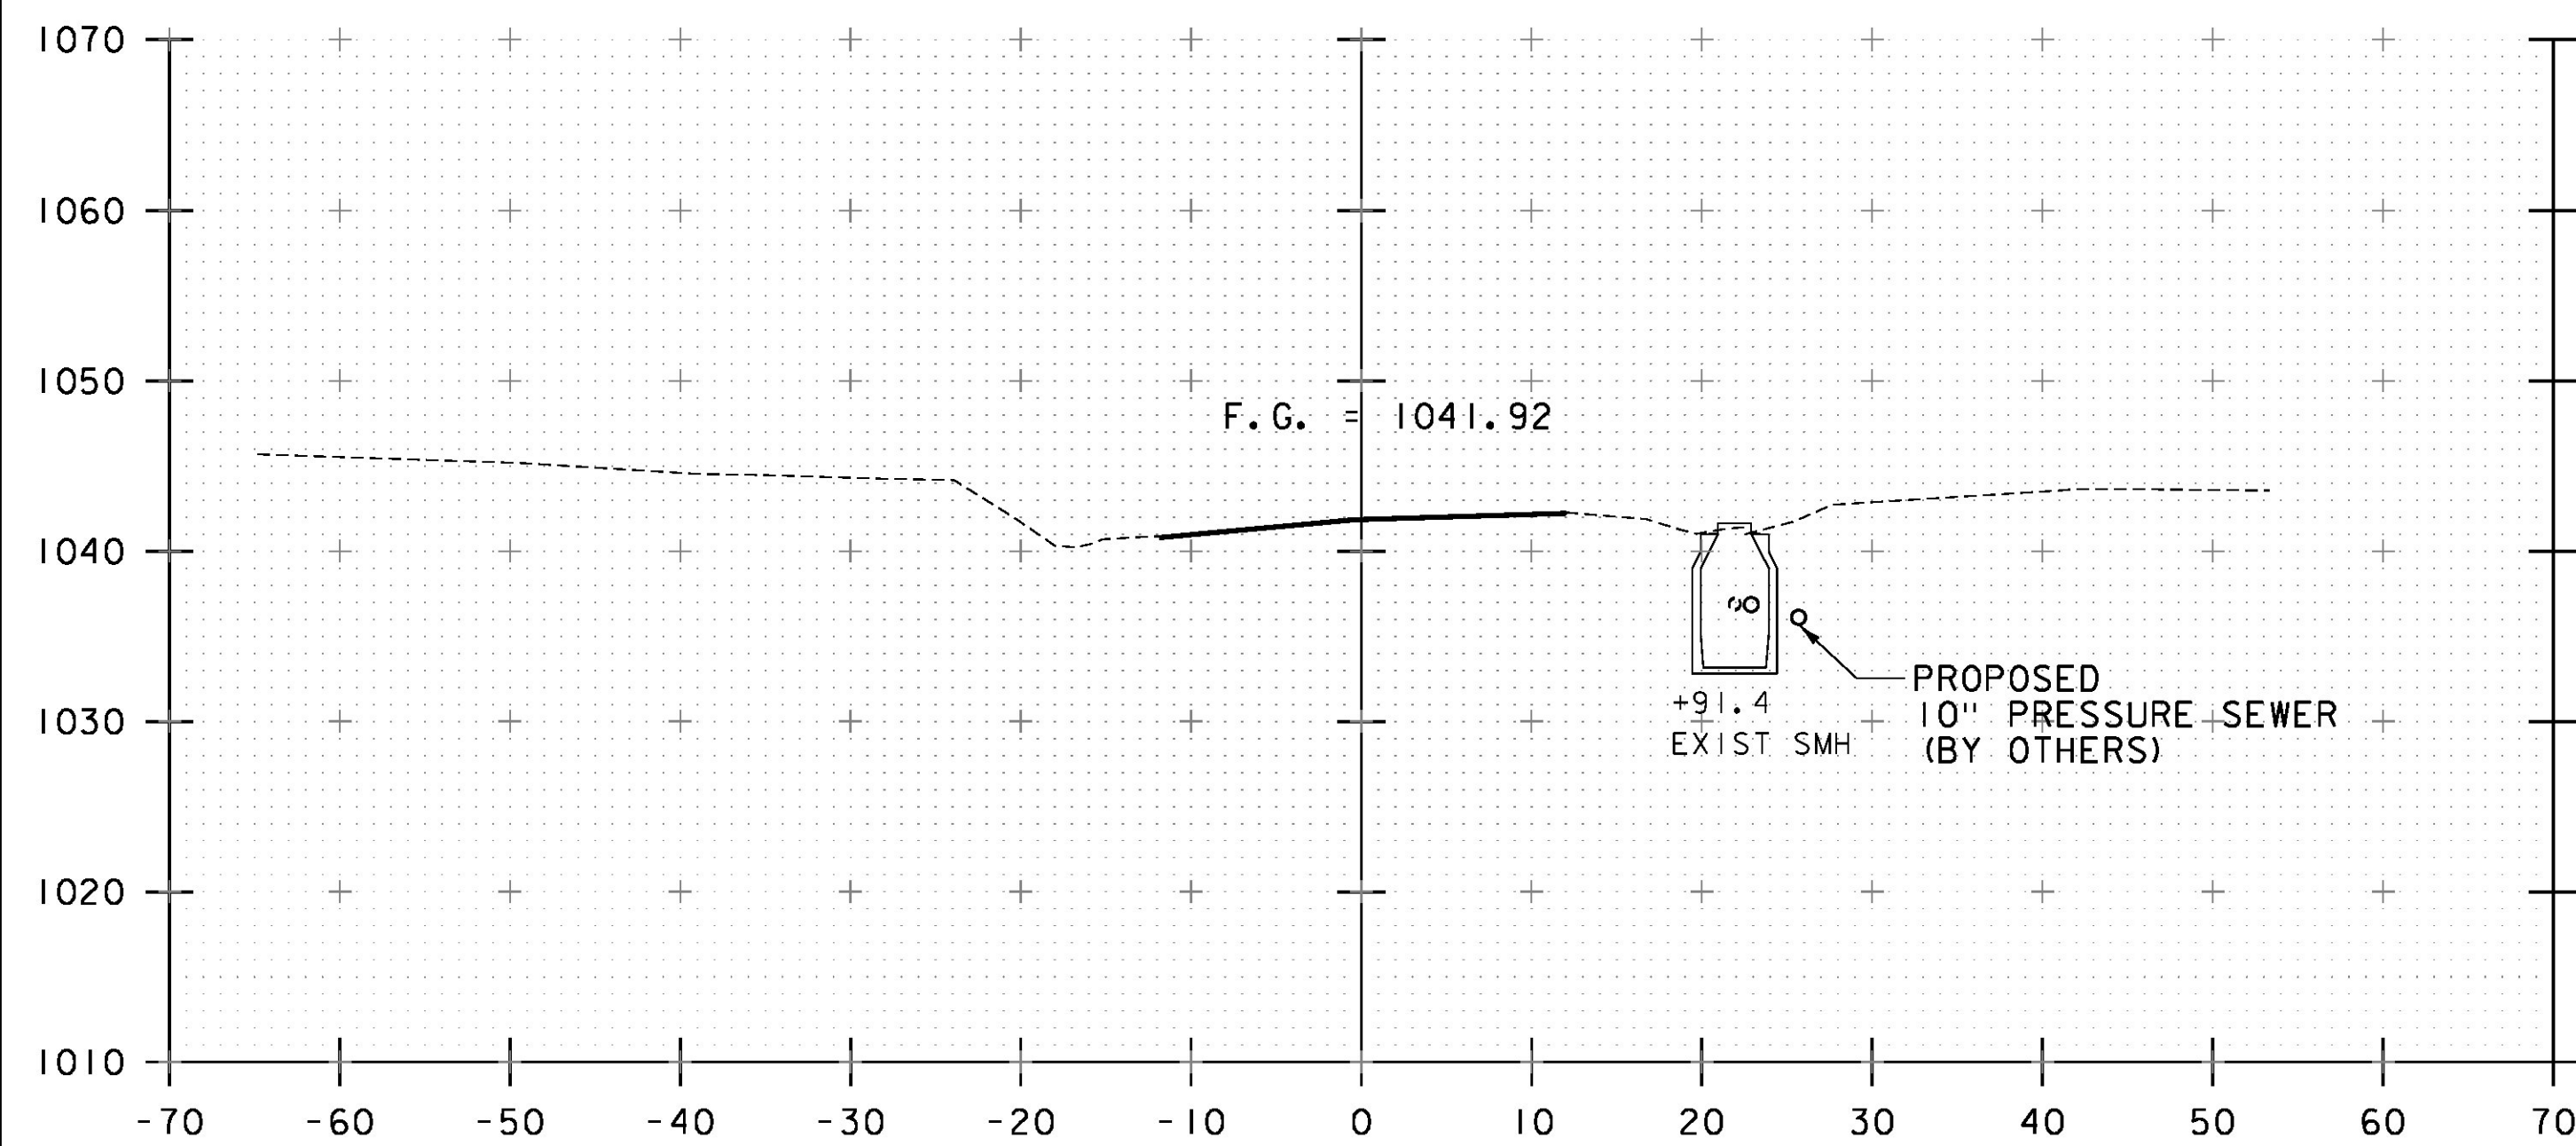

166+00
BEGIN APPROACH

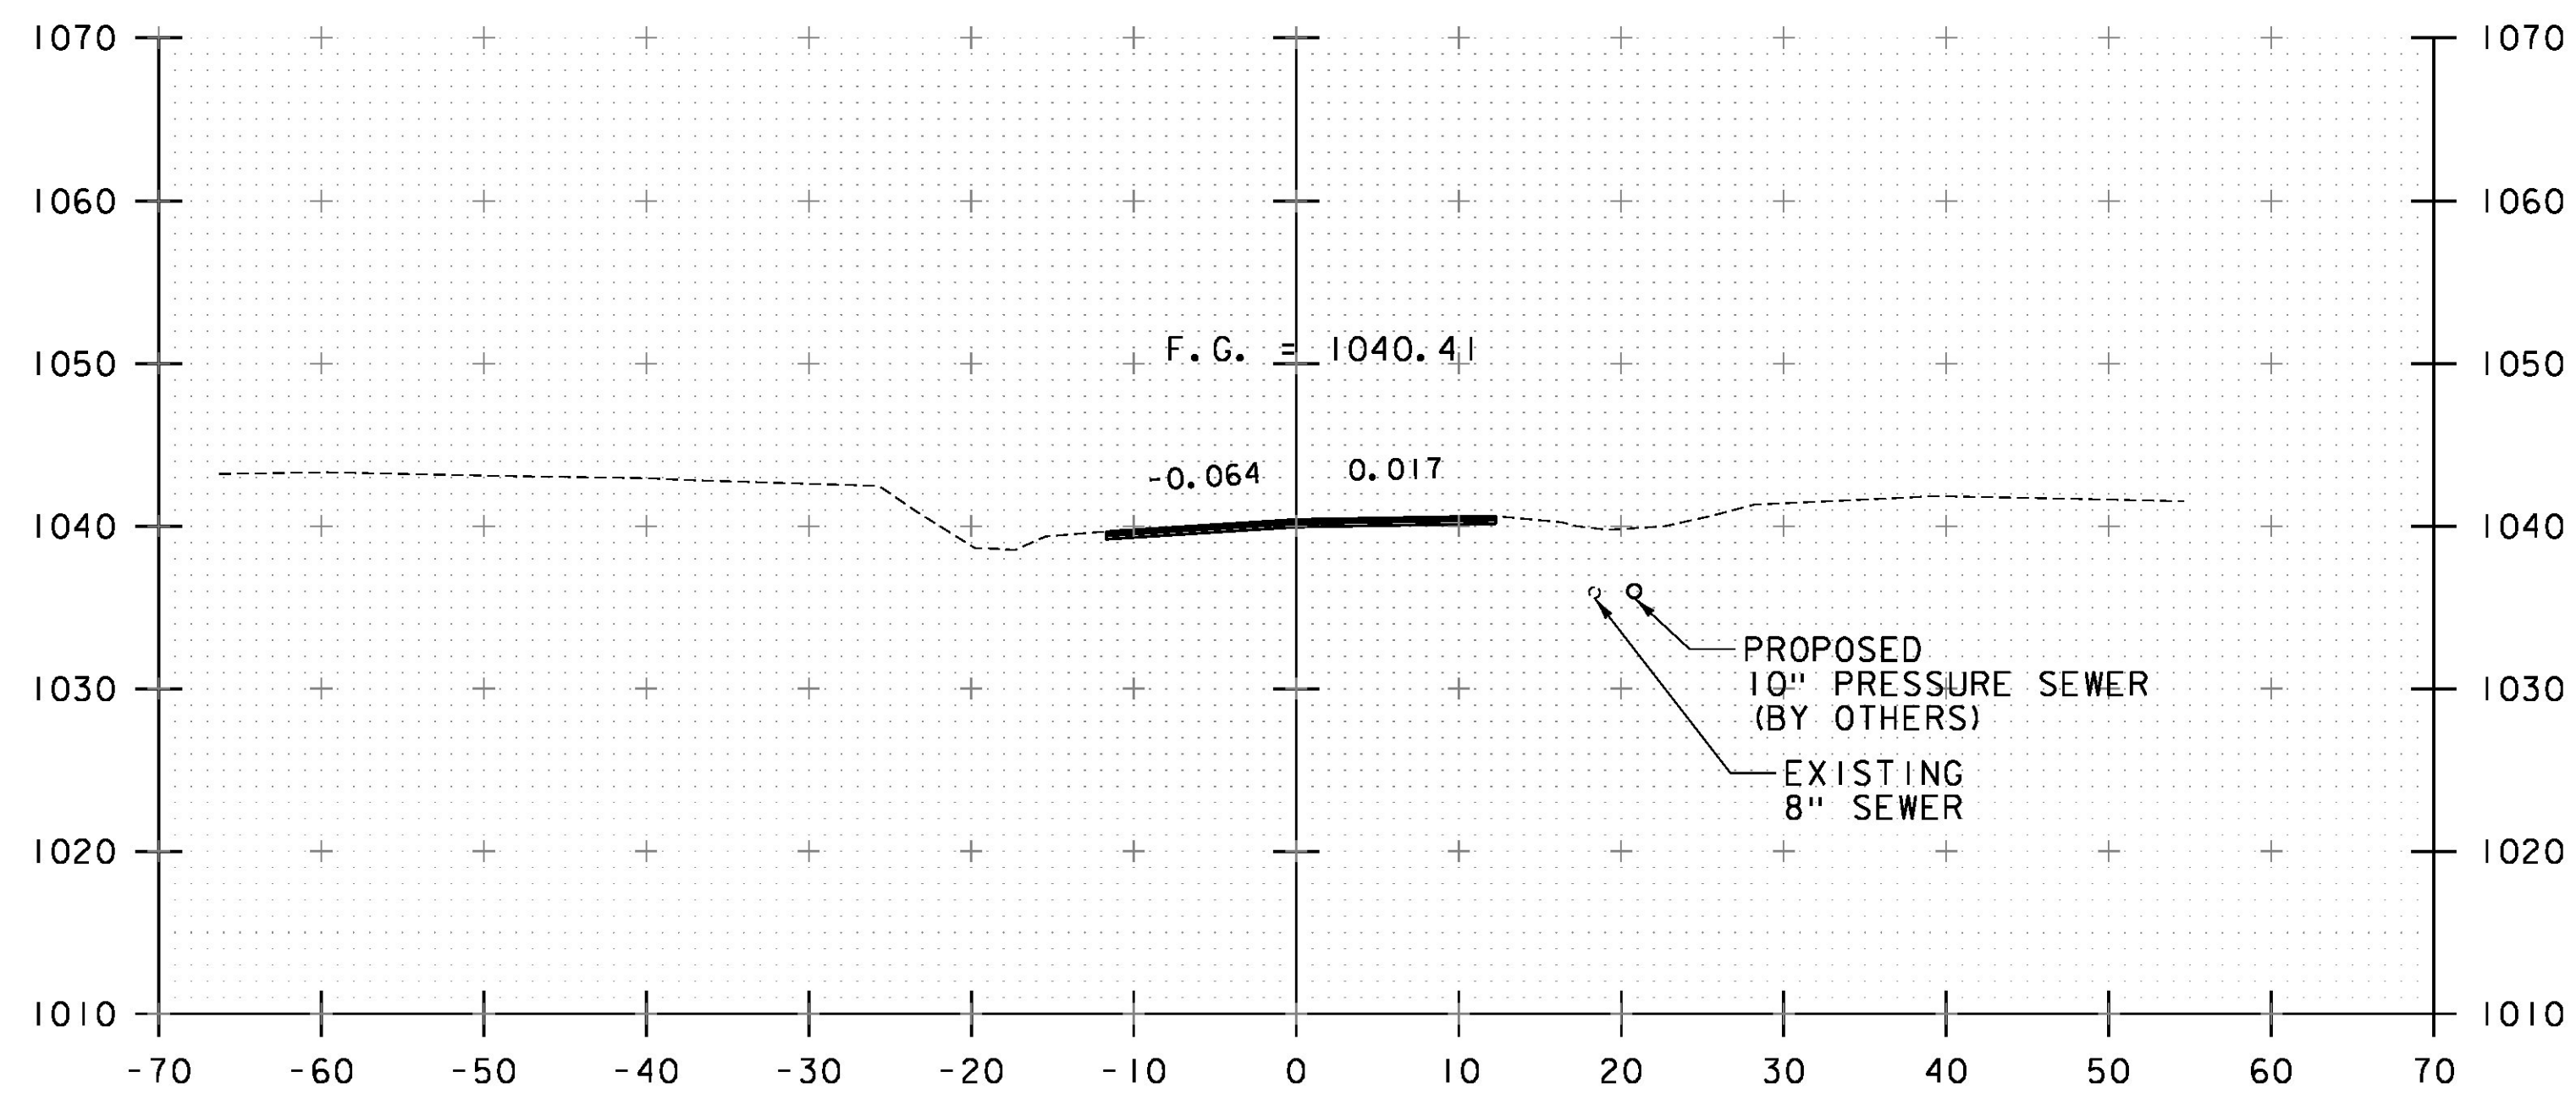

166+50

STA. 166+00 TO STA. 166+75

PROJECT NAME:	JAY	PLOT DATE:	8/16/2016
PROJECT NUMBER:	BHF 0278(3)	DRAWN BY:	I. MAYNARD
FILE NAME:	z12ci54xsl.dgn	CHECKED BY:	G. SANTY
PROJECT LEADER:	M. CHENETTE	ROADWAY CROSS SECTIONS - RXS 1	SHEET 43 OF 72
DESIGNED BY:	I. MAYNARD		

