




169+25

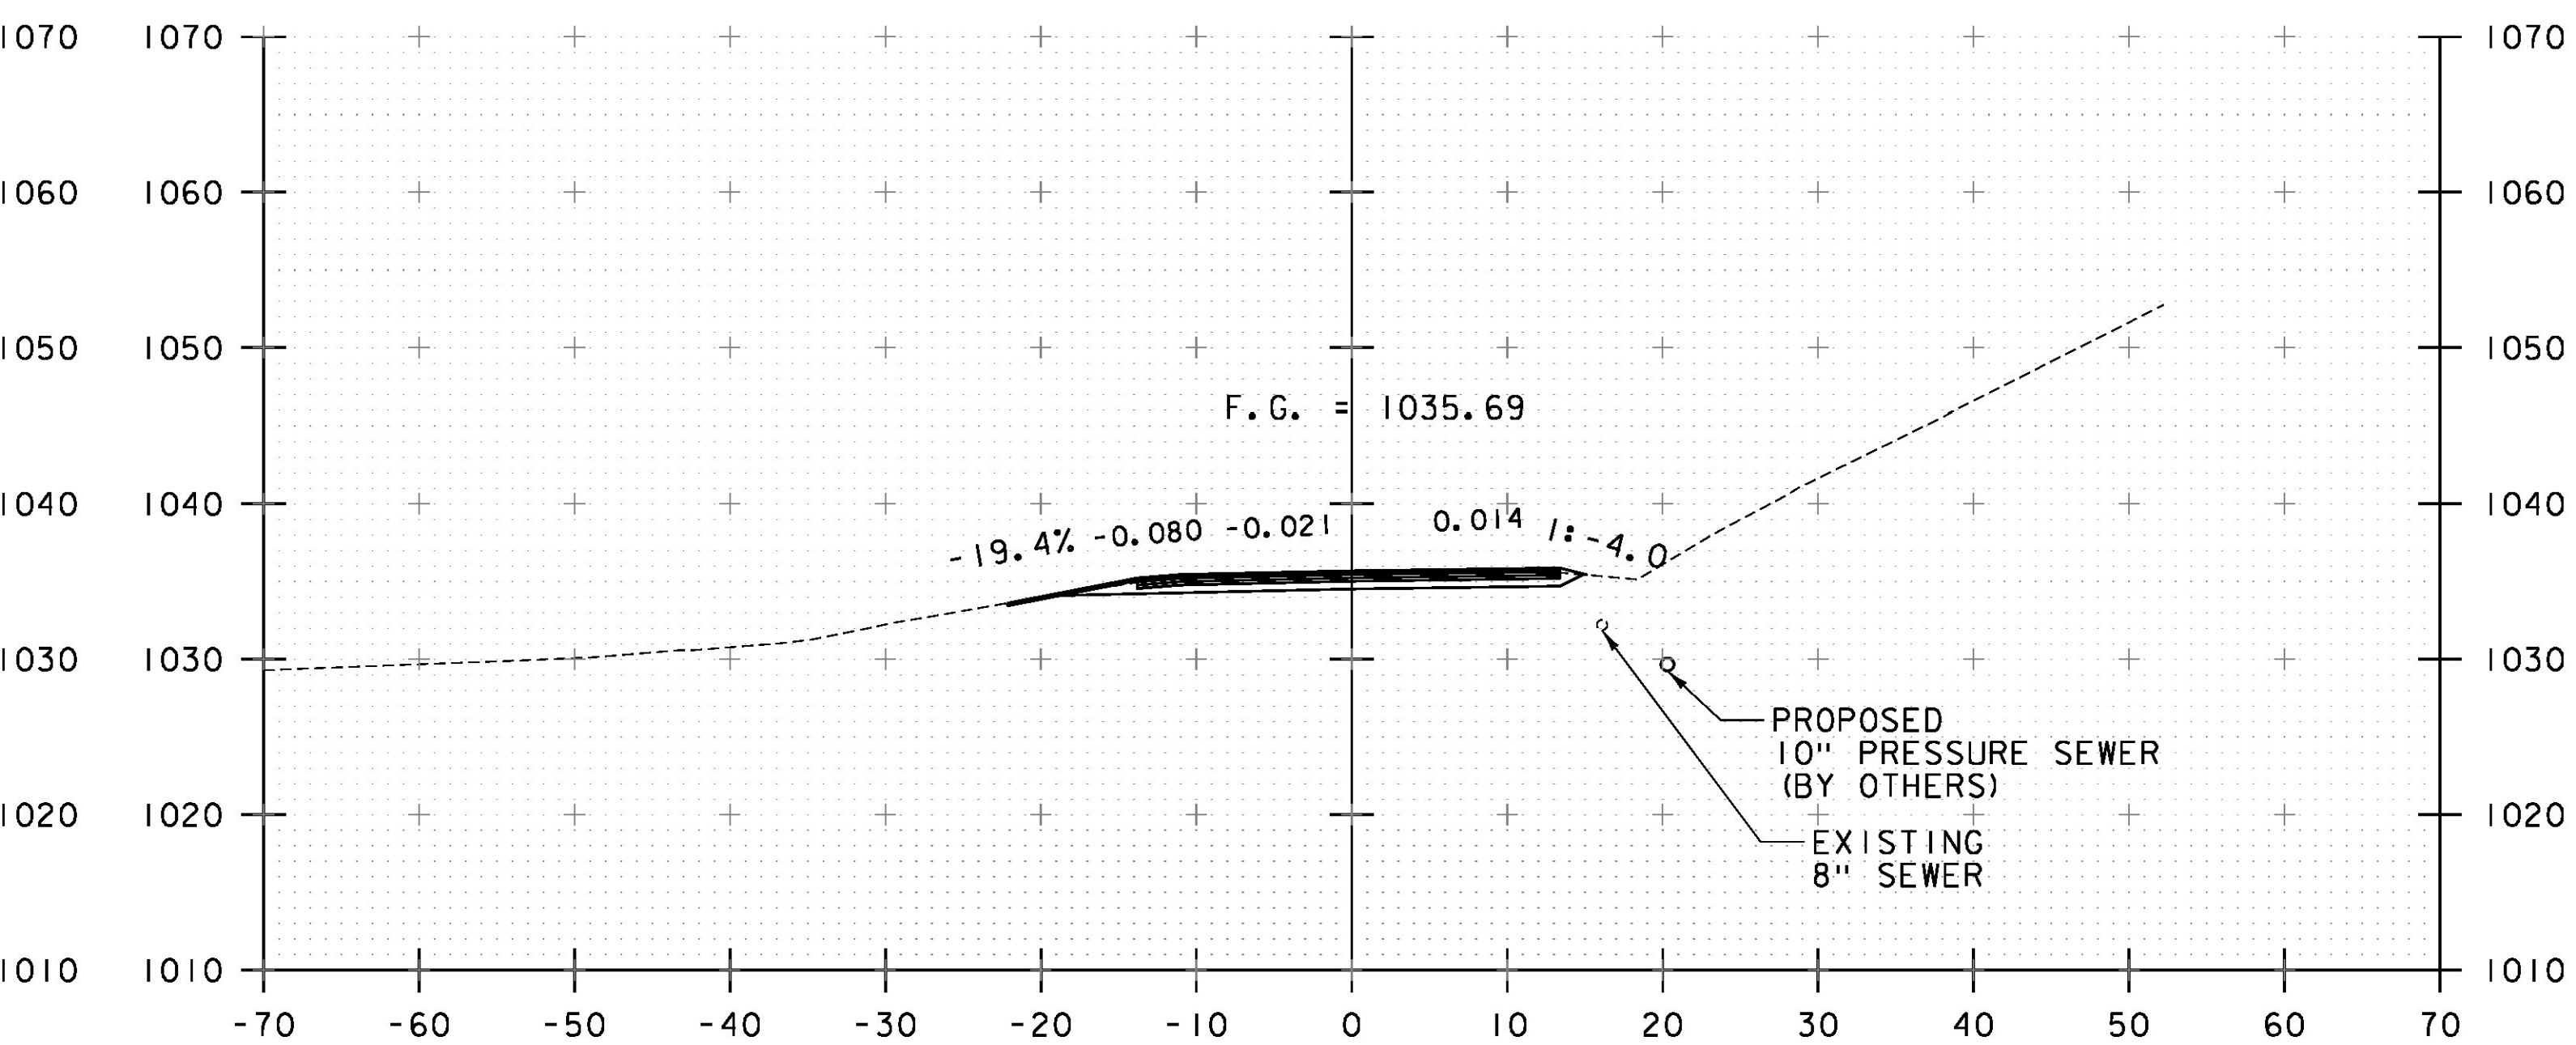

169+75

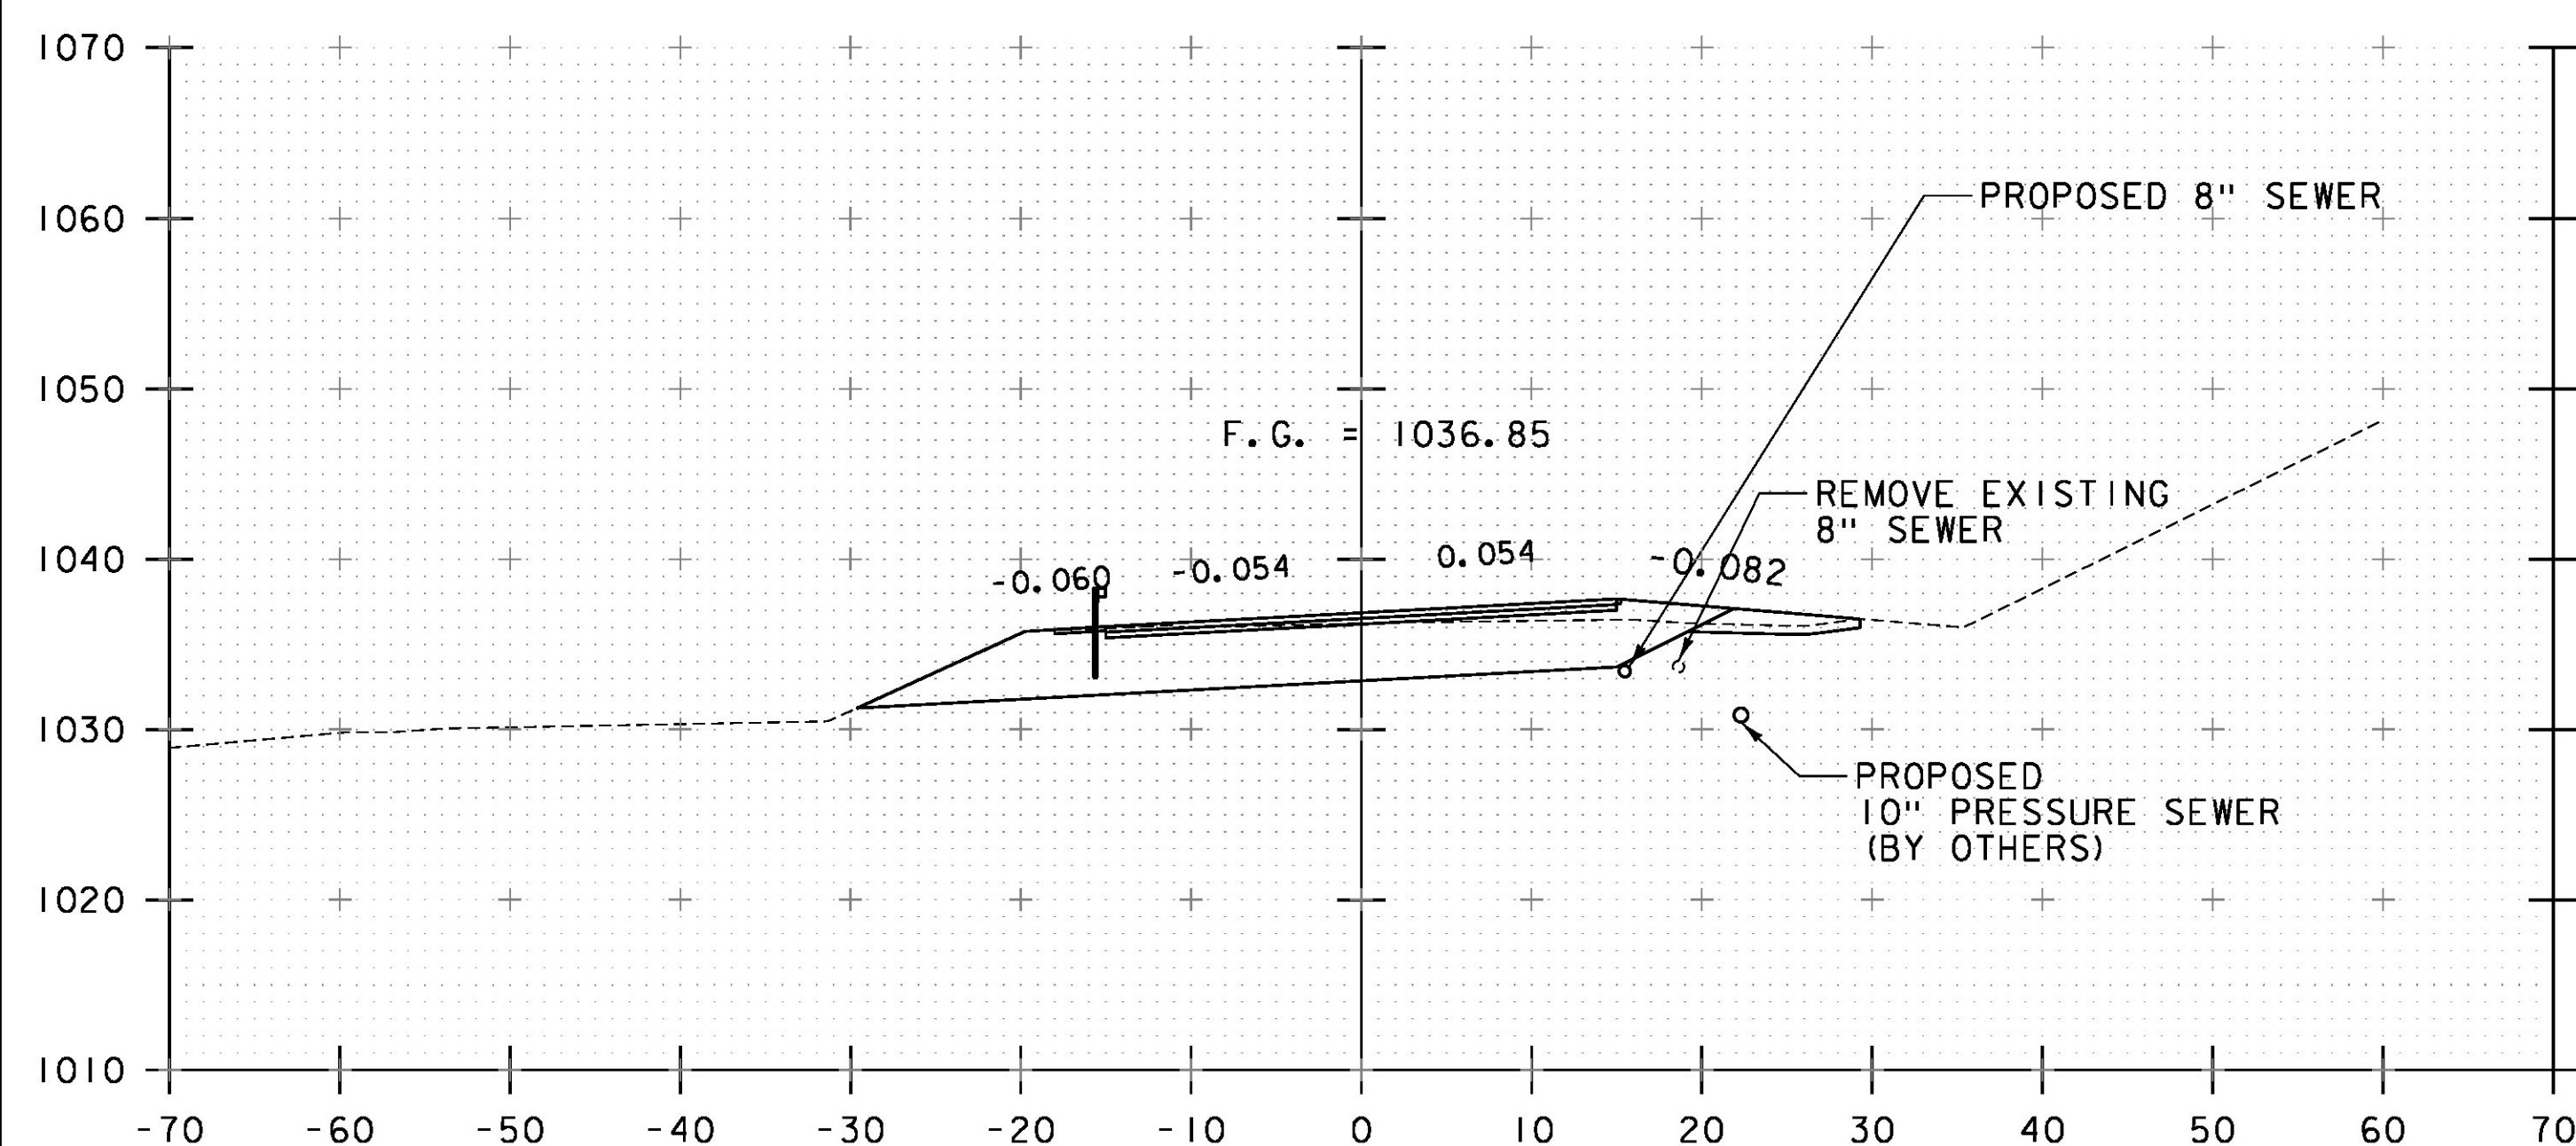

169+00  
169+04.17  
END PROJECT

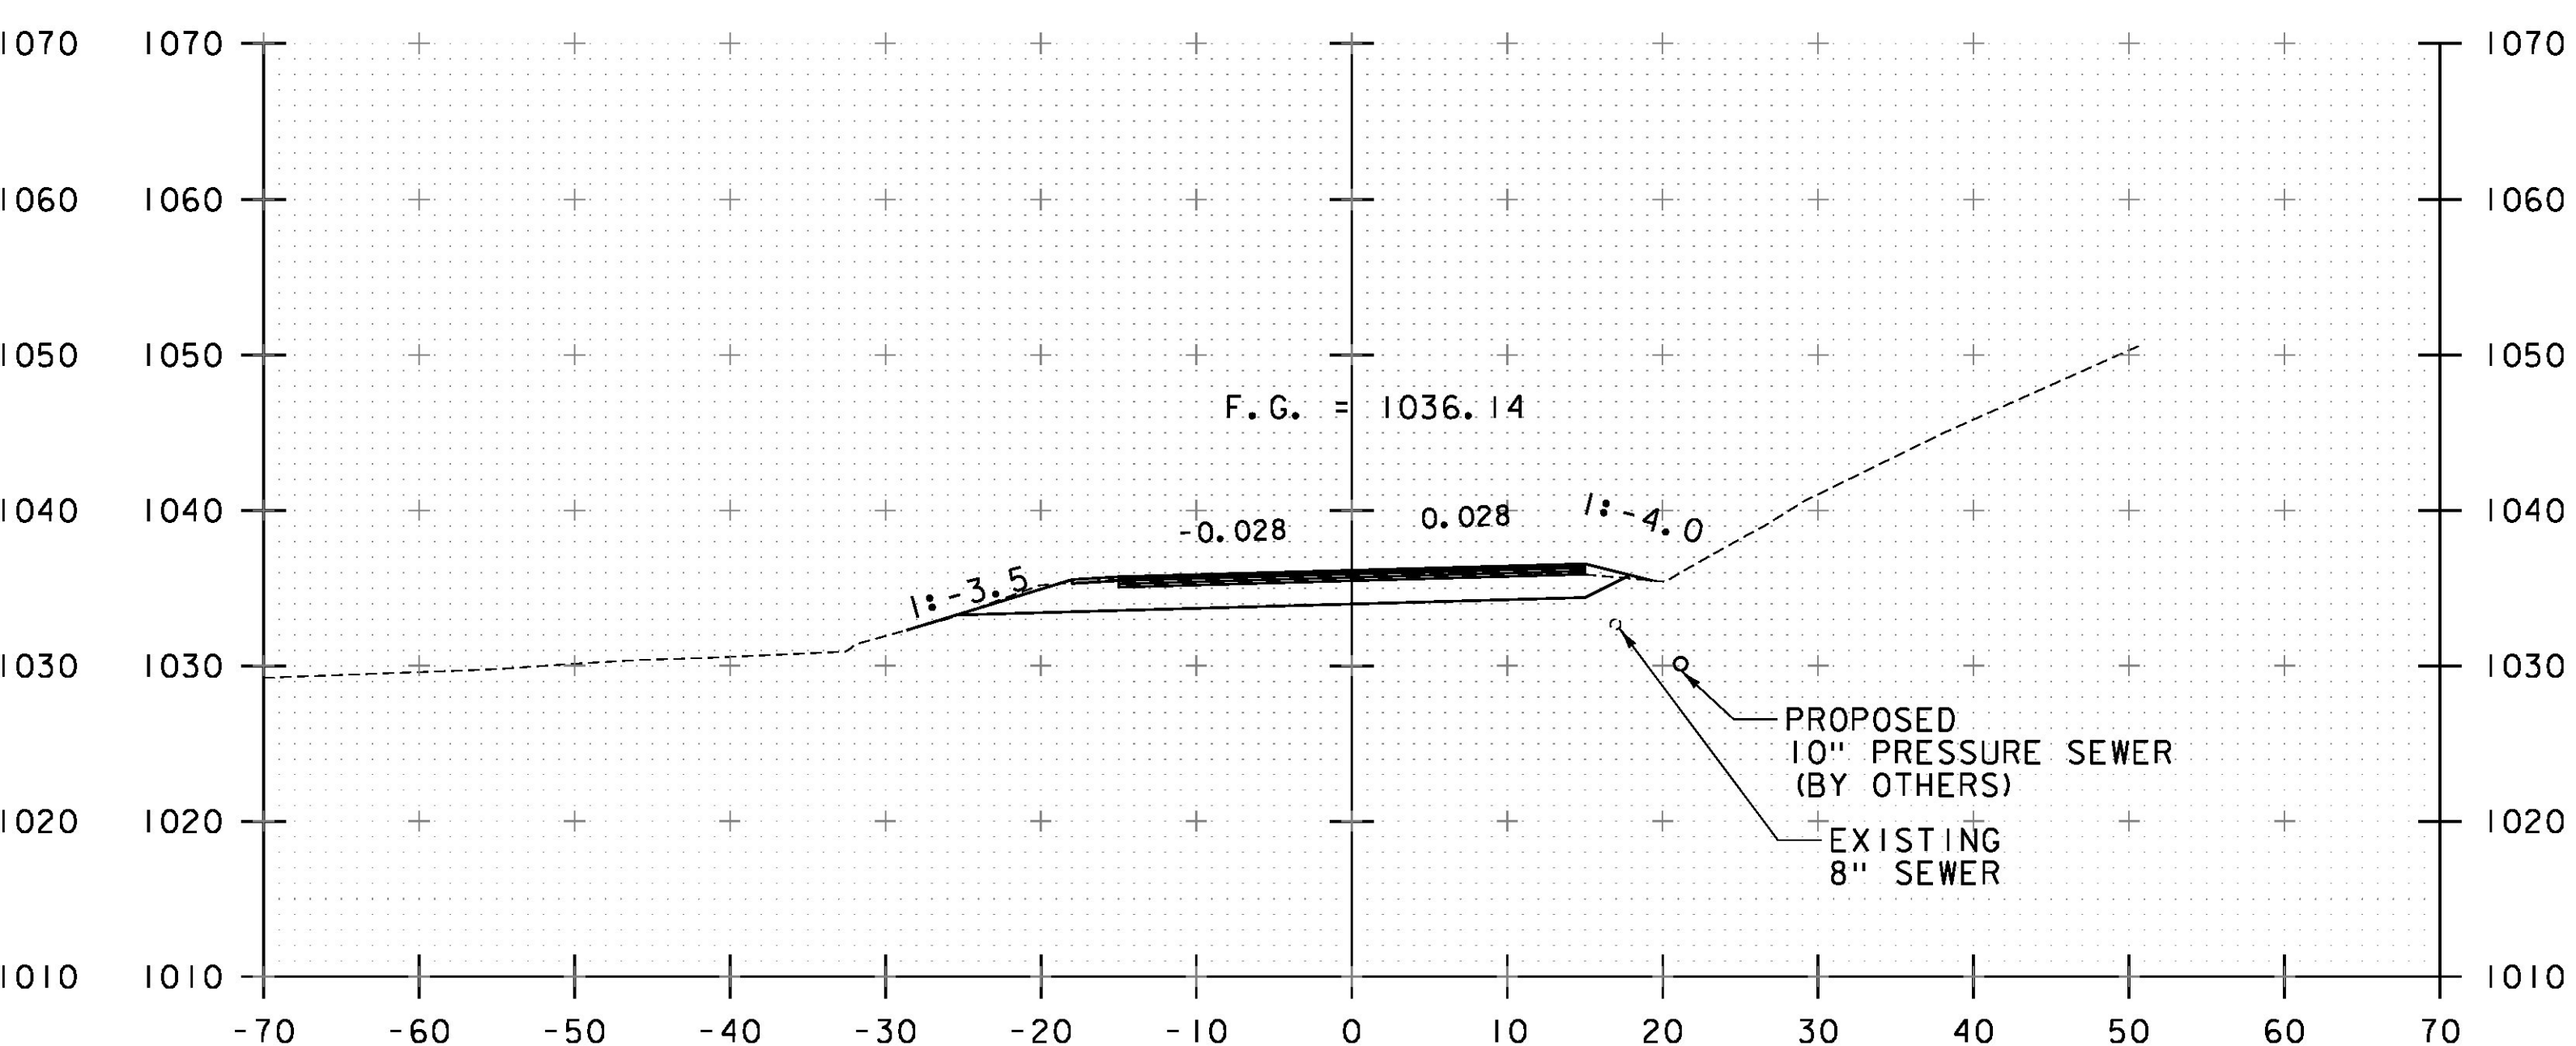

169+50

STA. 169+00 TO STA. 169+75

PROJECT NAME:	JAY	PLOT DATE:	8/16/2016
PROJECT NUMBER:	BHF 0278(3)	DRAWN BY:	I. MAYNARD
FILE NAME:	z12ci54xsl.dgn	CHECKED BY:	G. SANTY
PROJECT LEADER:	M. CHENETTE	ROADWAY CROSS SECTIONS - RXS 4	SHEET 46 OF 72

