



170+25

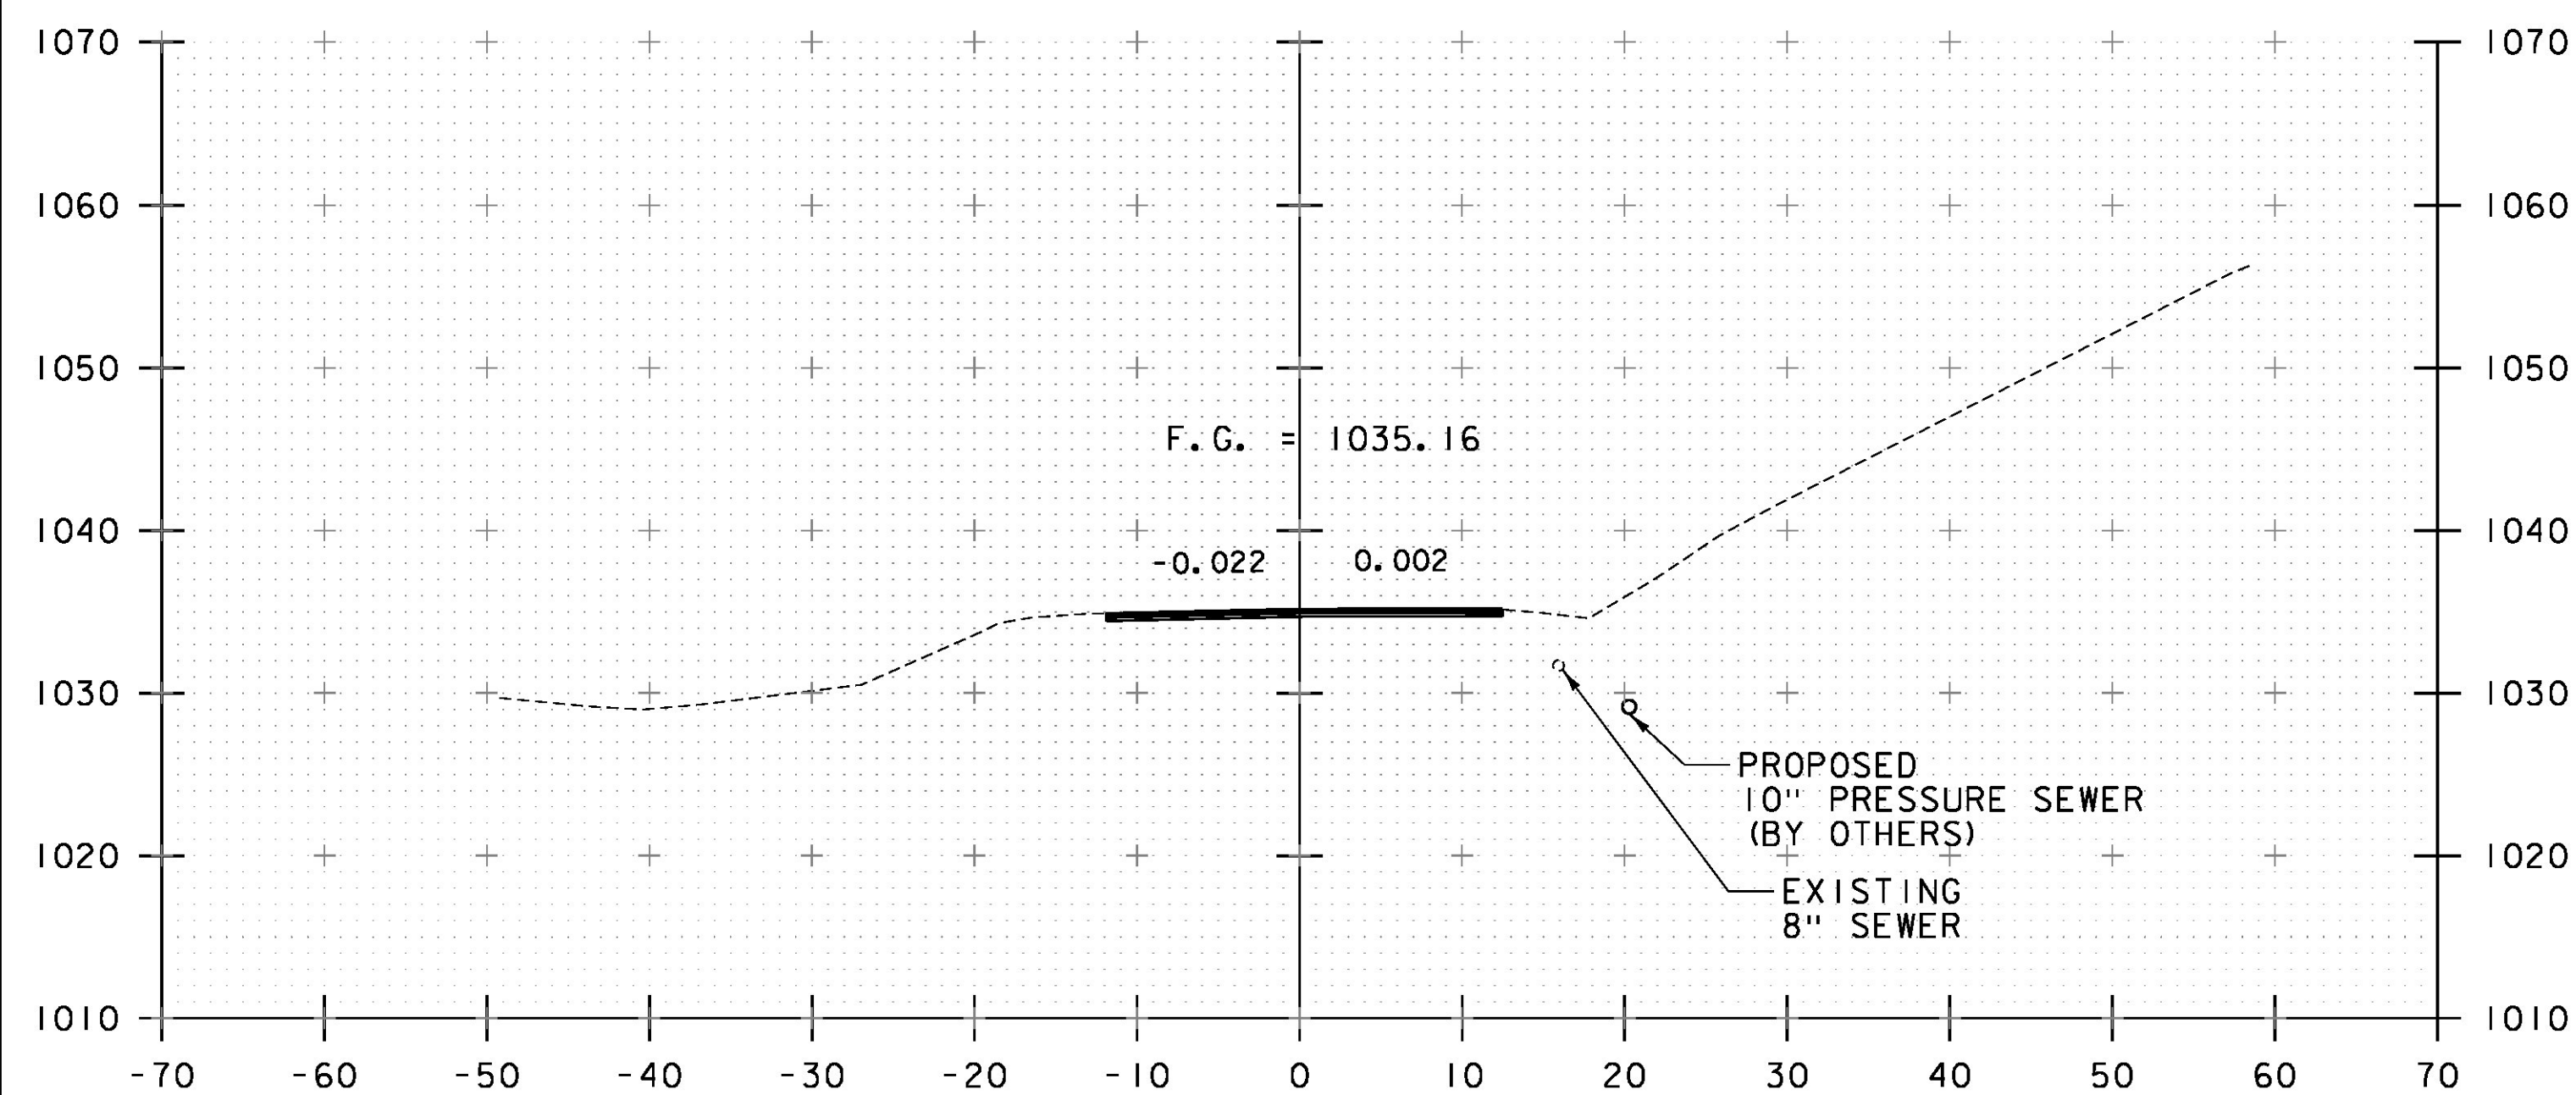

170+00

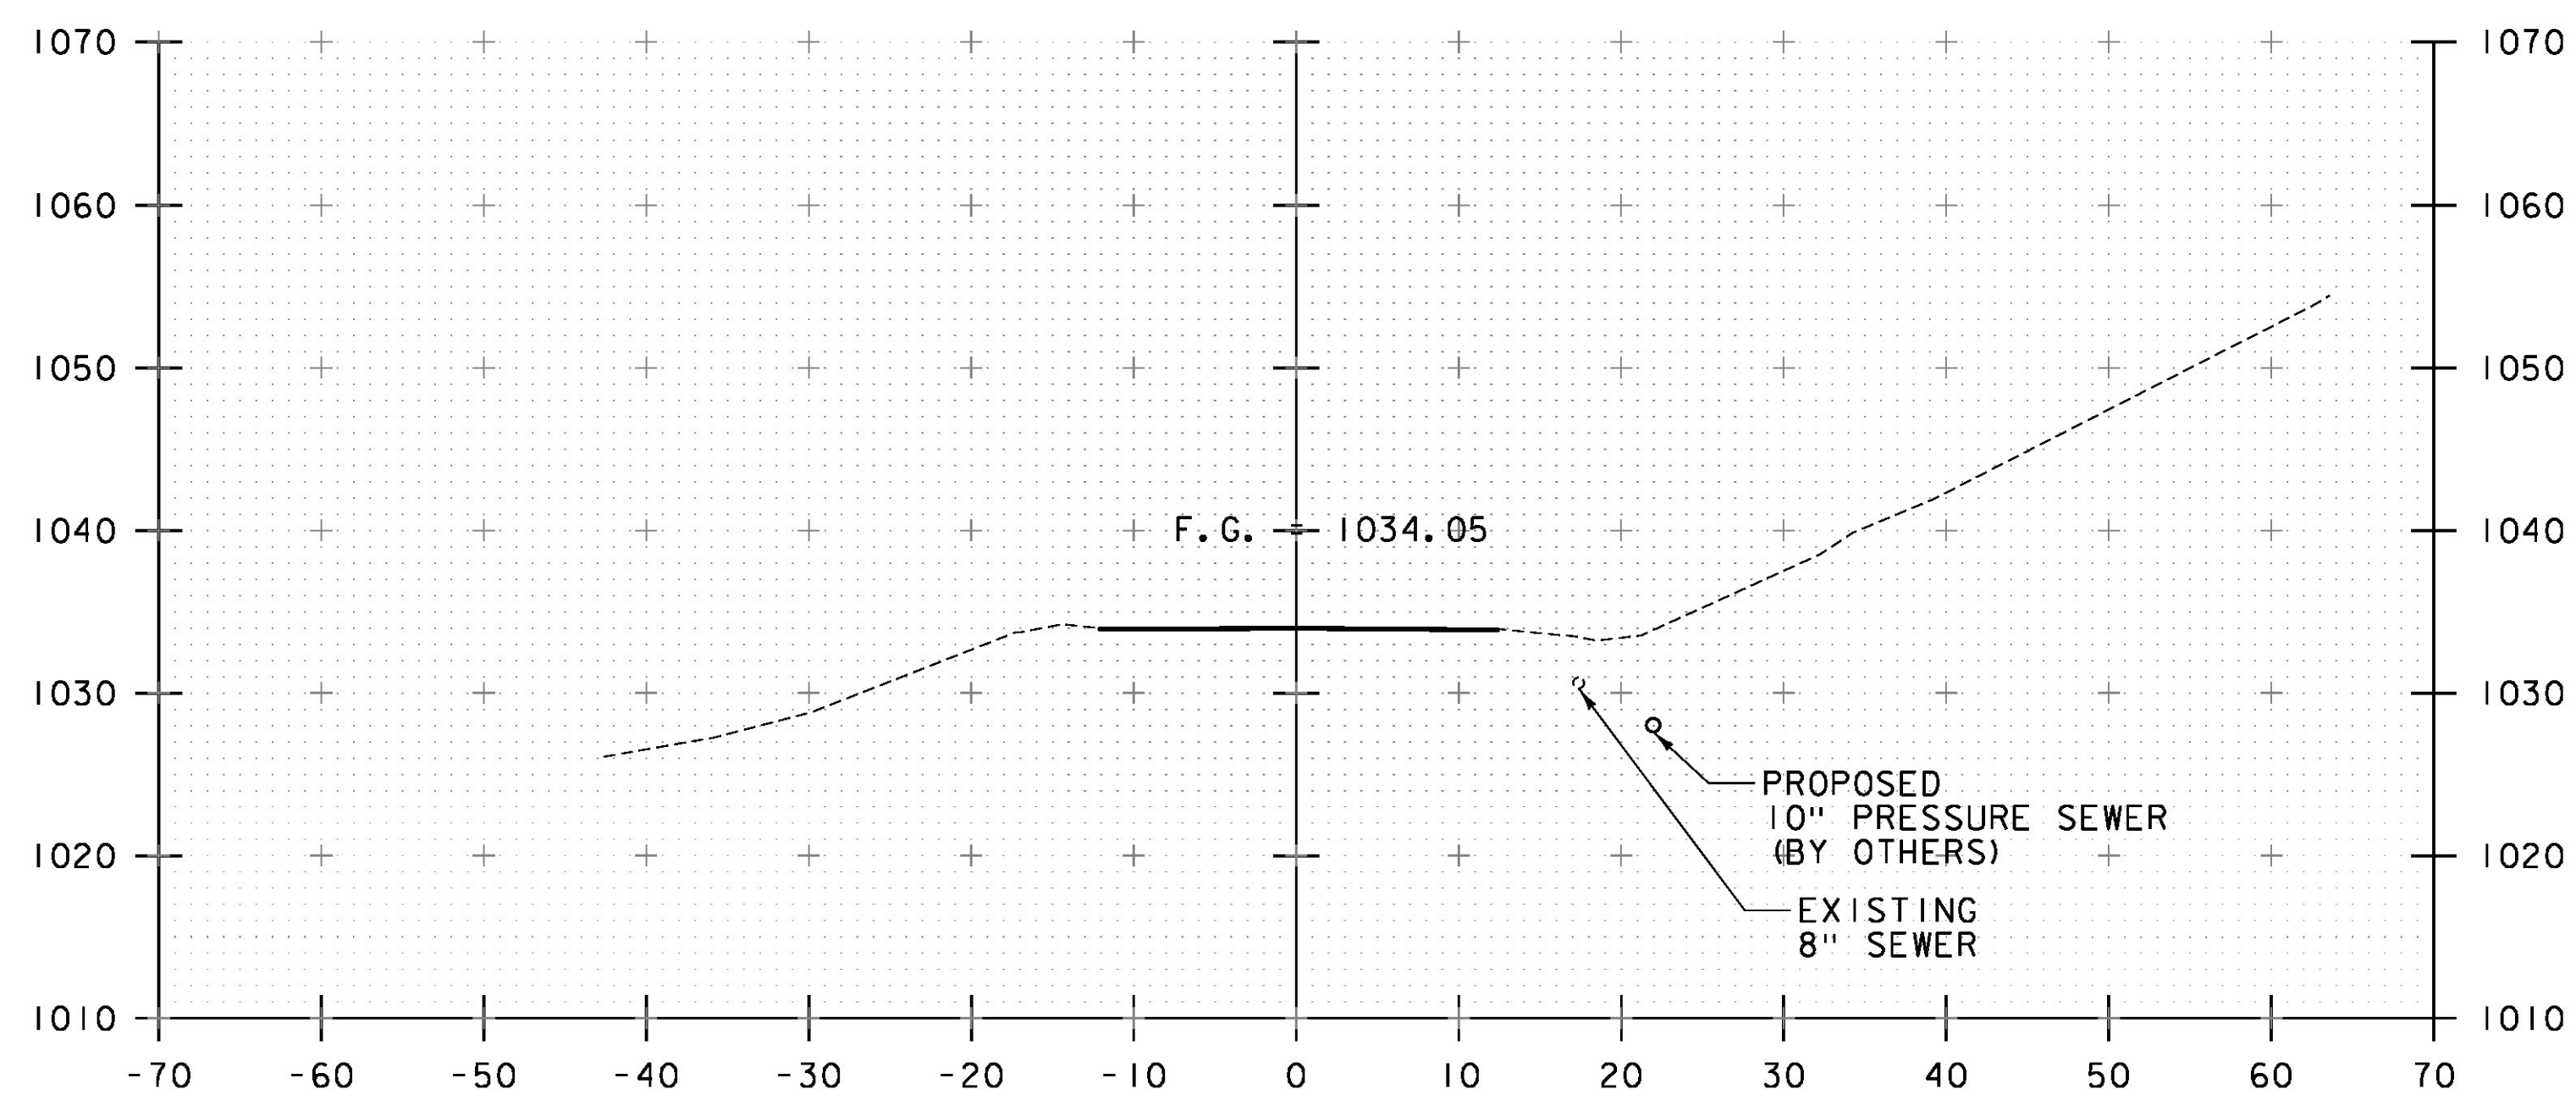

170+50
END APPROACH

STA. 170+00 TO STA. 170+50

PROJECT NAME:	JAY	PLOT DATE:	8/16/2016
PROJECT NUMBER:	BHF 0278(3)	DRAWN BY:	I. MAYNARD
FILE NAME:	z12ci54xsl.dgn	CHECKED BY:	G. SANTY
PROJECT LEADER:	M. CHENETTE	ROADWAY CROSS SECTIONS - RXS 5	SHEET 47 OF 72
DESIGNED BY:	I. MAYNARD		

