


50+25

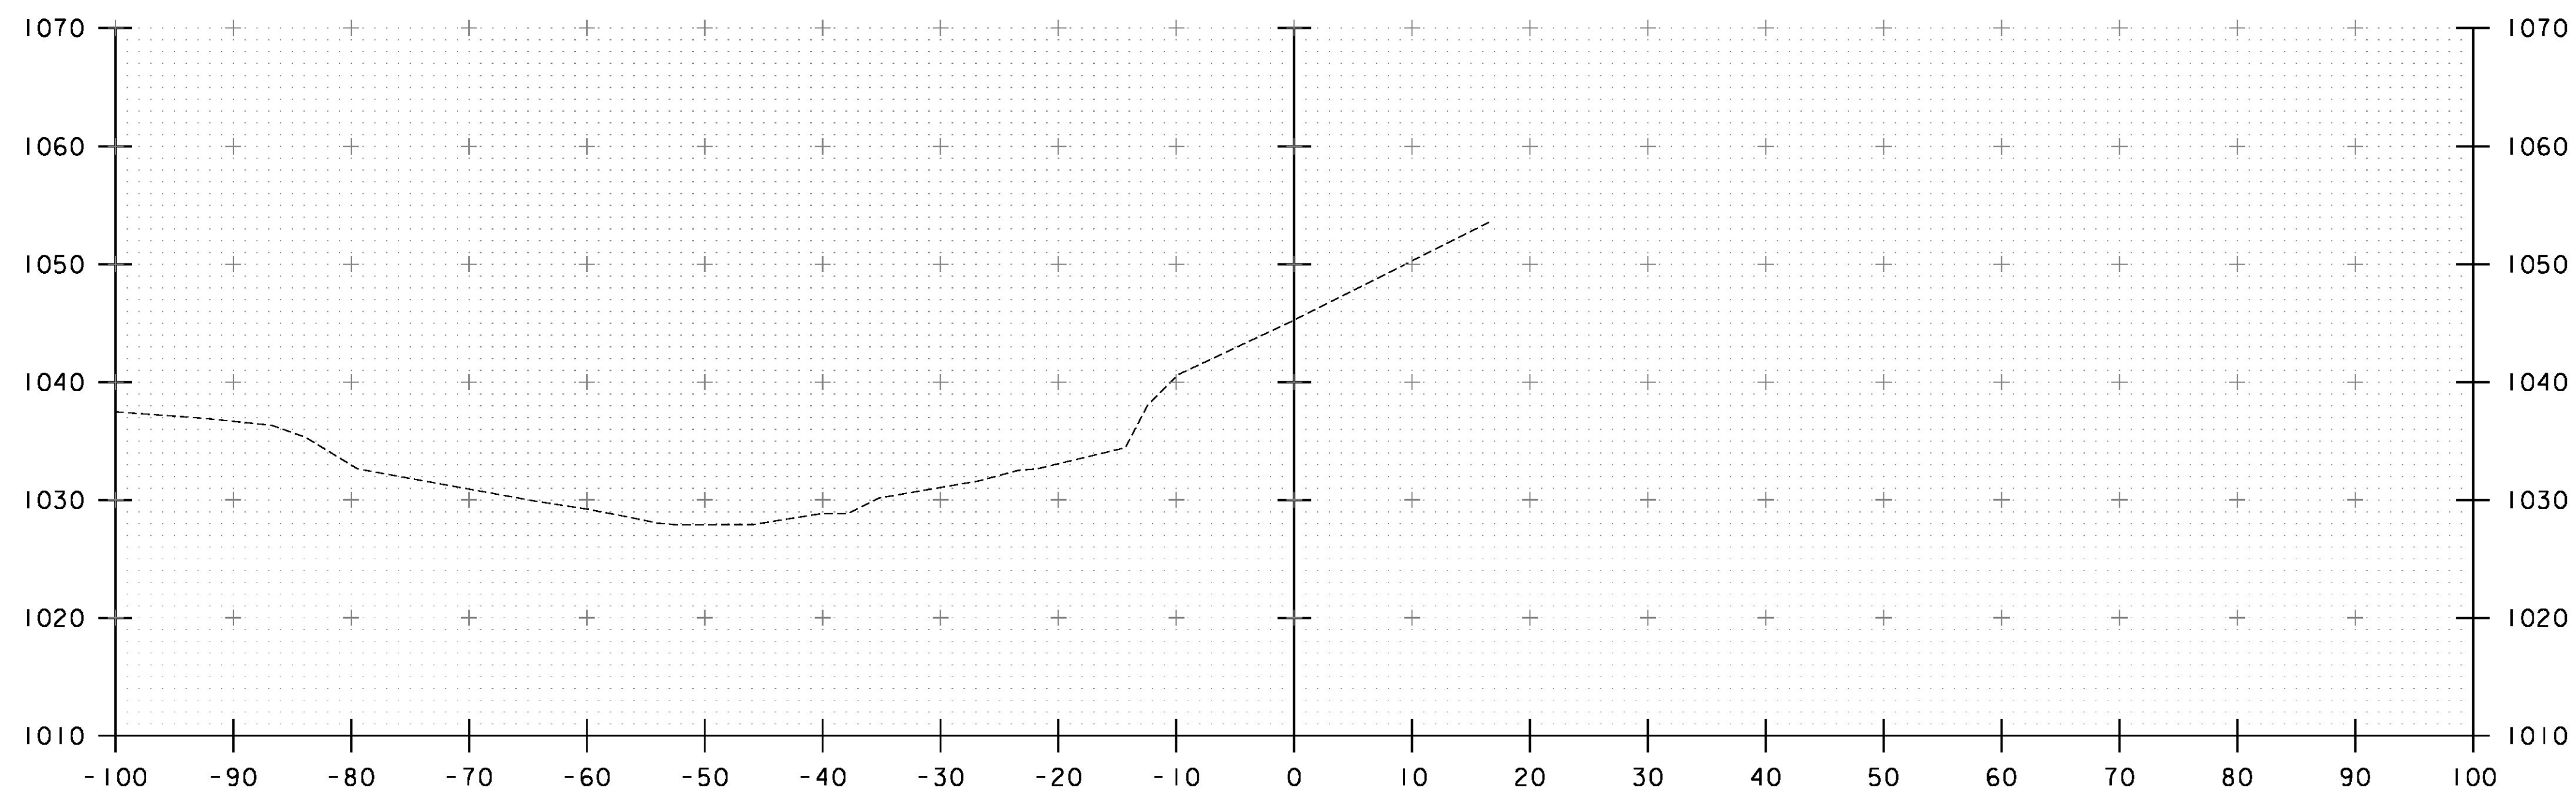

50+00

STA. 50+00 TO STA. 50+25

PROJECT NAME: JAY	PLOT DATE: 8/16/2016
PROJECT NUMBER: BHF 0278(3)	DRAWN BY: L. BUXTON
FILE NAME: z12ci54xsl.dgn	DESIGNED BY: J. HUNGERFORD
PROJECT LEADER: M. CHENETTE	CHECKED BY: M. CHENETTE
CHANNEL CROSS SECTIONS - CXS 1	SHEET 48 OF 72

