


STA. 50+53 LT
 BEGIN UNCLASSIFIED CHANNEL EXCAVATION
 STONE FILL, TYPE IV
 GEOTEXTILE UNDER STONE FILL
 GRUBBING MATERIAL

STA. 50+65 RT
 BEGIN UNCLASSIFIED CHANNEL EXCAVATION
 STONE FILL, TYPE IV
 GEOTEXTILE UNDER STONE FILL
 GRUBBING MATERIAL

50+75

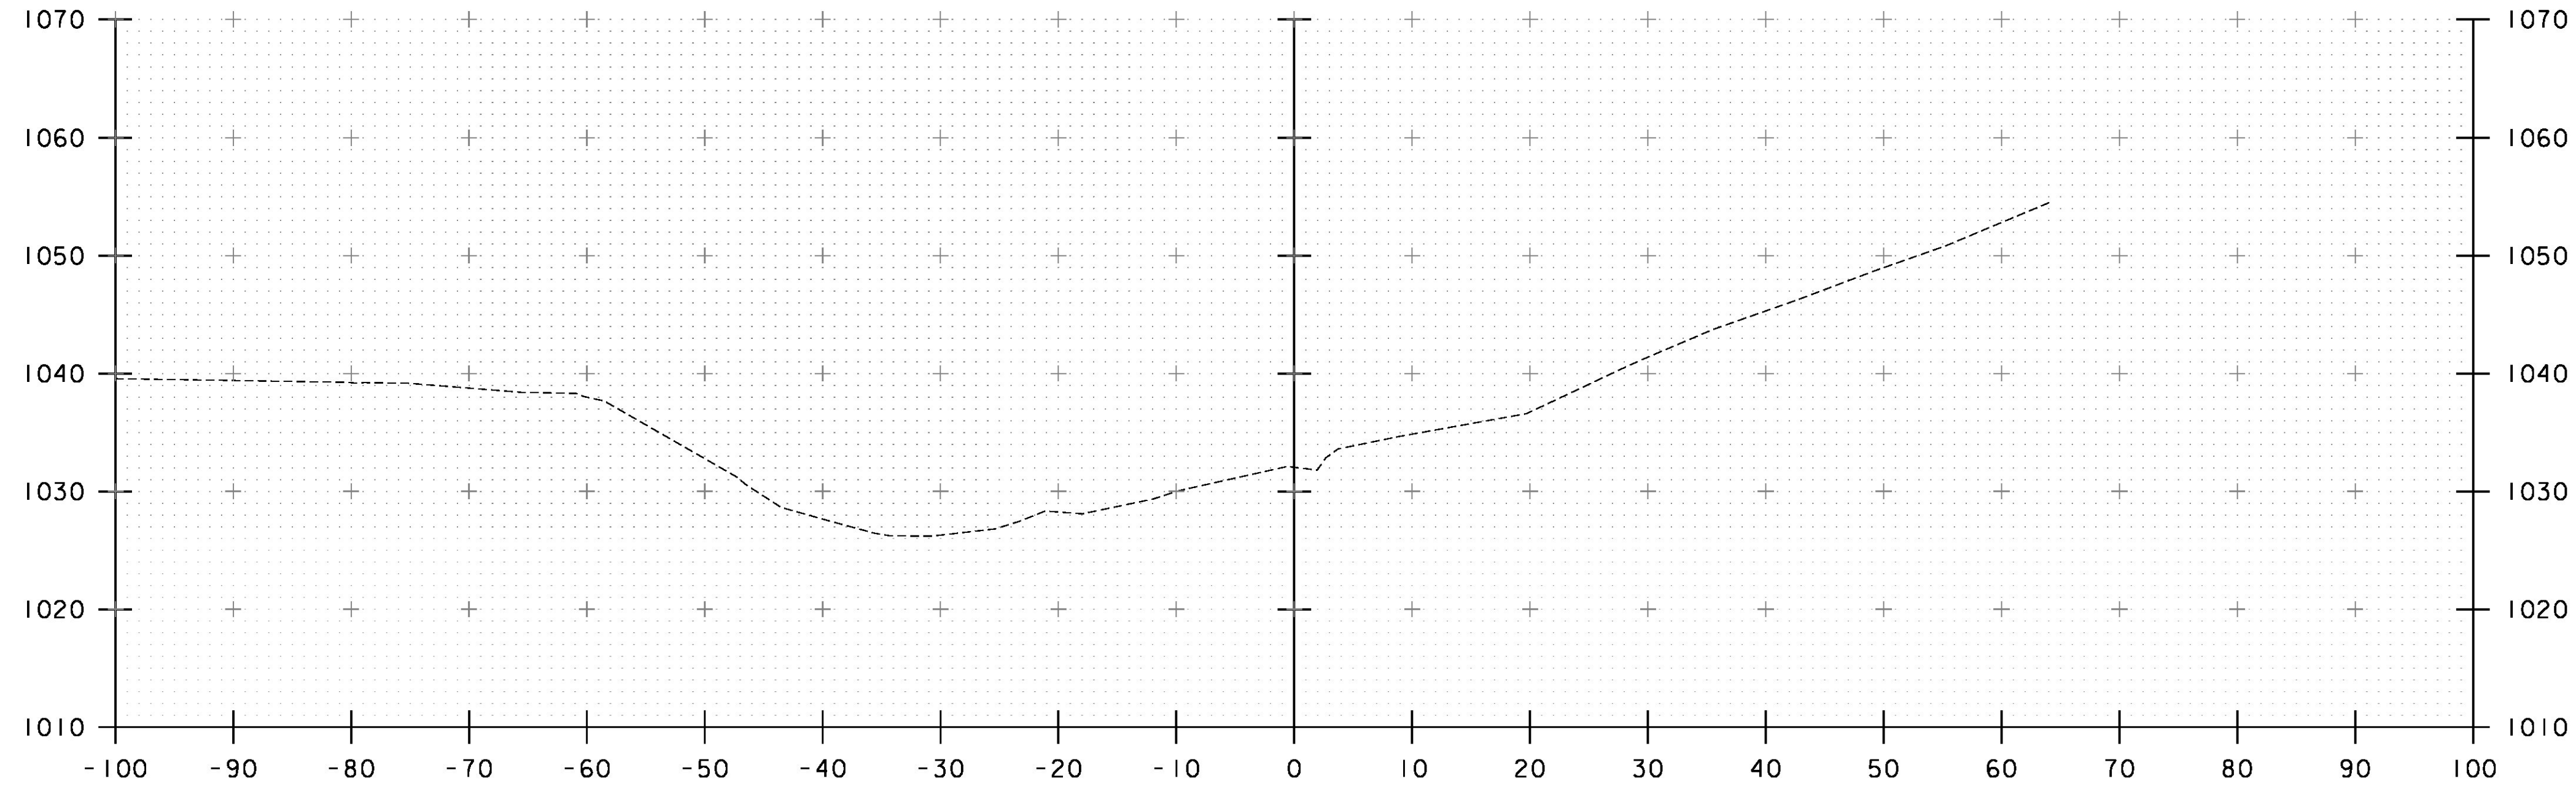

50+50

STA. 50+50 TO STA. 50+75

REVISIONS		
△	09.27.16	REMOVE SAND BAG SYMBOLS

PROJECT NAME: JAY
 PROJECT NUMBER: BHF 0278(3)

FILE NAME: z12ci54xsl.dgn
 PROJECT LEADER: M. CHENETTE
 DESIGNED BY: J. HUNGERFORD
 CHANNEL CROSS SECTIONS - CXS 2

PLOT DATE: 9/26/2016
 DRAWN BY: L. BUXTON
 CHECKED BY: M. CHENETTE
 SHEET 49 OF 72

