



51+10

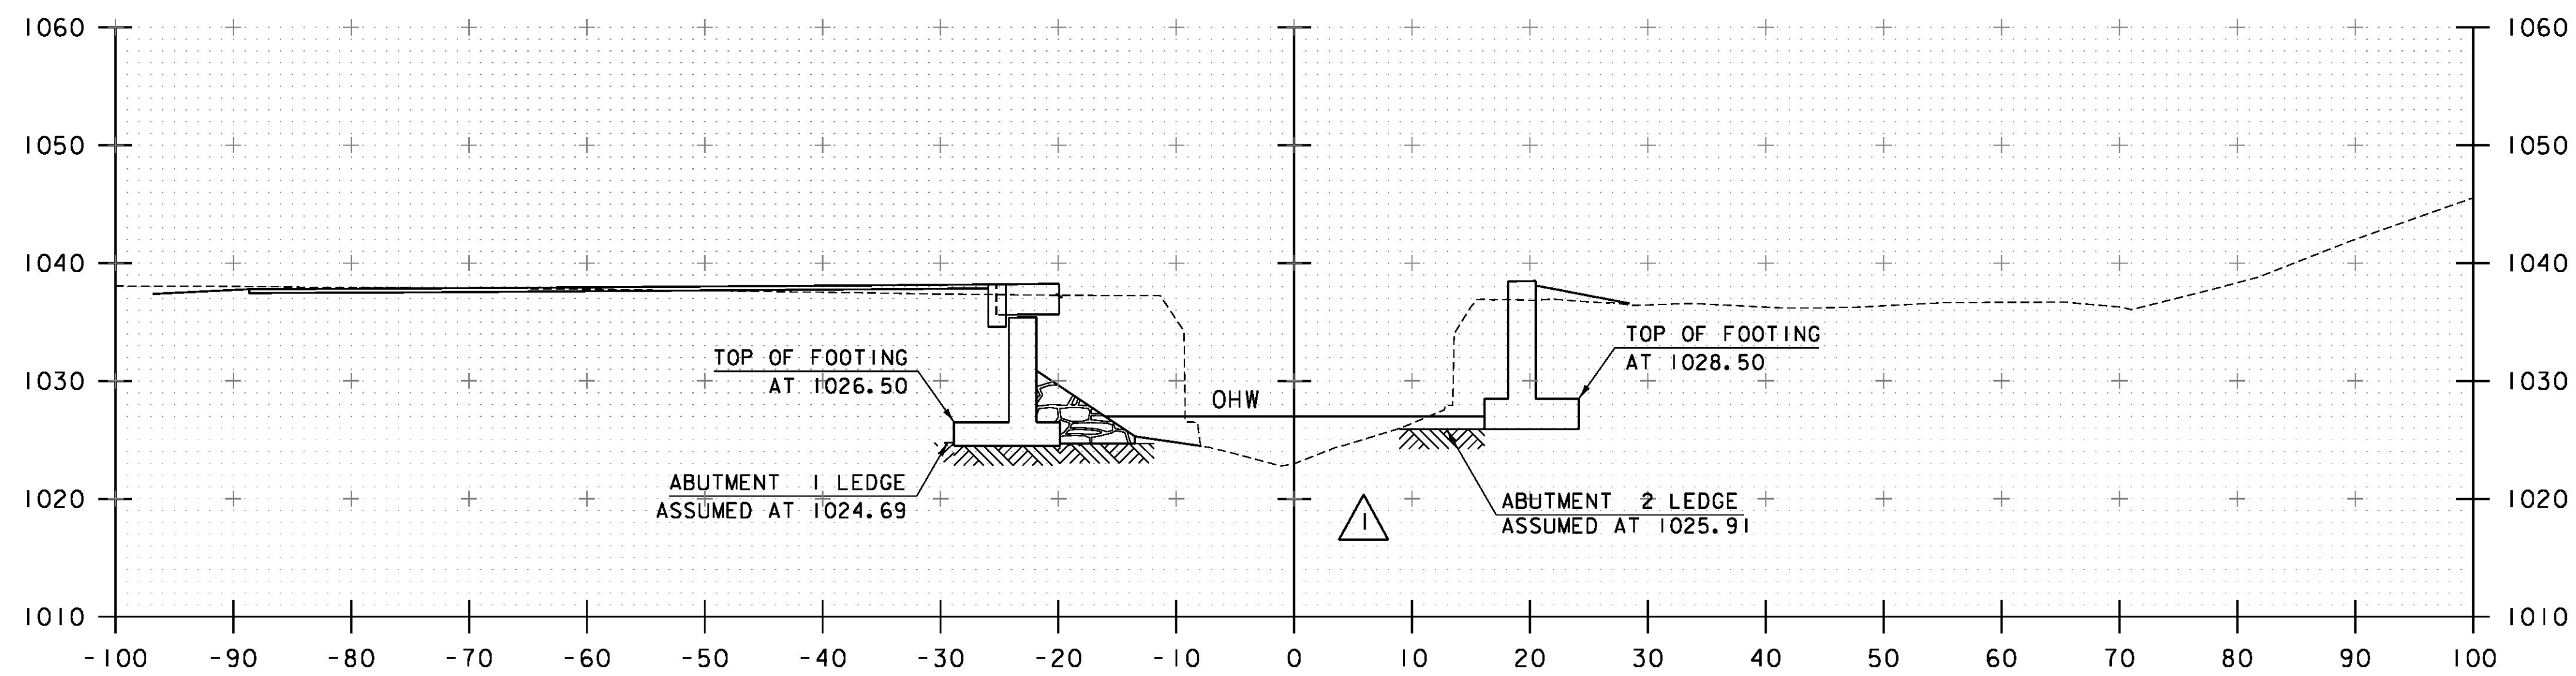

51+00

STA. 51+00 RT
 END UNCLASSIFIED CHANNEL EXCAVATION
 STONE FILL, TYPE IV
 GEOTEXTILE UNDER STONE FILL
 GRUBBING MATERIAL

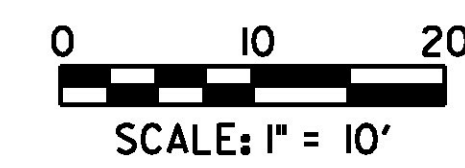

STA. 51+00 TO STA. 51+10

REVISIONS		
	09.27.16	REMOVE SAND BAG SYMBOLS
PROJECT NAME: JAY		
PROJECT NUMBER: BHF 0278(3)		
FILE NAME: z12ci54xsl.dgn	PLOT DATE: 9/26/2016	
PROJECT LEADER: M. CHENETTE	DRAWN BY: L. BUXTON	
DESIGNED BY: J. HUNGERFORD	CHECKED BY: M. CHENETTE	
CHANNEL CROSS SECTIONS - CXS 4	SHEET 51 OF 72	