


51+30

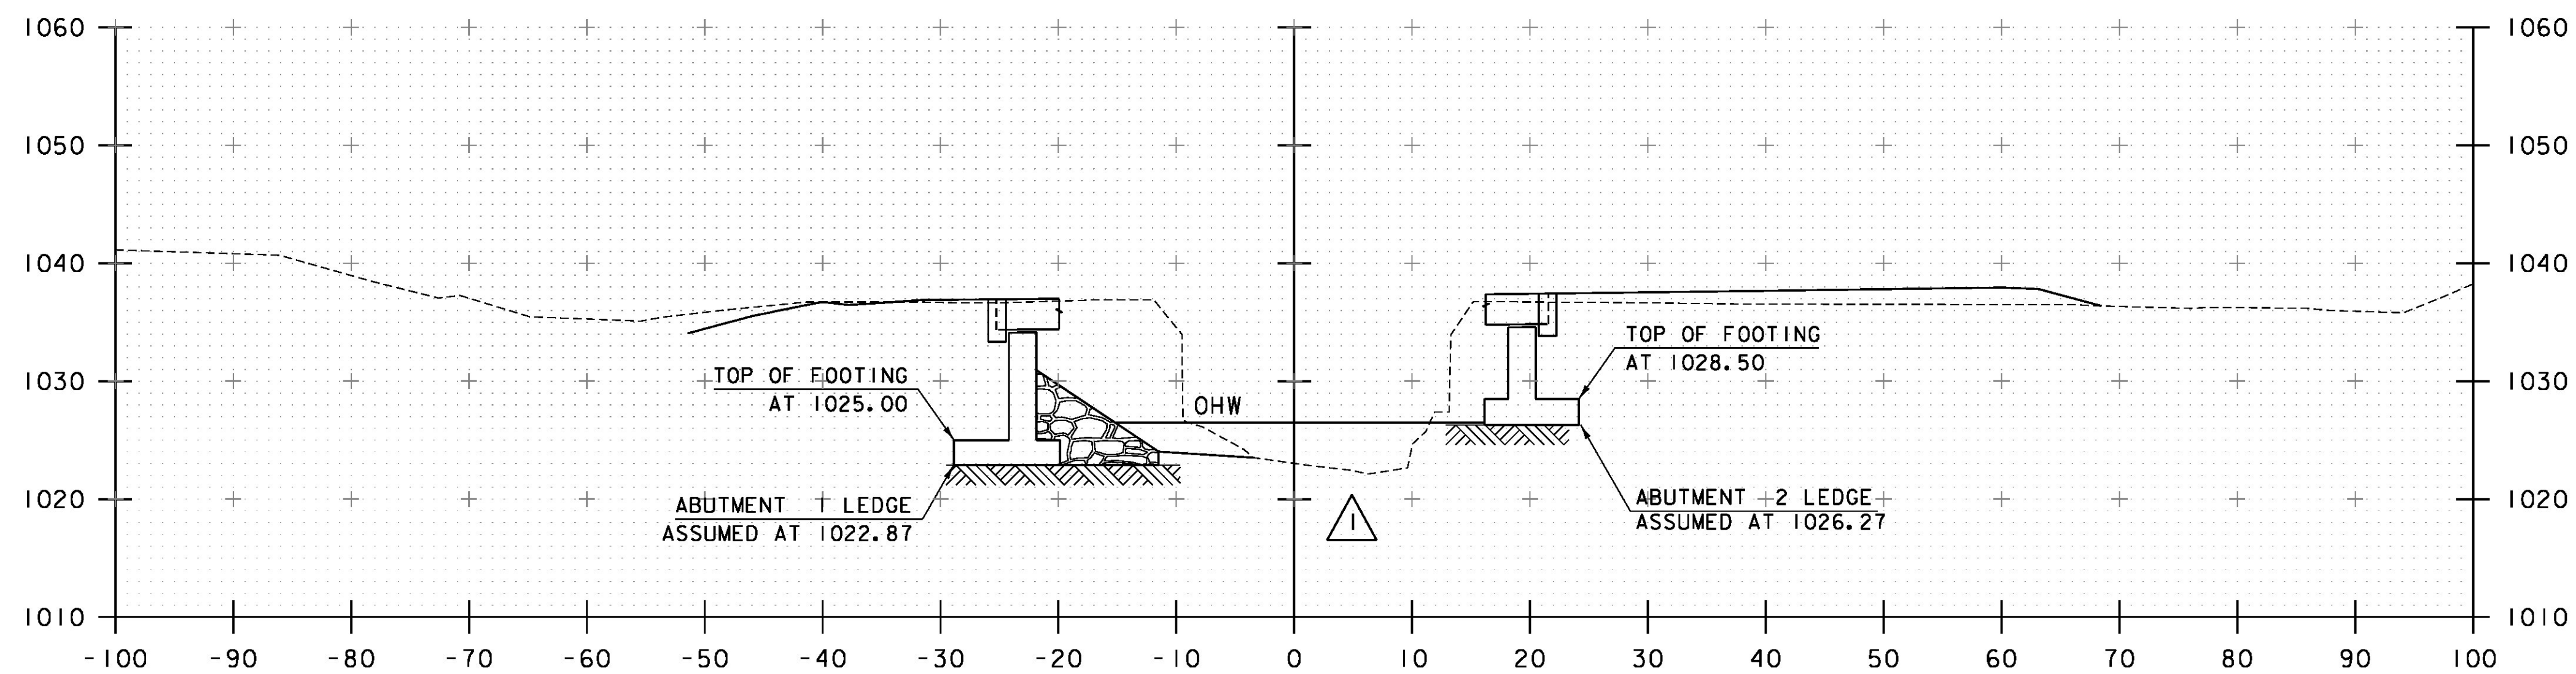

51+20

STA. 51+20 TO STA. 51+30

REVISIONS		
△	09.27.16	REMOVE SAND BAG SYMBOLS

PROJECT NAME:	JAY	FILE NAME:	z12ci54xsl.dgn	PLOT DATE:	9/26/2016
PROJECT NUMBER:	BHF 0278(3)	PROJECT LEADER:	M. CHENETTE	DRAWN BY:	L. BUXTON
		DESIGNED BY:	J. HUNGERFORD	CHECKED BY:	M. CHENETTE
		CHANNEL CROSS SECTIONS - CXS 5		SHEET	52 OF 72

