


51+99

STA. 51+99 TO STA. 51+99

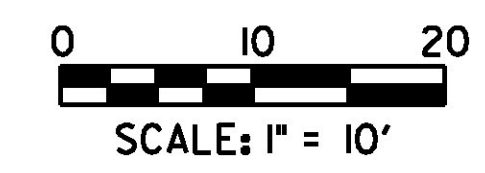

PROJECT NAME: JAY	PLOT DATE: 8/16/2016
PROJECT NUMBER: BHF 0278(3)	DRAWN BY: L. BUXTON
FILE NAME: z12ci54xsl.dgn	DESIGNED BY: J. HUNGERFORD
PROJECT LEADER: M. CHENETTE	CHECKED BY: M. CHENETTE
CHANNEL CROSS SECTIONS - CXS 7	SHEET 54 OF 72