

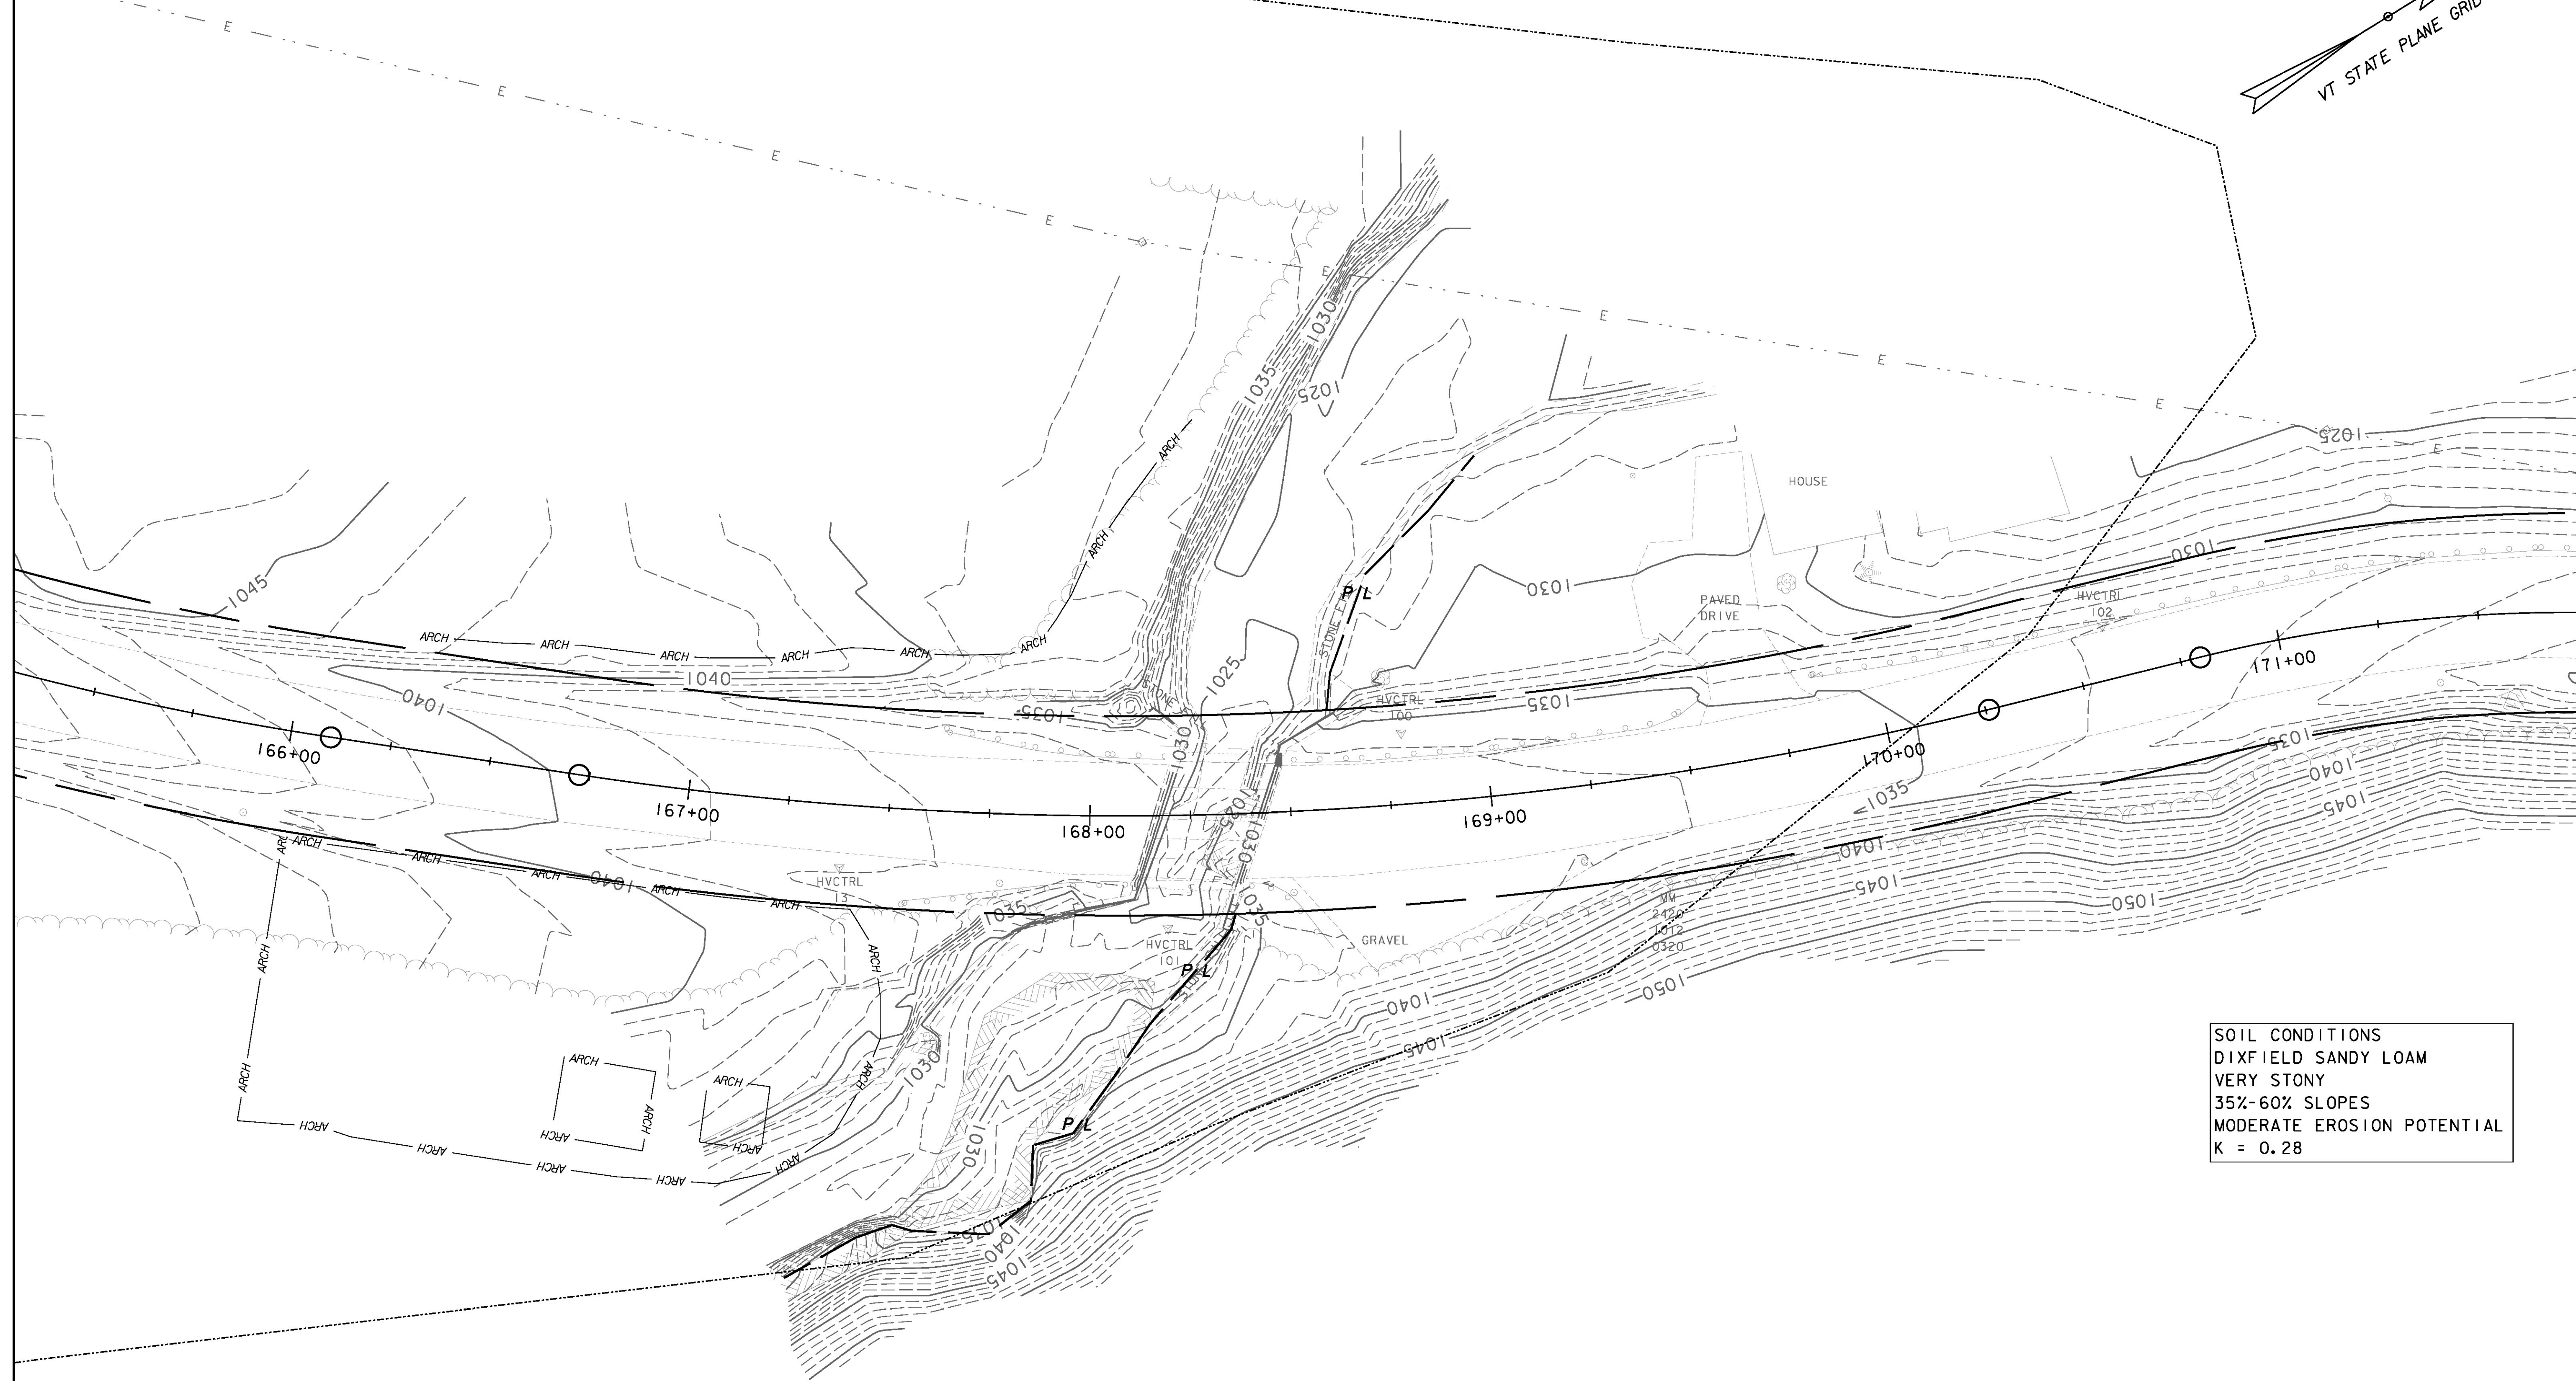


SOIL CONDITIONS  
 SHEEPSKOT GRAVELLY FINE SANDY LOAM  
 3%-8% SLOPES  
 LOW EROSION POTENTIAL  
 K = 0.17

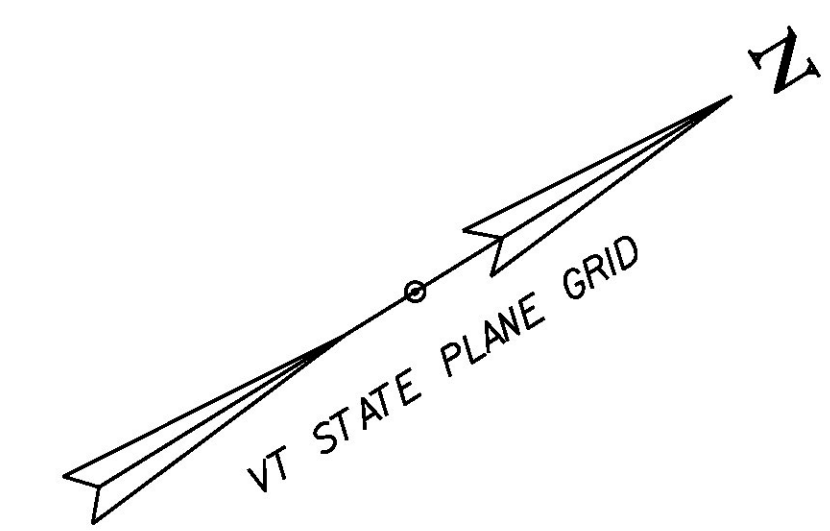

SOIL CONDITIONS  
 DIXFIELD SANDY LOAM  
 VERY STONY  
 35%-60% SLOPES  
 MODERATE EROSION POTENTIAL  
 K = 0.28

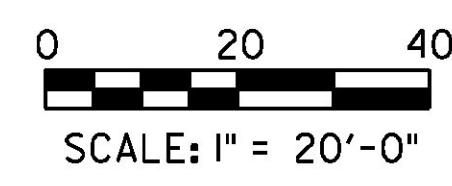

PROJECT NAME:	JAY	PLOT DATE:	8/16/2016
PROJECT NUMBER:	BHF 0278(3)	DRAWN BY:	D. BARNES
FILE NAME:	z12ci54bdr_ero.dgn	DESIGNED BY:	I. MAYNARD
PROJECT LEADER:	M. CHENETTE	CHECKED BY:	G. SANTY
EPSC EXISTING CONDITIONS SITE PLAN			SHEET 56 OF 72