
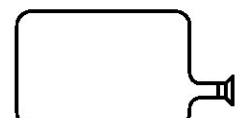





LEGEND


 VEHICLE TRACKING PAD

 FILTER BAG

 FILTER CURTAIN 

FOR ADDITIONAL INFORMATION, SEE CONVENTIONAL SYMBOLS LEGEND SHEET

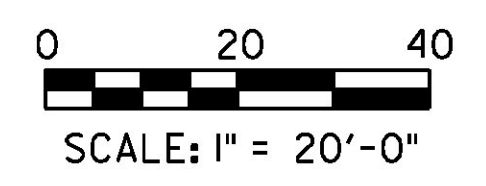

REVISIONS	
	09.27.16 CHANGED COFFERDAM SYMBOL TO FILTER CURTAIN SYMBOL
PROJECT NAME: JAY	
PROJECT NUMBER: BHF 0278(3)	
FILE NAME: z12ci54bdr_ero.dgn	PLOT DATE: 9/26/2016
PROJECT LEADER: M. CHENETTE	DRAWN BY: D. BARNES
DESIGNED BY: I. MAYNARD	CHECKED BY: G. SANTY
EPSC CONSTRUCTION SITE PLAN	SHEET 57 OF 72