



IMPACTS BELOW ORDINARY HIGH WATER

 TEMPORARY IMPACTS BELOW OHW: 818 SF

 PERMANENT IMPACTS BELOW OHW: 136 SF

TOTAL IMPACTS: 954 SF

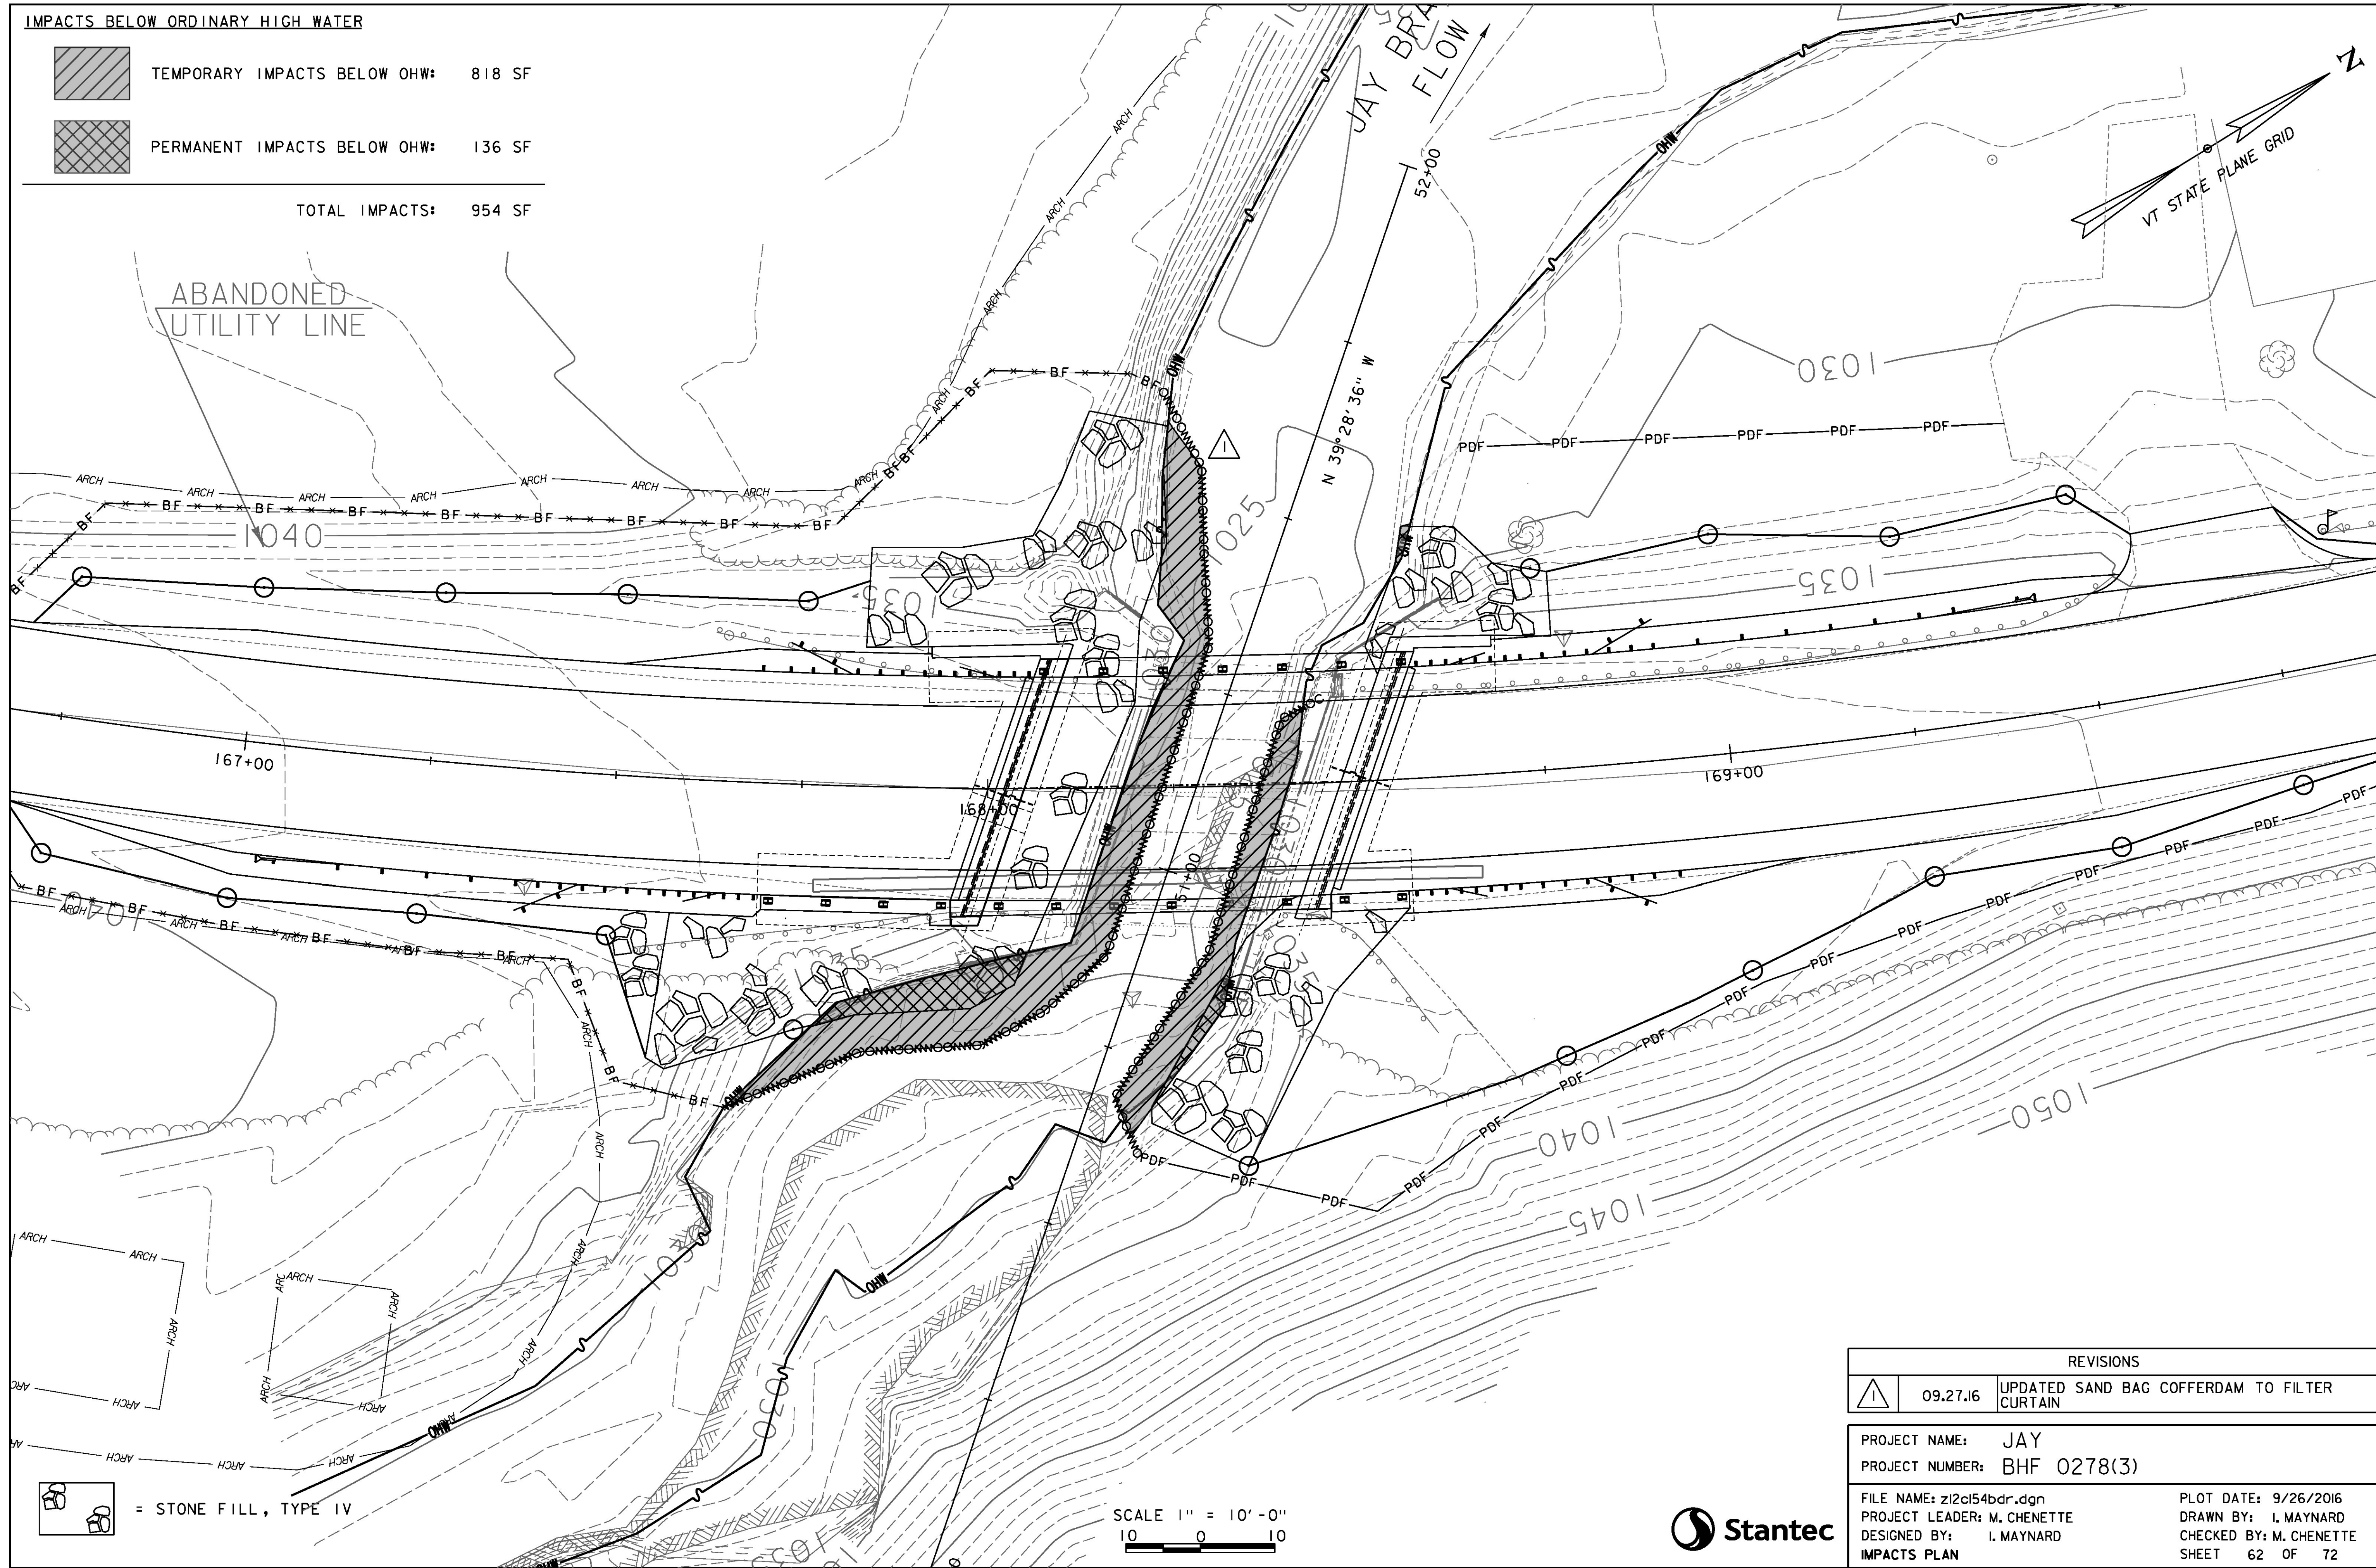

REVISIONS		
	09.27.16	UPDATED SAND BAG COFFERDAM TO FILTER CURTAIN

PROJECT NAME:	JAY	PLOT DATE:	9/26/2016
PROJECT NUMBER:	BHF 0278(3)	DRAWN BY:	I. MAYNARD
FILE NAME:	z12ci54bdr.dgn	DESIGNED BY:	I. MAYNARD
PROJECT LEADER:	M. CHENETTE	CHECKED BY:	M. CHENETTE
IMPACTS PLAN		SHEET	62 OF 72

