


PLAN  
 SHEET NO. 278  
 DATE 7/20/63  
 PROJECT NO. 1222-494

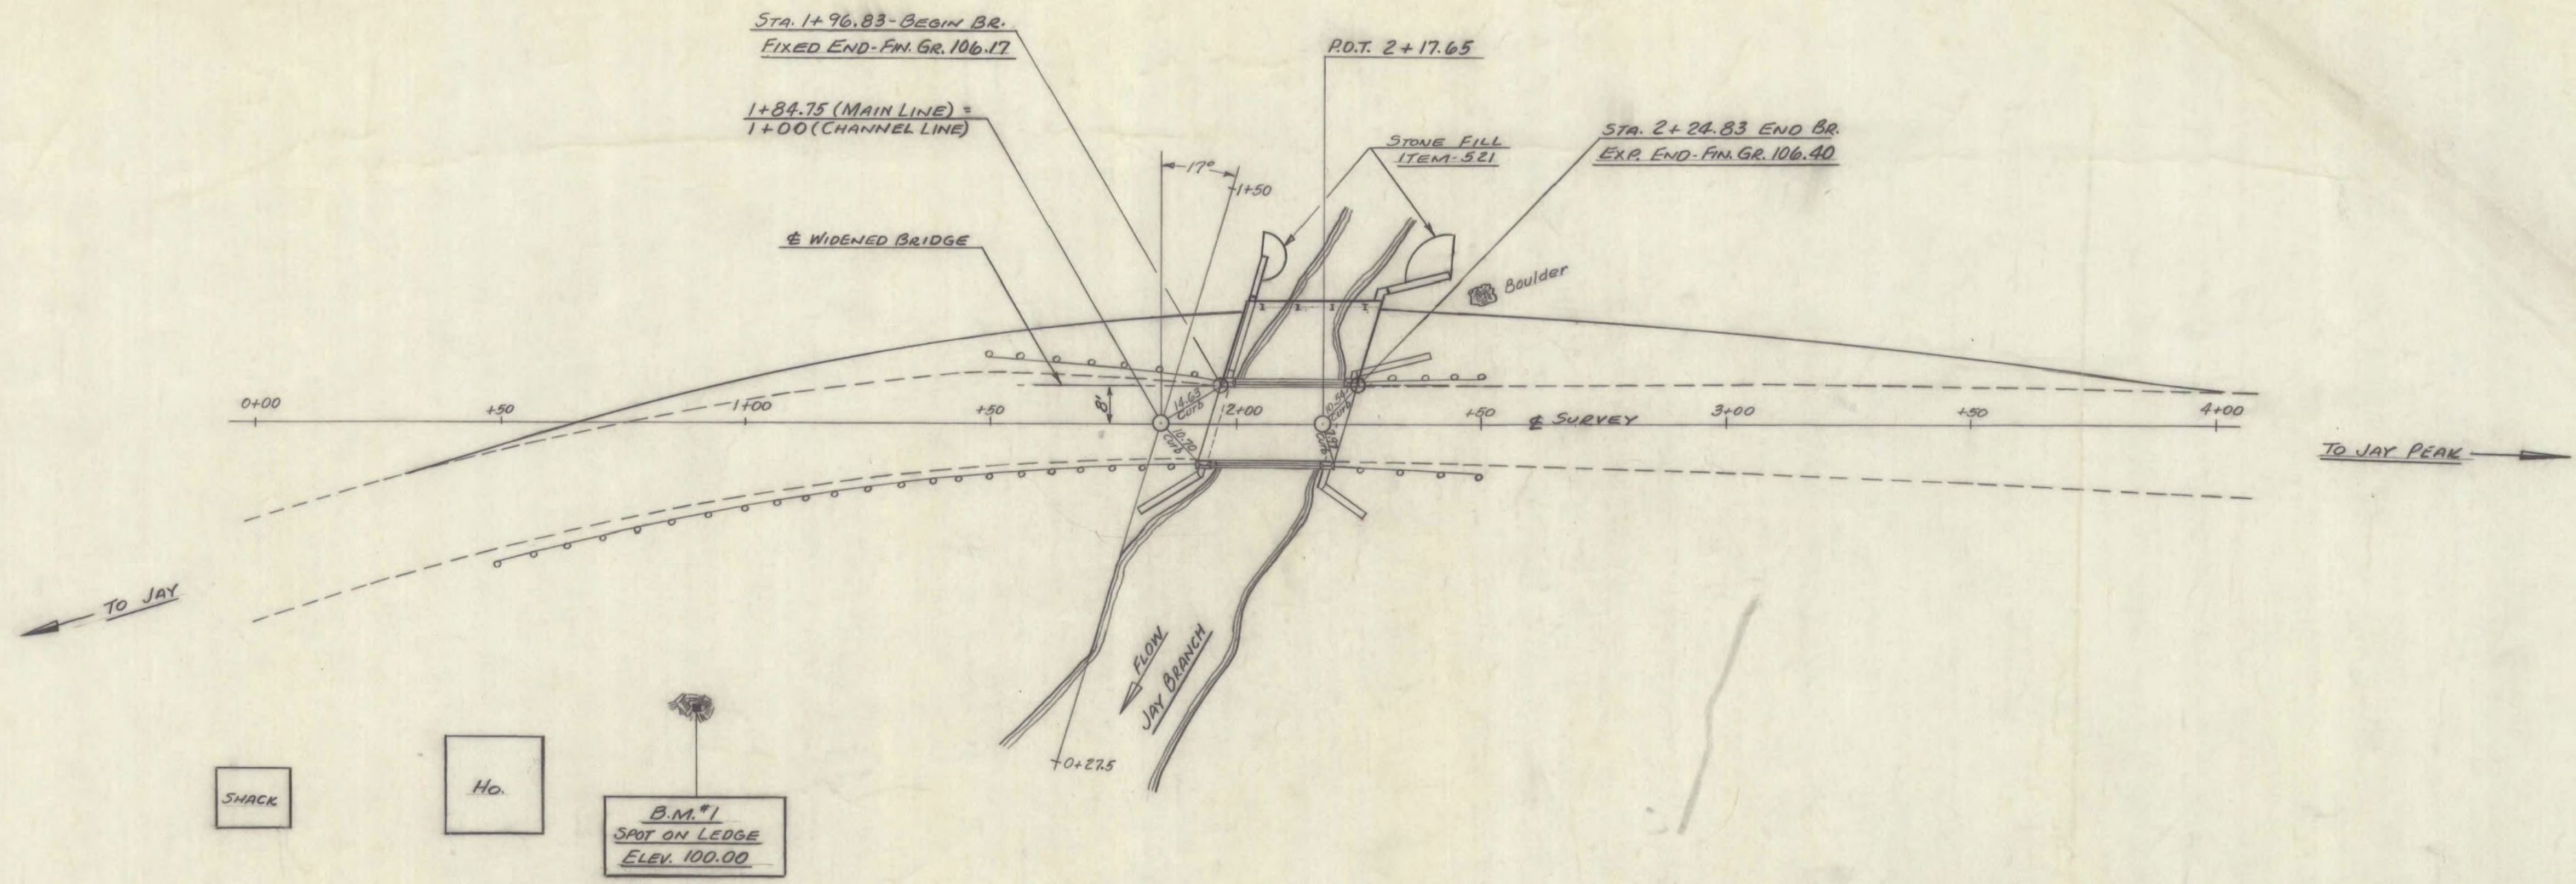

TWO CABLE GUARD RAIL

STA. TO STA.	LIN. FT.	ANCHORS
1+50 LK. 1+98 LK.	48	1
2+29 LK. 2+69 LK.	40	1
<b>TOTALS</b>	<b>88</b>	<b>2</b>


~SUMMARY OF QUANTITIES~

ITEM NO.	ITEM	UNIT	TOTAL	FINAL
101-B	SOLID ROCK EXCAVATION	C.Y.	10	
107	STRUCTURE EXCAVATION	C.Y.	48	
204A	SUB-BASE OF GRAVEL (MOD.)	C.Y.	18	
317	SINGLE TACK COAT OF REFINED TAR & BLADE			
	MIX PER STONE SEAL WITH CURBACK ASPHALT	GAL.	1258	
401-A	CONCRETE CLASS AA (MOD.)	C.Y.	26	
401-B	CONCRETE CLASS B (MOD.)	C.Y.	51	
402	REINFORCING STEEL	LB.	7996	
521	STONE FILL (HEAVY TYPE)	C.Y.	9	
542	TWO CABLE GUARD RAIL	L.F.	88	
543	THREE CABLE GUARD RAIL WITH STEEL POSTS (MOD.)	L.F.	56	
545	ANCHORS FOR TWO CABLE GUARD RAIL	EA.	2	
574	PREPARING SUPERSTRUCTURE FOR WIDENING	L.S.	1	
102	BORROW	C.Y.	213	

RECOMMENDED FOR APPROVAL: J.P.R. [Signature] DISTRICT ENGINEER DATE: APR. 3, 1965  
 RECOMMENDED FOR APPROVAL: [Signature] BRIDGE ENGINEER DATE: 7/20/63  
 RECOMMENDED FOR APPROVAL: R.H. [Signature] ASSISTANT CHIEF ENGINEER DATE: 7/31/63  
 APPROVED BY: A.D. [Signature] CHIEF ENGINEER DATE: 7/21/63

~LIST OF SHEETS~

SHEET NO.	DESCRIPTION	NO.	DATE
1	PLAN & PROFILE	1	
2	DETAILS OF ABUTMENT NO. 1		
3	" " " NO. 2		
4	SUPERSTRUCTURE DETAILS		
5	REINFORCING STEEL DETAILS		
6-7	CHANNEL SECTIONS		
8	ROADWAY SECTIONS		
9	STANDARD DWG. G-3		
10	" " " SCB-06-62		90
11	" " " E-2		
12	" " " G-2a		

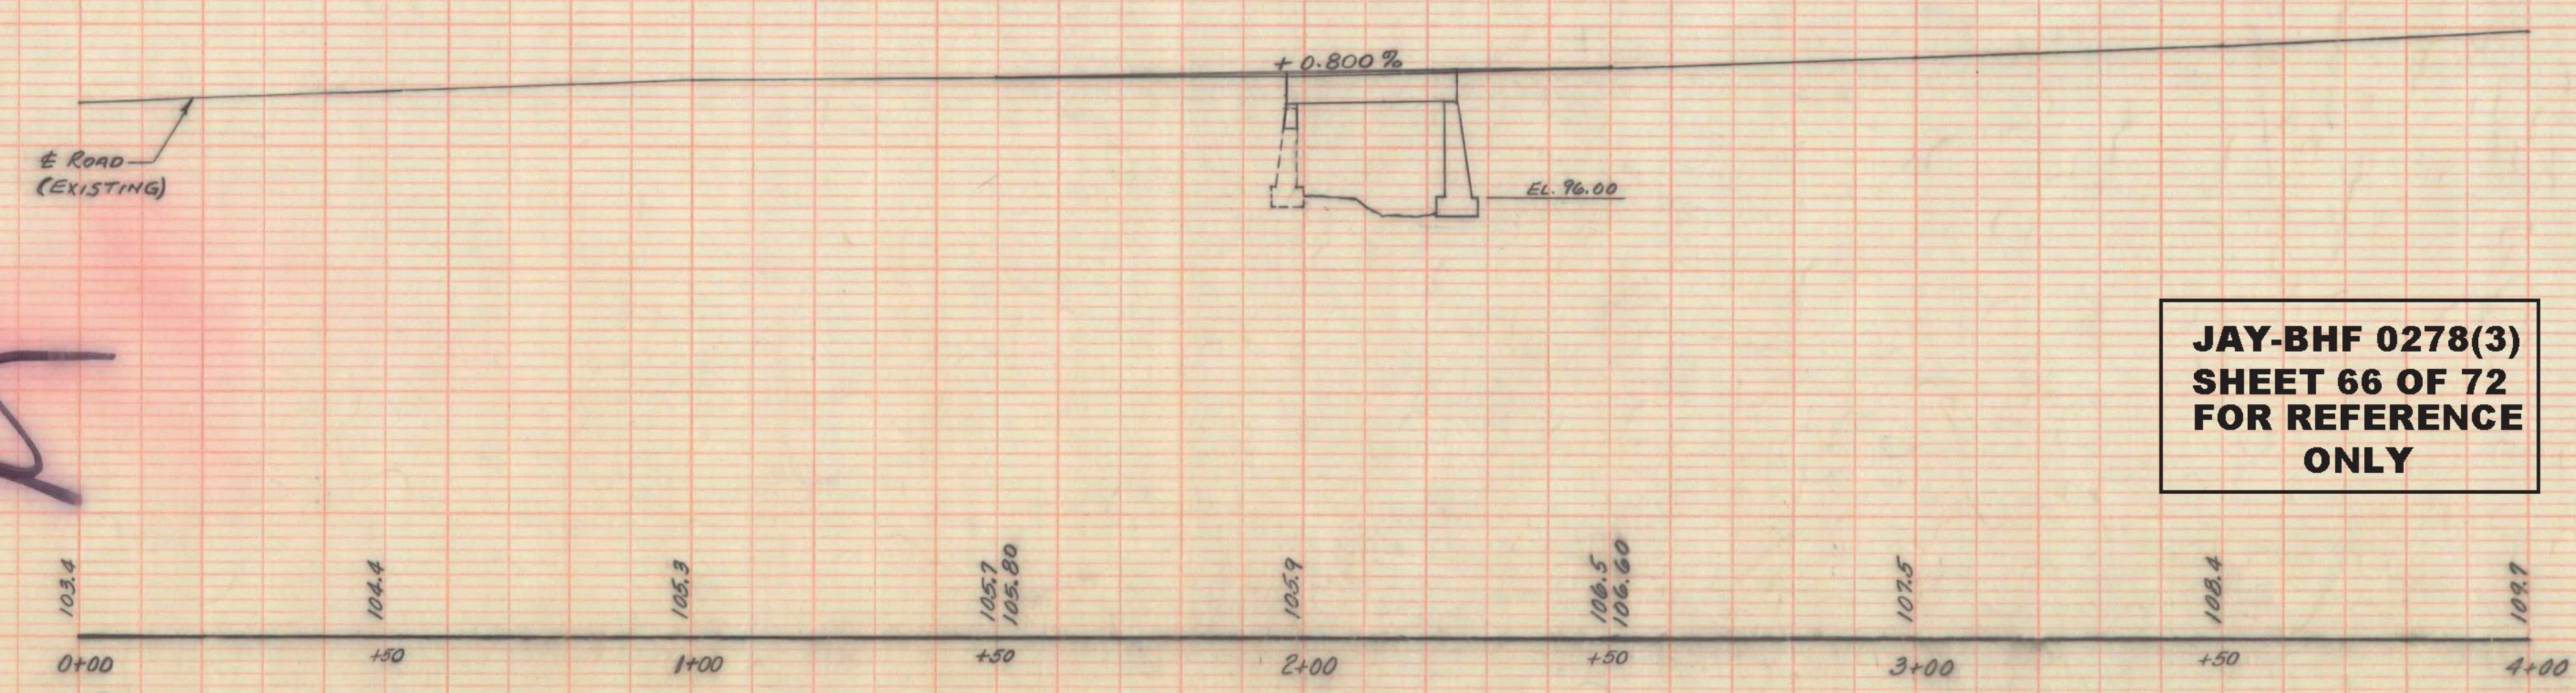

**JAY-BHF 0278(3)  
 SHEET 66 OF 72  
 FOR REFERENCE  
 ONLY**

JAY  
 JAY PEAK BRIDGE  
 STATE MAINTENANCE  
 1222-494

PROJECT: Jay  
 NUMBER: ST. 1222-494  
 TYPE: Conc. T-Bar Widening  
 CONTRACTOR:  
 YEAR: 1963  
 LOCATION: Jay - Tracy Highway - Log Sta. 92+96

B.M. #1 - SPOT ON LEDGE - 58' R. STA. 0+90