



SECTION A-A  
SCALE - 3/8" = 1'-0"

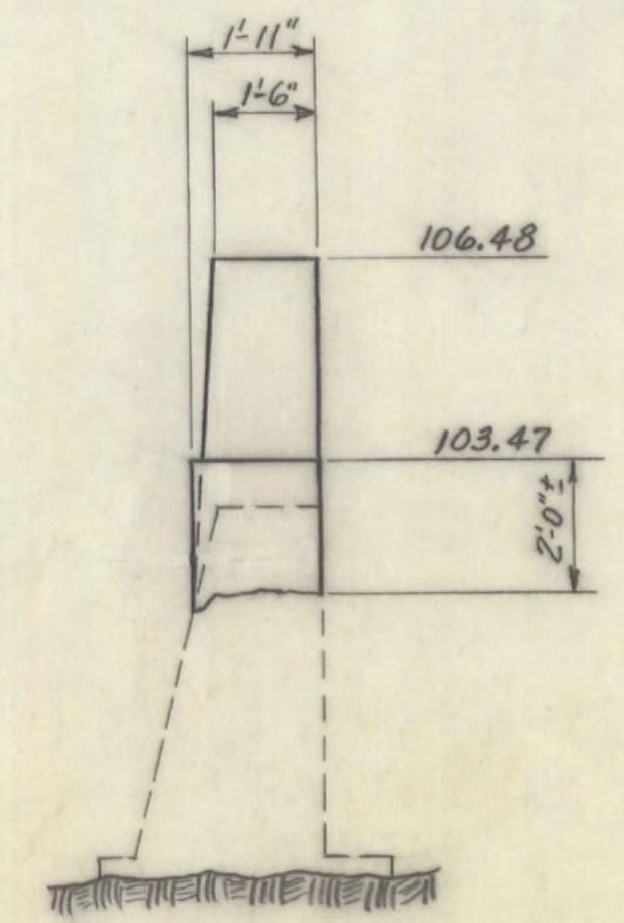

SECTION B-B  
SCALE - 3/8" = 1'-0"

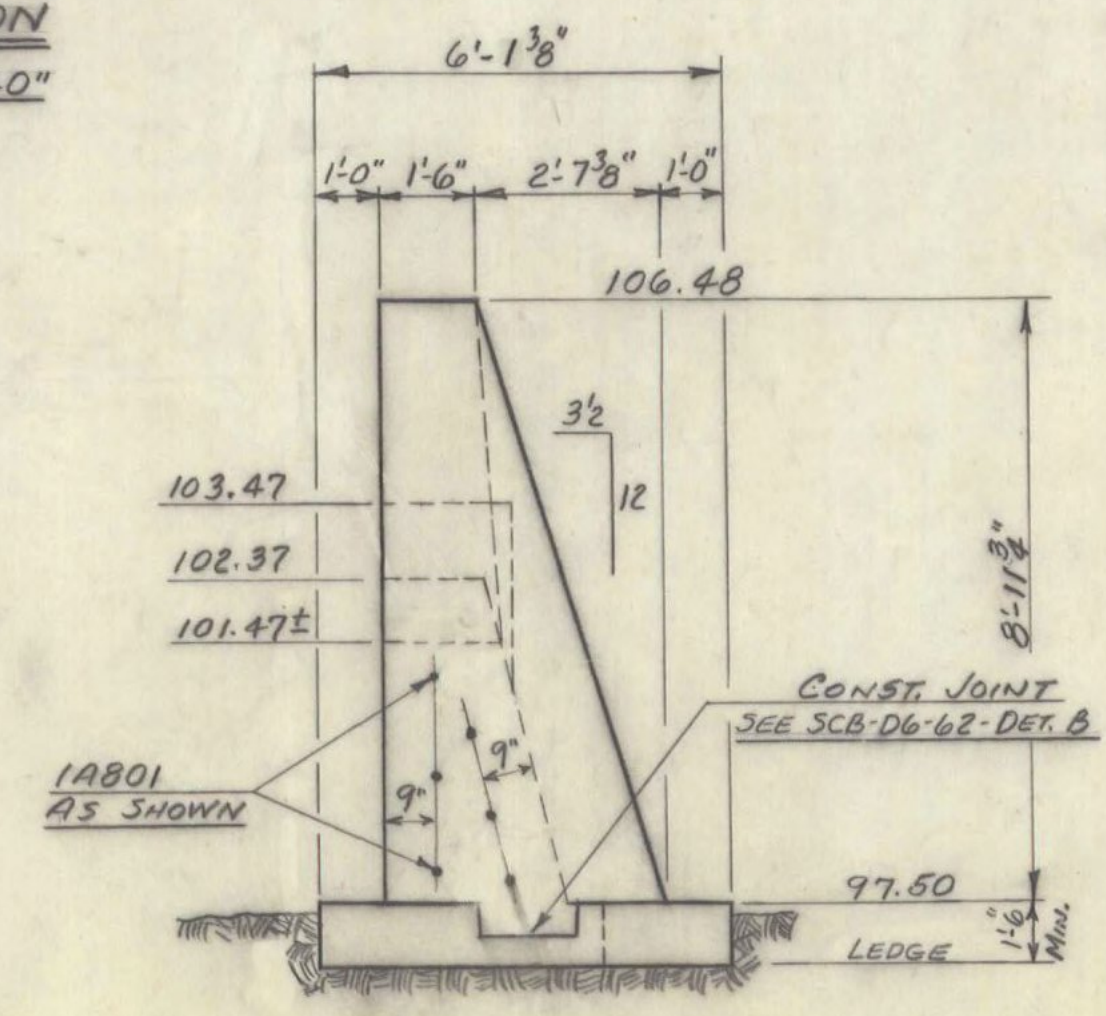

SECTION C-C  
SCALE - 3/8" = 1'-0"

**JAY-BHF 0278(3)  
SHEET 67 OF 72  
FOR REFERENCE ONLY**

ITEM NO.	ITEM	UNIT	NET	OVERRUN	TOTAL	FINAL
105-A	CHAN. EXCAV. OF EARTH	C.Y.				
105-B	CHAN. EXCAV. OF ROCK	C.Y.				
105-C	UNCLASS. CHAN. EXCAV.	C.Y.				
107	STRUCT. EXCAV.	C.Y.			9	
401-B	CONC. CLASS B (MOD.)	C.Y.			12	
402	REINF. STEEL (SEE REINF. STEEL DETS.)	LBS.				
407	ASPHALTIC-ASB. COATING	S.Y.				
502-B	TREATED TIMBER PILING	L.F.				
503	SPLICES FOR STEEL PILING	EA.				
504	STEEL PILING	L.F.				
502-A	UNTREATED TIMBER PILING	L.F.				
101-B	SOLID ROCK EXCAVATION	C.Y.			4	
521	STONE FILL (HEAVY TYPE)	C.Y.			3	

STATE OF VERMONT  
DEPARTMENT OF HIGHWAYS

TOWN OF JAY  
JAY TROY  
ROUTE NO. HIGHWAY LOG STA. 98+98

DETAILS OF ABUTMENT NO. 1  
JAY PEAK BRIDGE  
SCALE 3/8" = 1'-0"

SURVEYED BY BURLEY  
DRAWN BY RTG CHECKED BY RND  
PROJECT NO. STATE MAINT. 1222-494  
SHEET 2 OF 12