


PROFILE
 HORIZONTAL SCALE: 1" = 40'
 VERTICAL SCALE: 1" = 10'

RECORD DRAWING

RECORD DRAWINGS PREPARED FROM CONTRACTOR PROVIDED INFORMATION

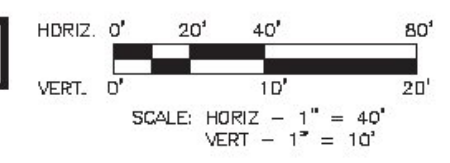

TOWNS OF TROY AND JAY VERMONT
 WASTEWATER COLLECTION SYSTEM (CONTRACT #4)

PLAN AND PROFILE
 STA 143+00 TO 154+00

Rev.	Date	Description
2	4/27/15	BRIDGE CROSSING
1	4/29/14	Removed All Release MH # 49
D	8/15/14	FOR BID
C	7/7/13	FOR REVIEW
B	2/2/13	FOR APPROVAL
A	5/17/12	FOR PERMIT REVIEW SET



T&H NO. 3452
 DATE: 07-07-2014
 SCALE: AS NOTED

C14

REVISIONS	
1	9.27.16 ADDED REFERENCE SHEET

**JAY SEWER PLANS
 SHEET 72A
 FOR REFERENCE ONLY**