
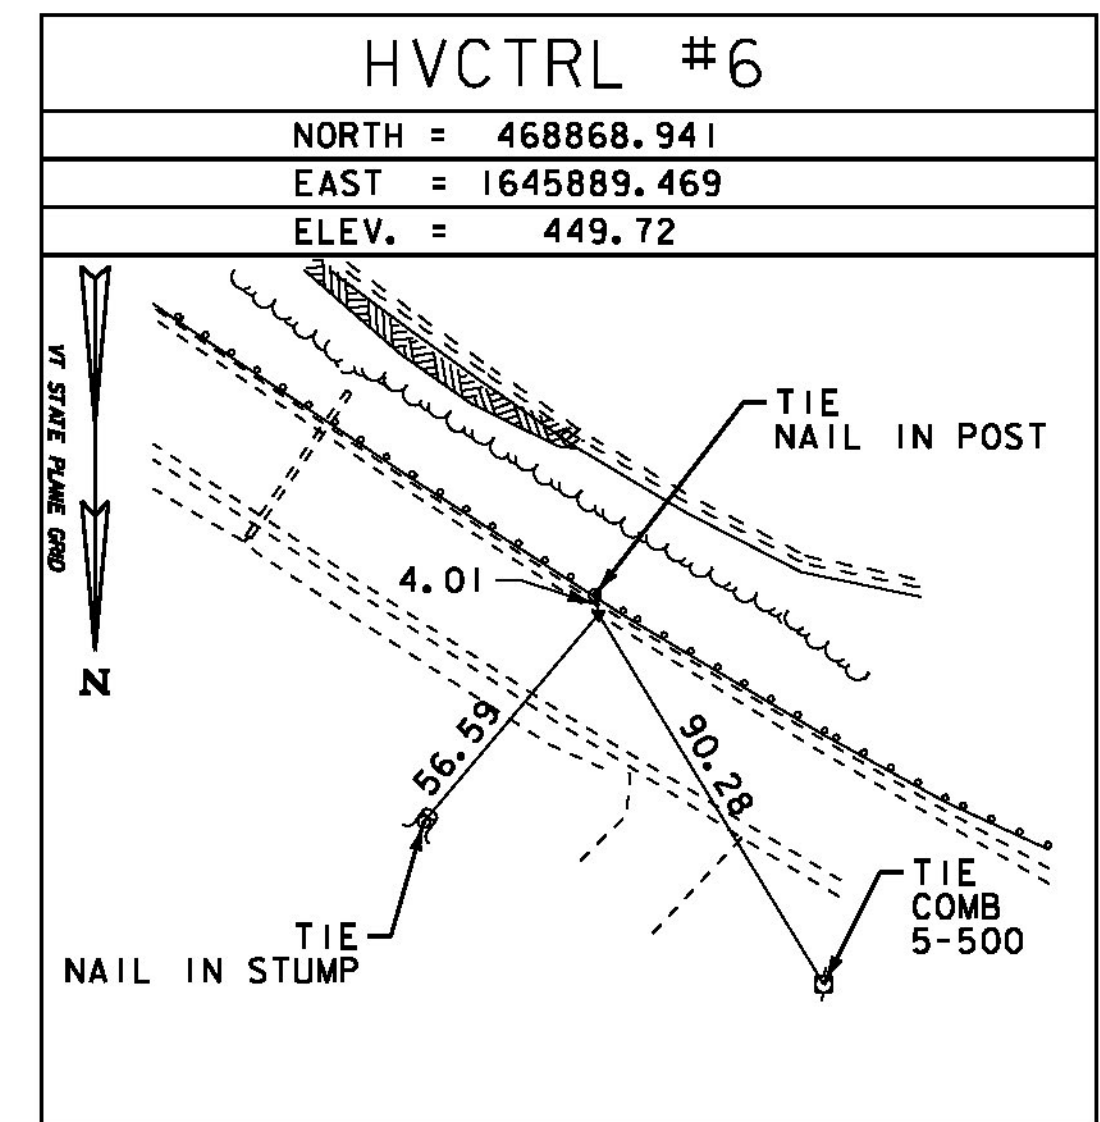
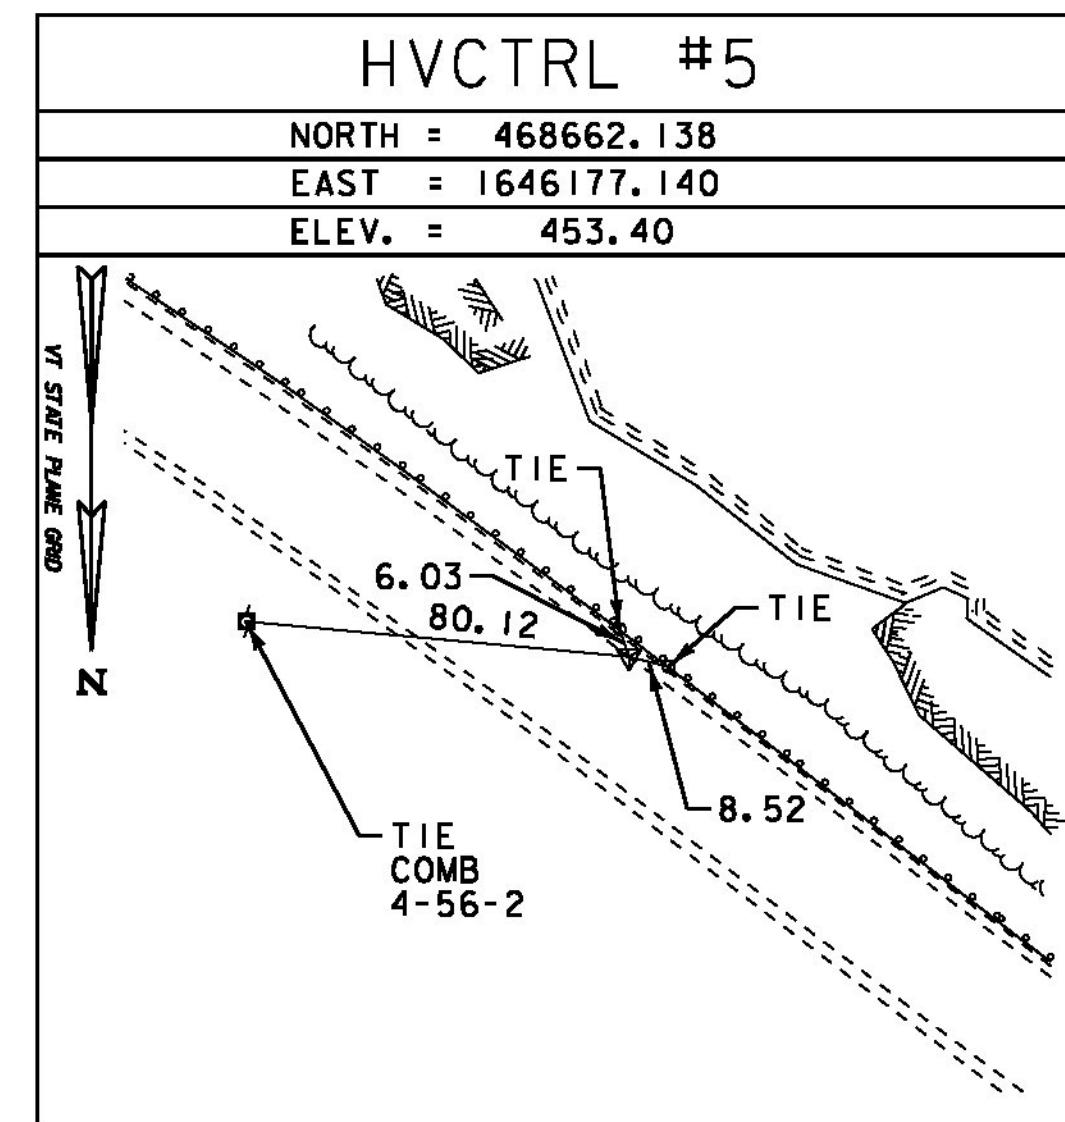
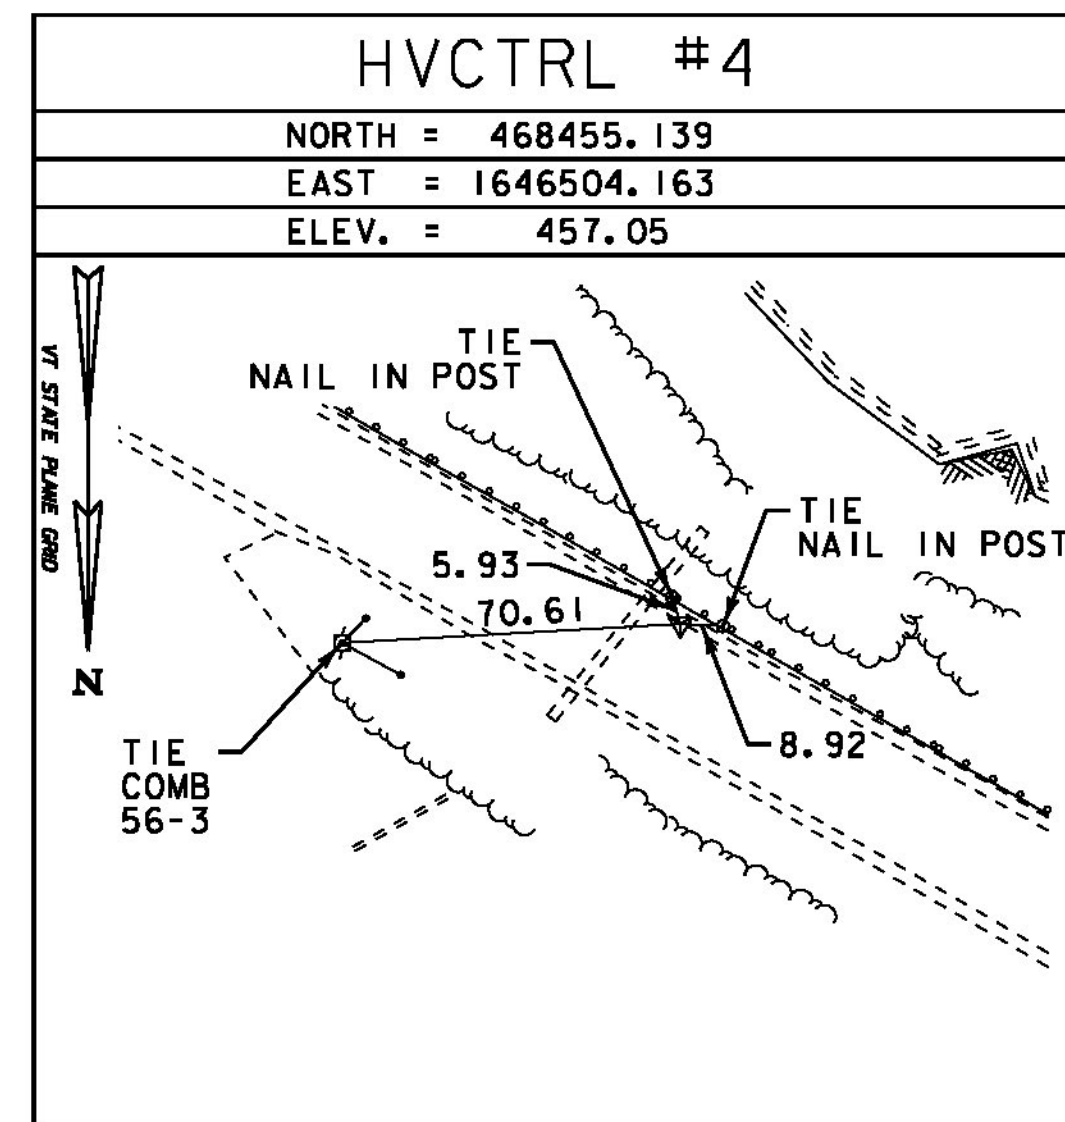
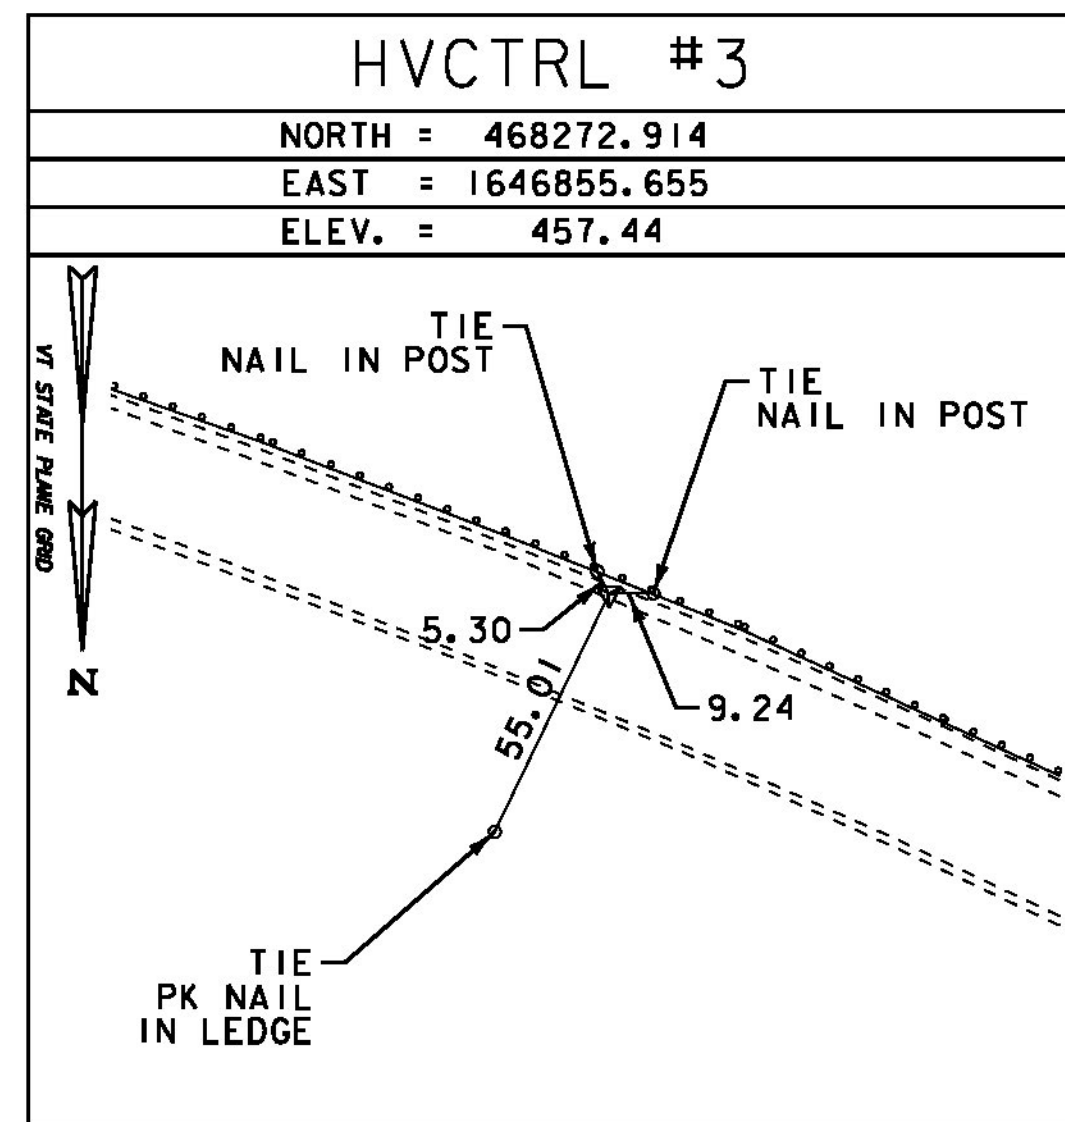







GPS CONTROL POINTS

NONE

TRAVERSE TIES

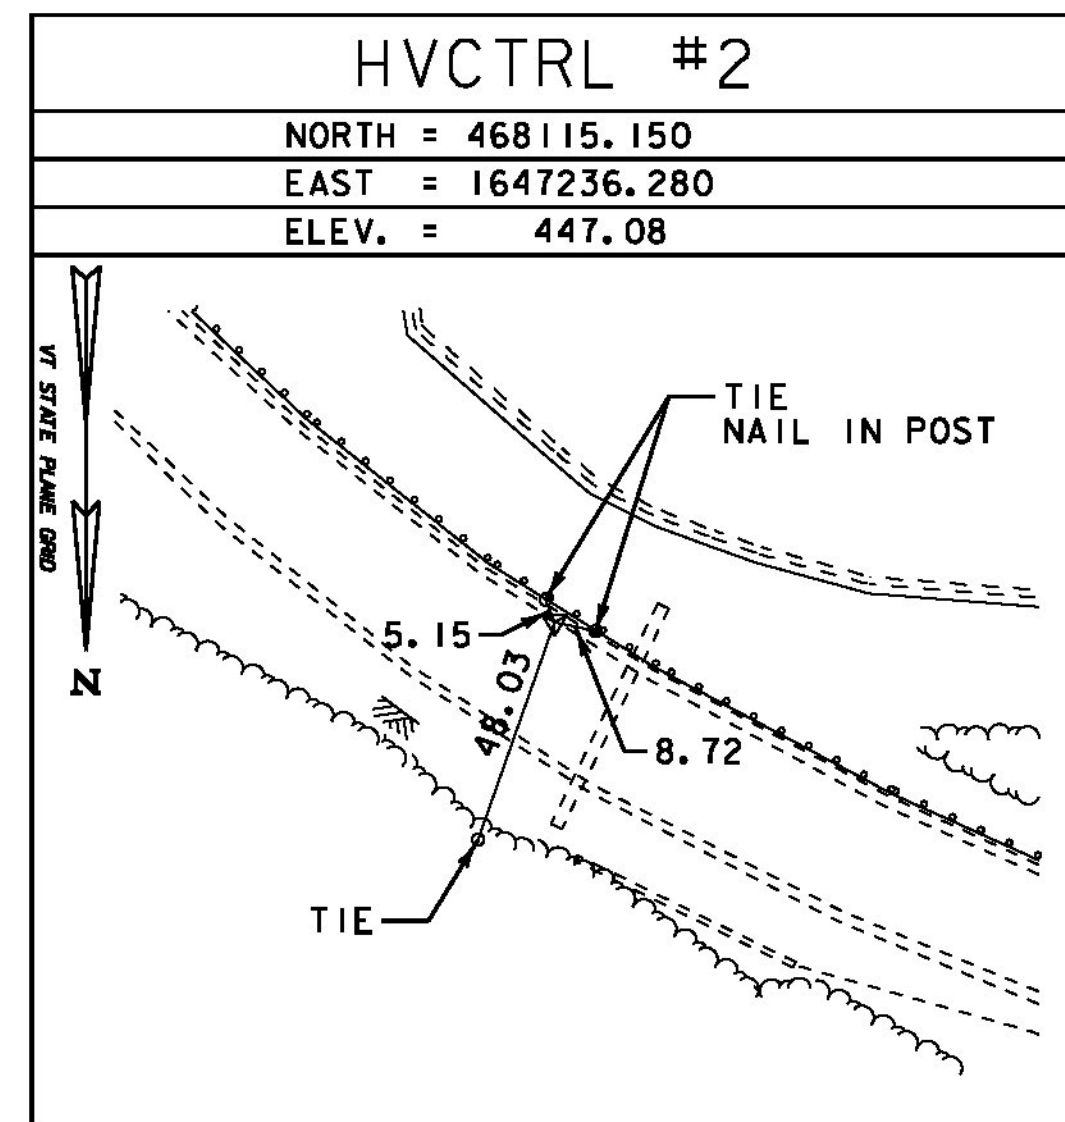

ALIGNMENT TIES

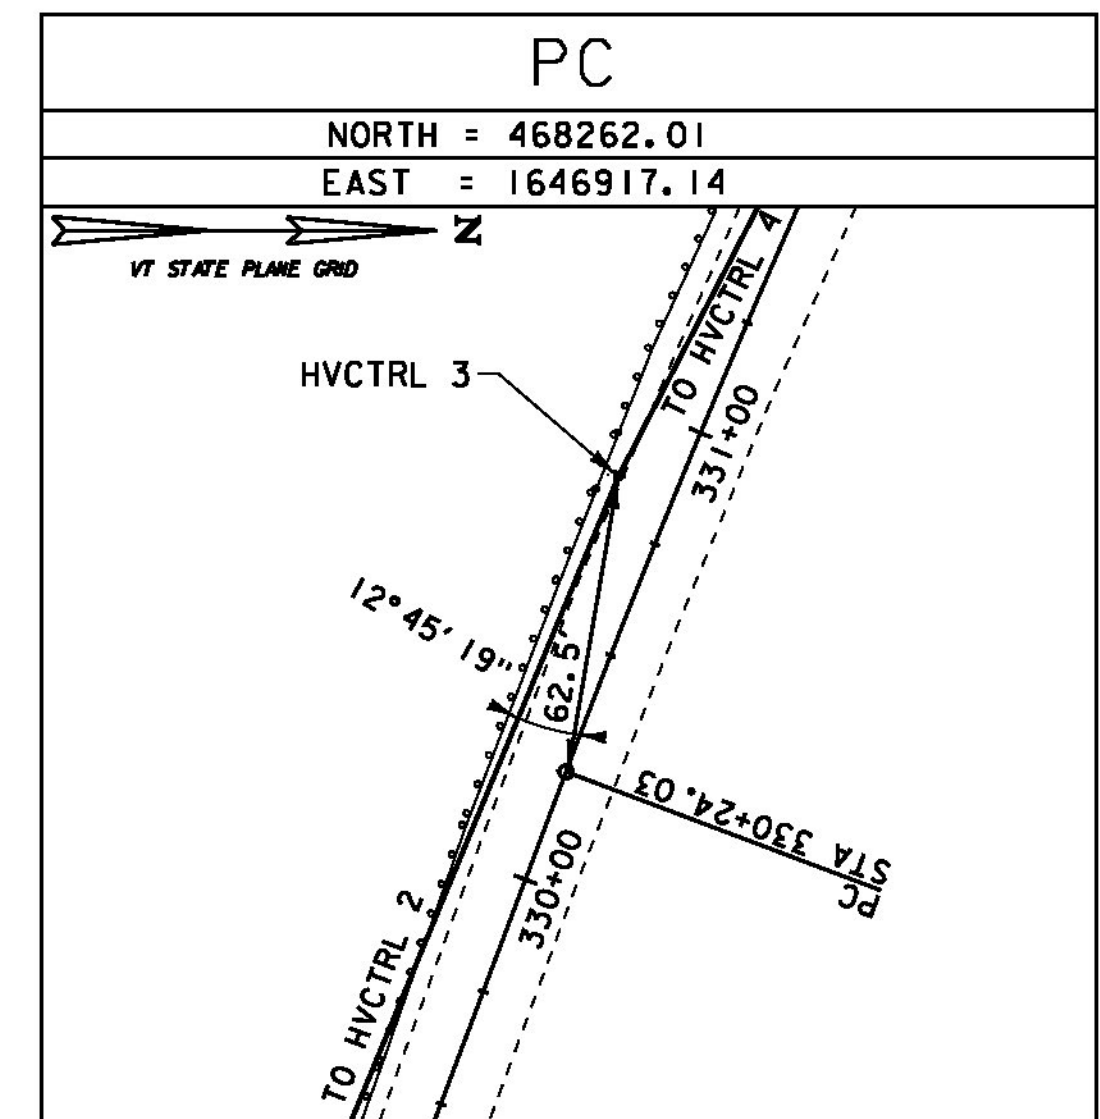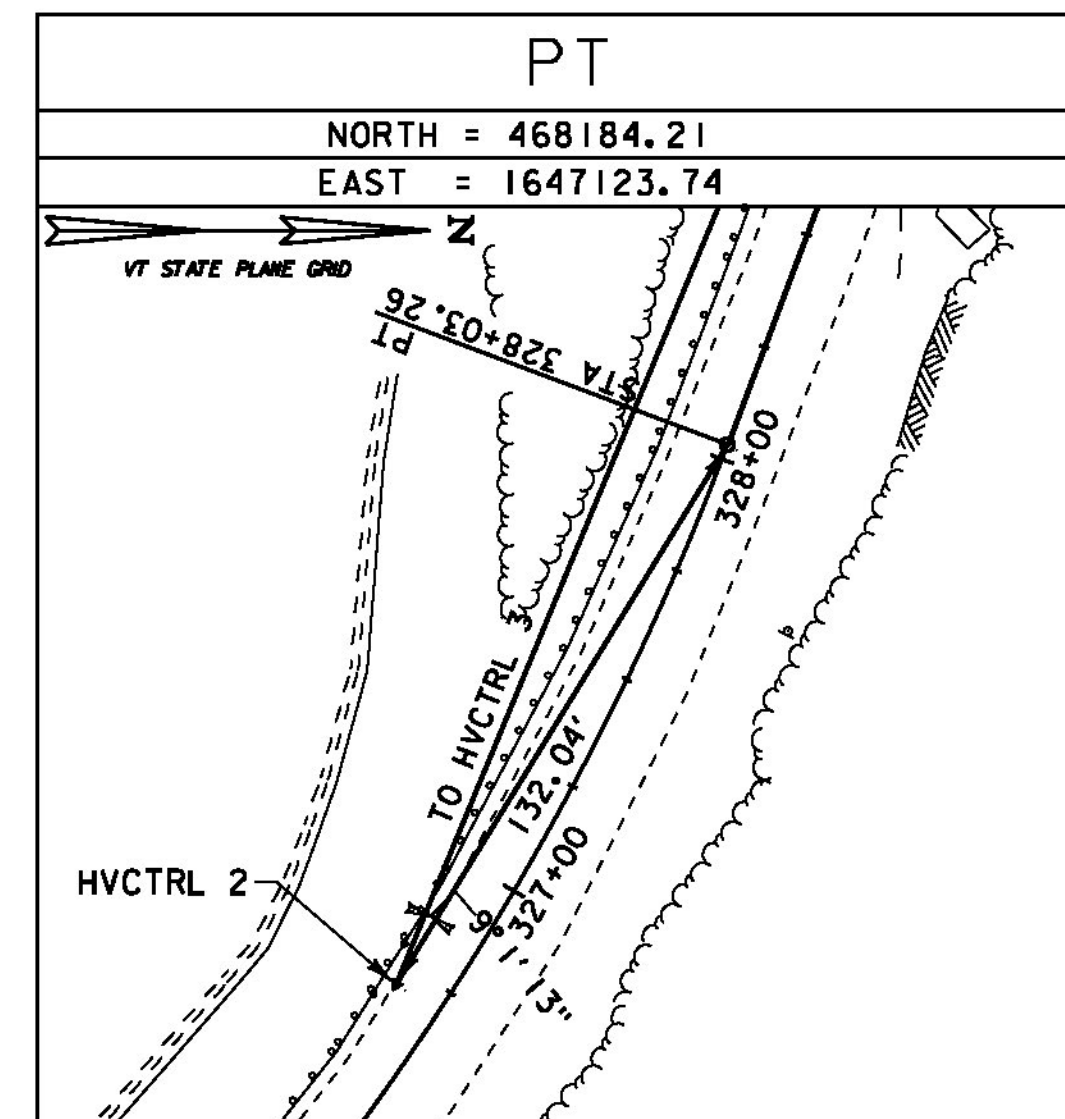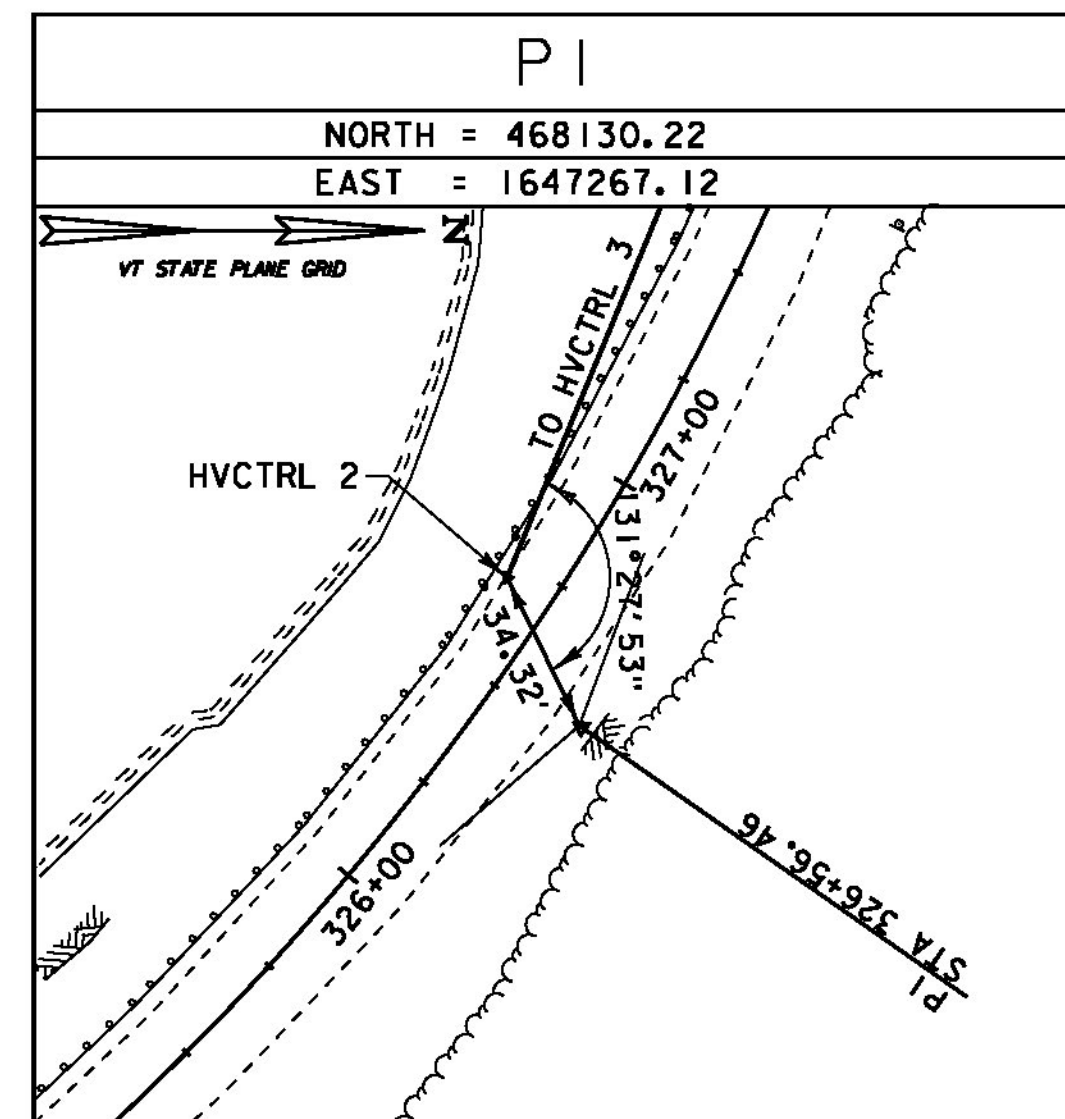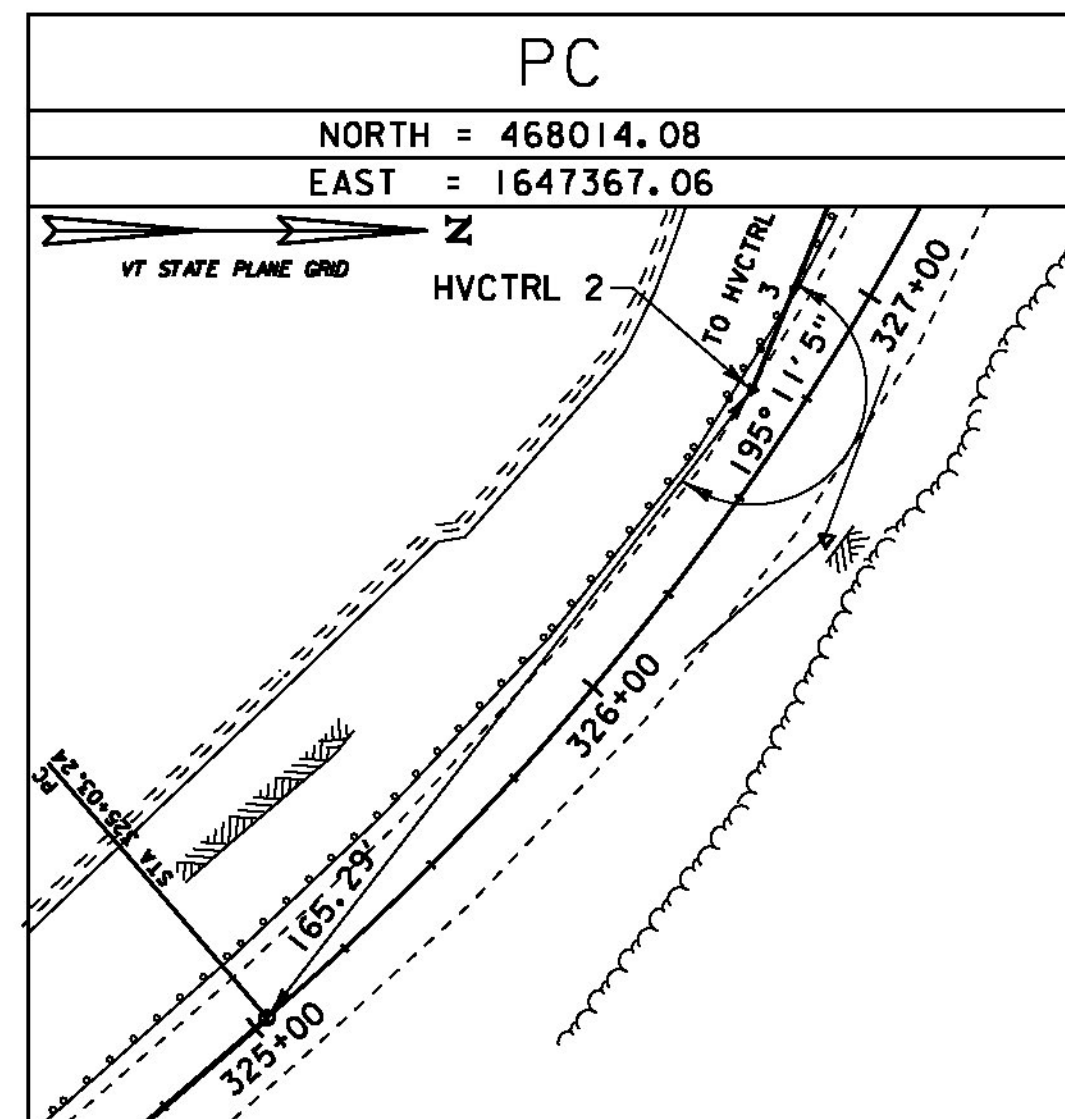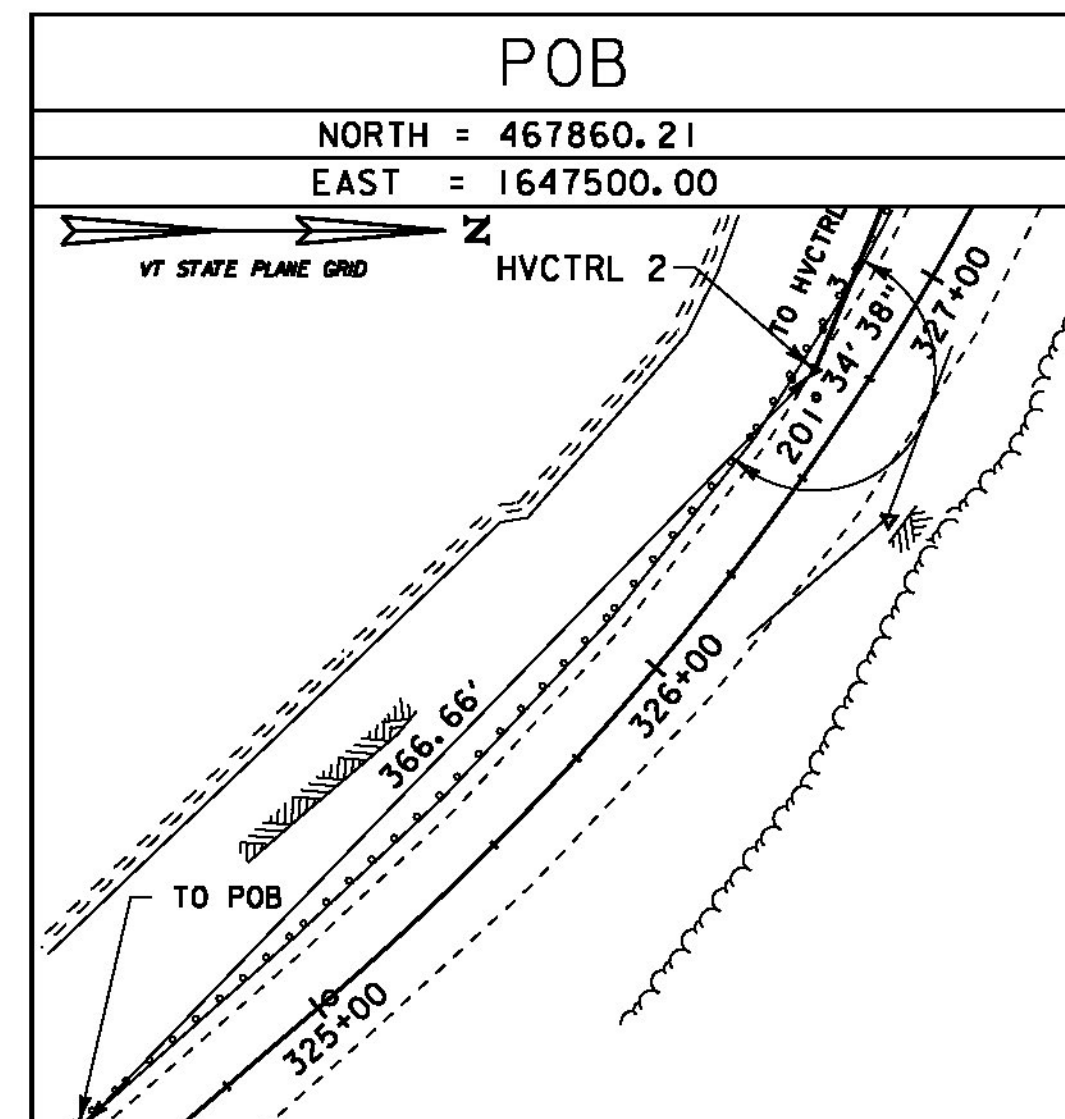

| | |
|------------|---------------|
| DATUM | |
| VERTICAL | NAVD 88 |
| HORIZONTAL | NAD 83 (2011) |
| ADJUSTMENT | NONE |



| | | | |
|-----------------|------------------|-------------|---------------|
| PROJECT NAME: | SHARON | PLOT DATE: | 3/31/2015 |
| PROJECT NUMBER: | ER STP 0147 (20) | DRAWN BY: | B. MACK |
| FILE NAME: | z12c410tie.dgn | CHECKED BY: | A. SANZ |
| PROJECT LEADER: | J. TUCKER | TIE SHEET 1 | SHEET 9 OF 66 |
| DESIGNED BY: | B. BRESLEND | | |