

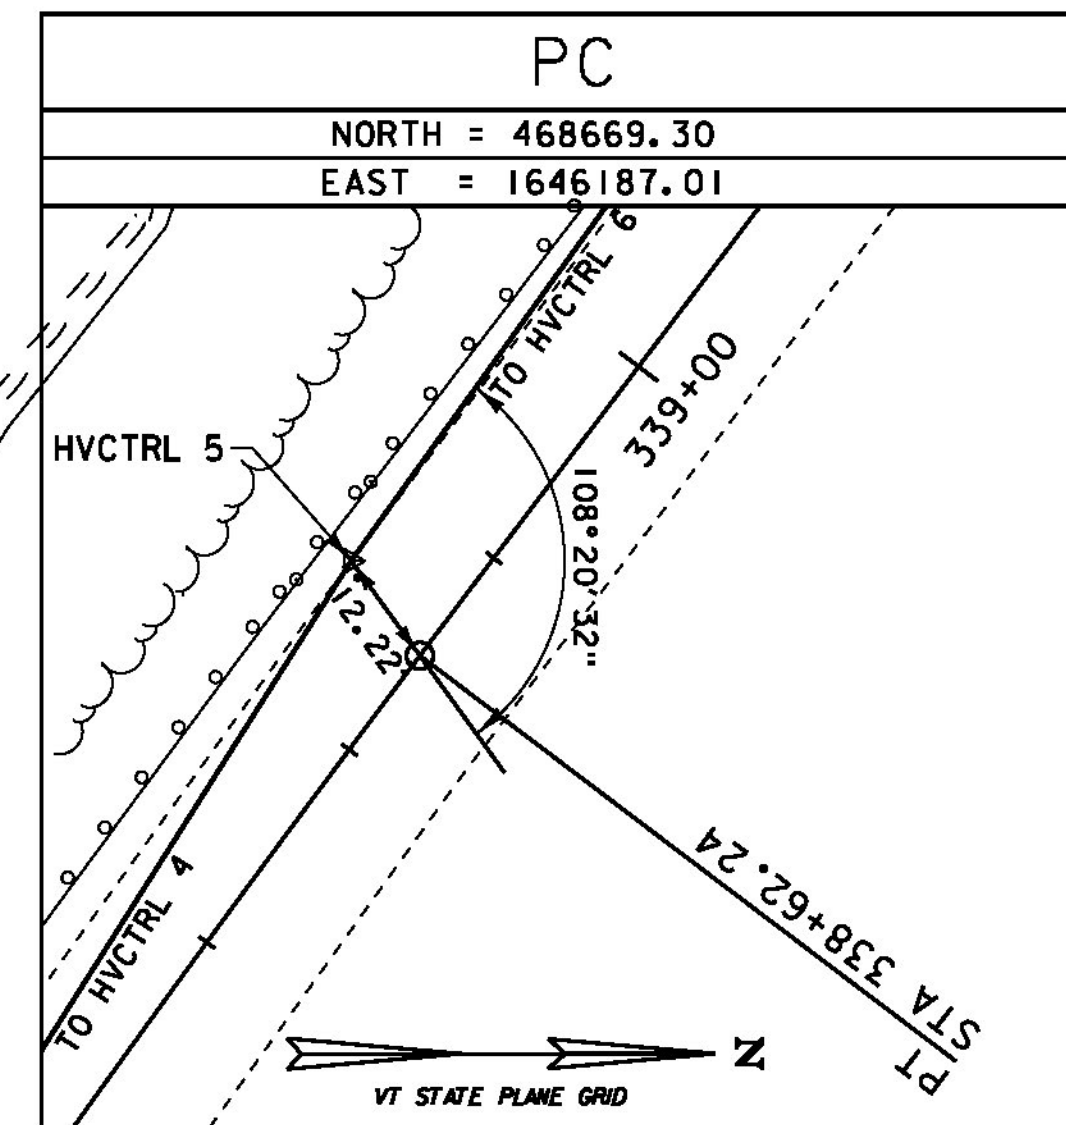
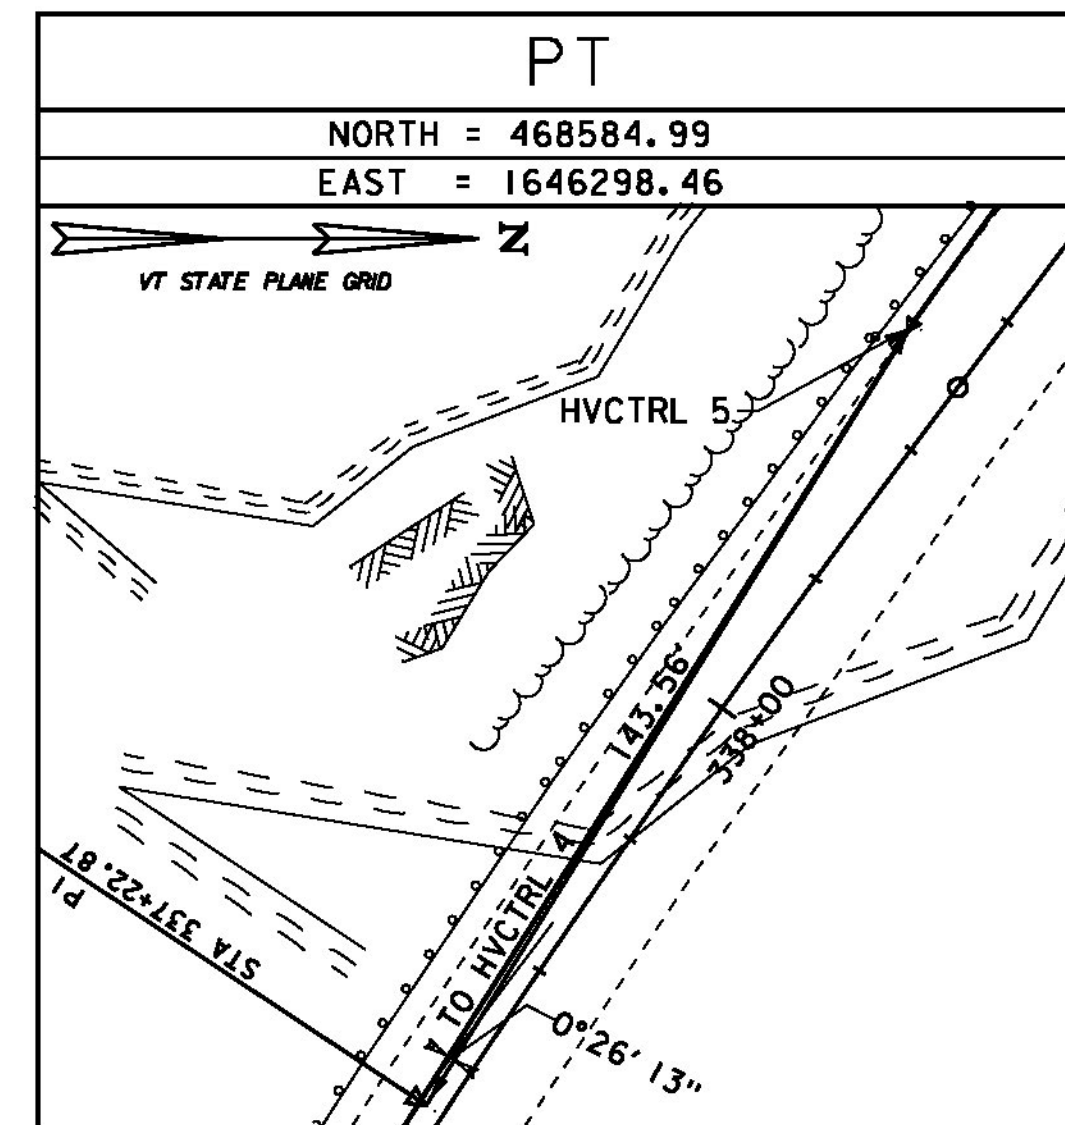
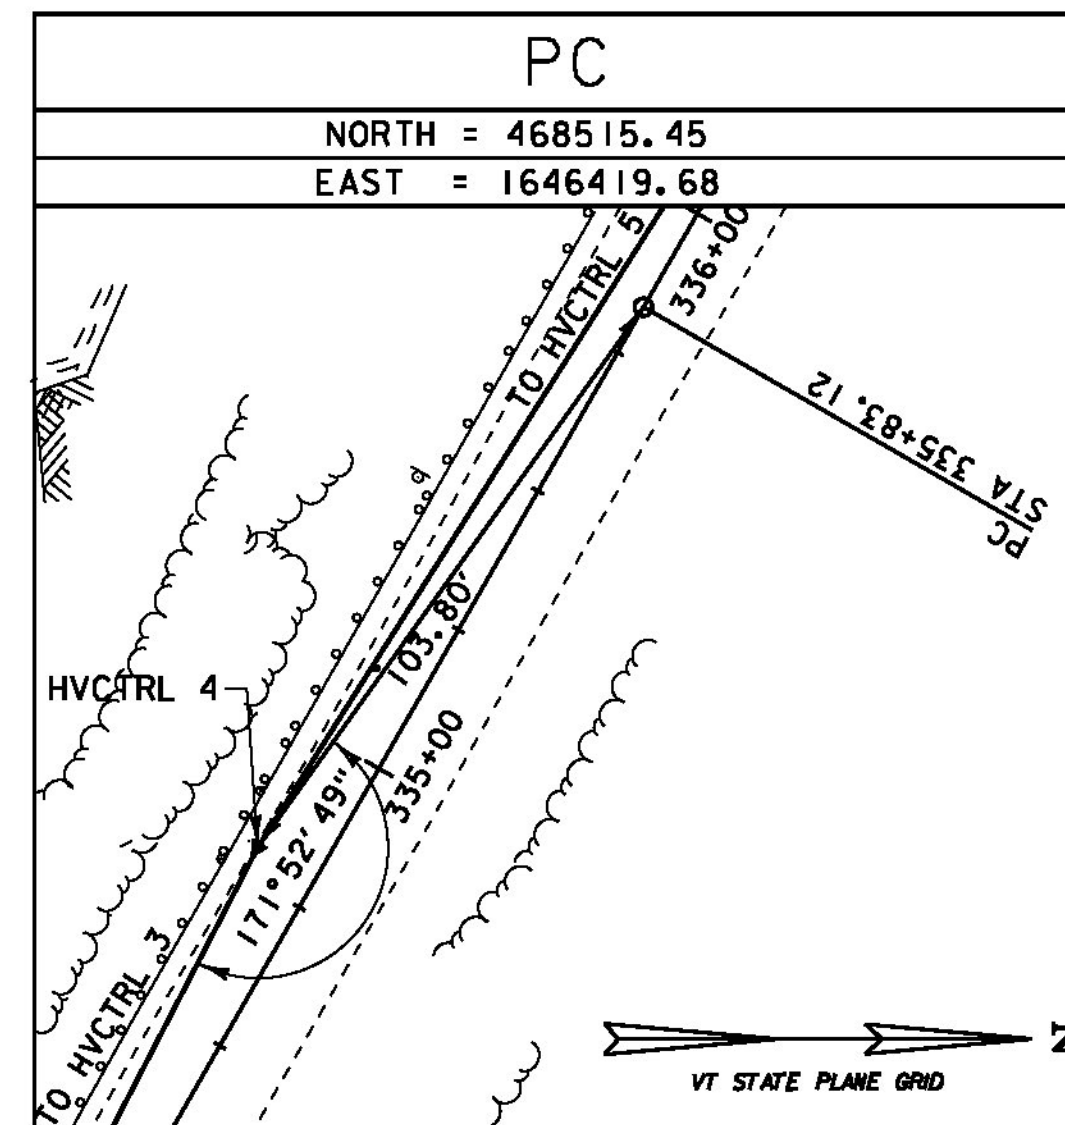
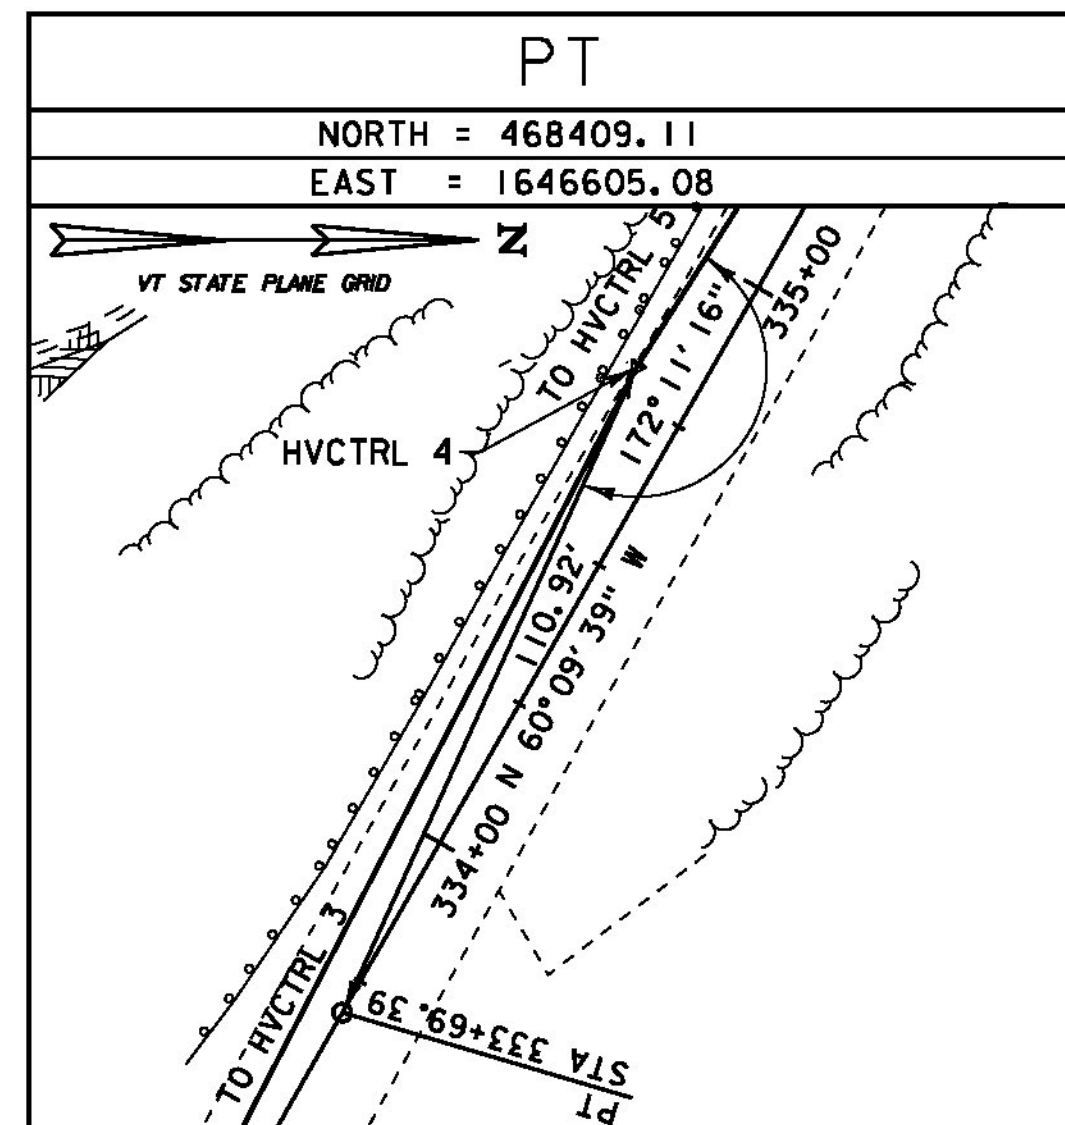
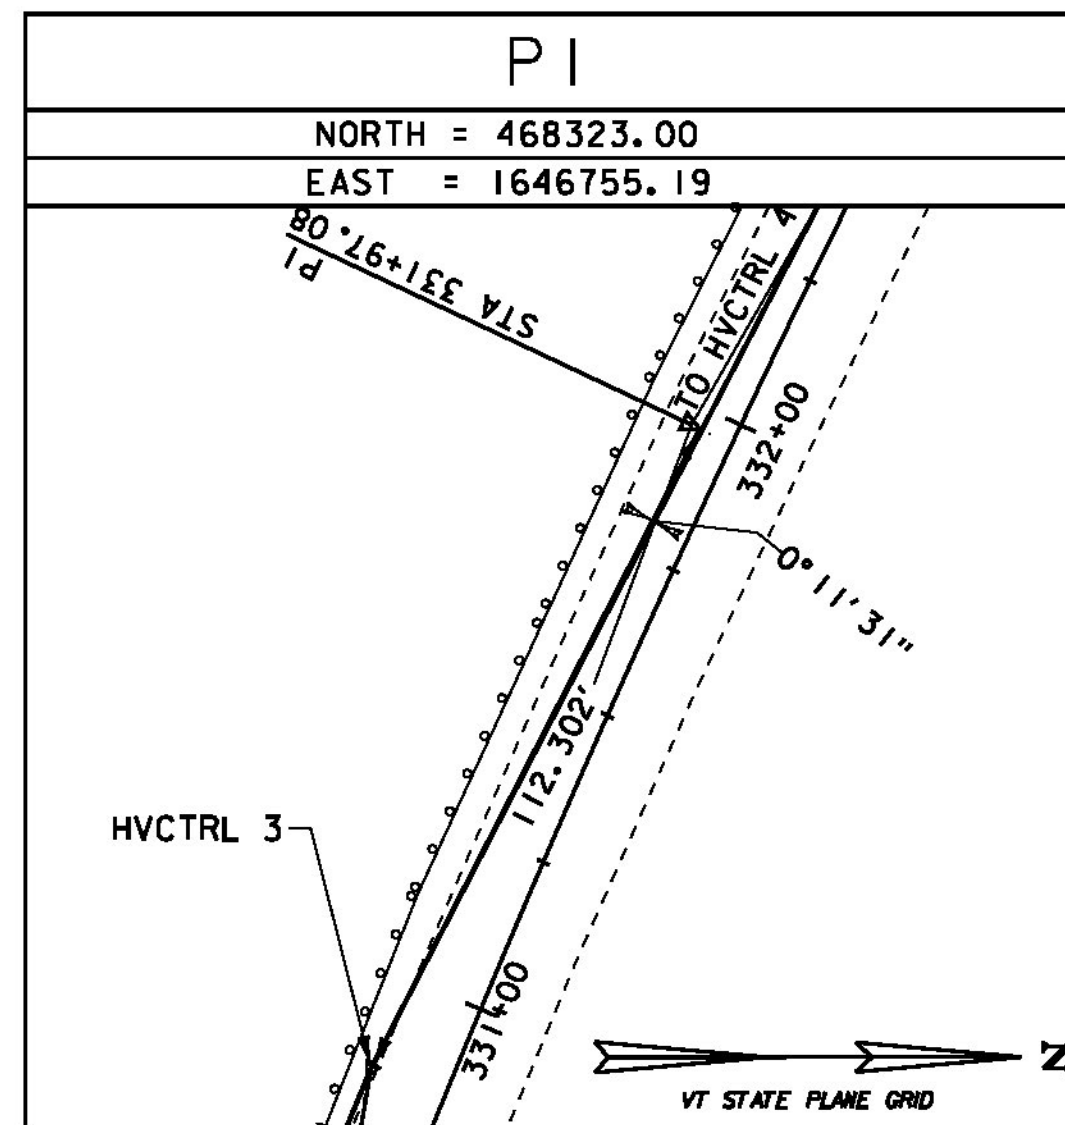
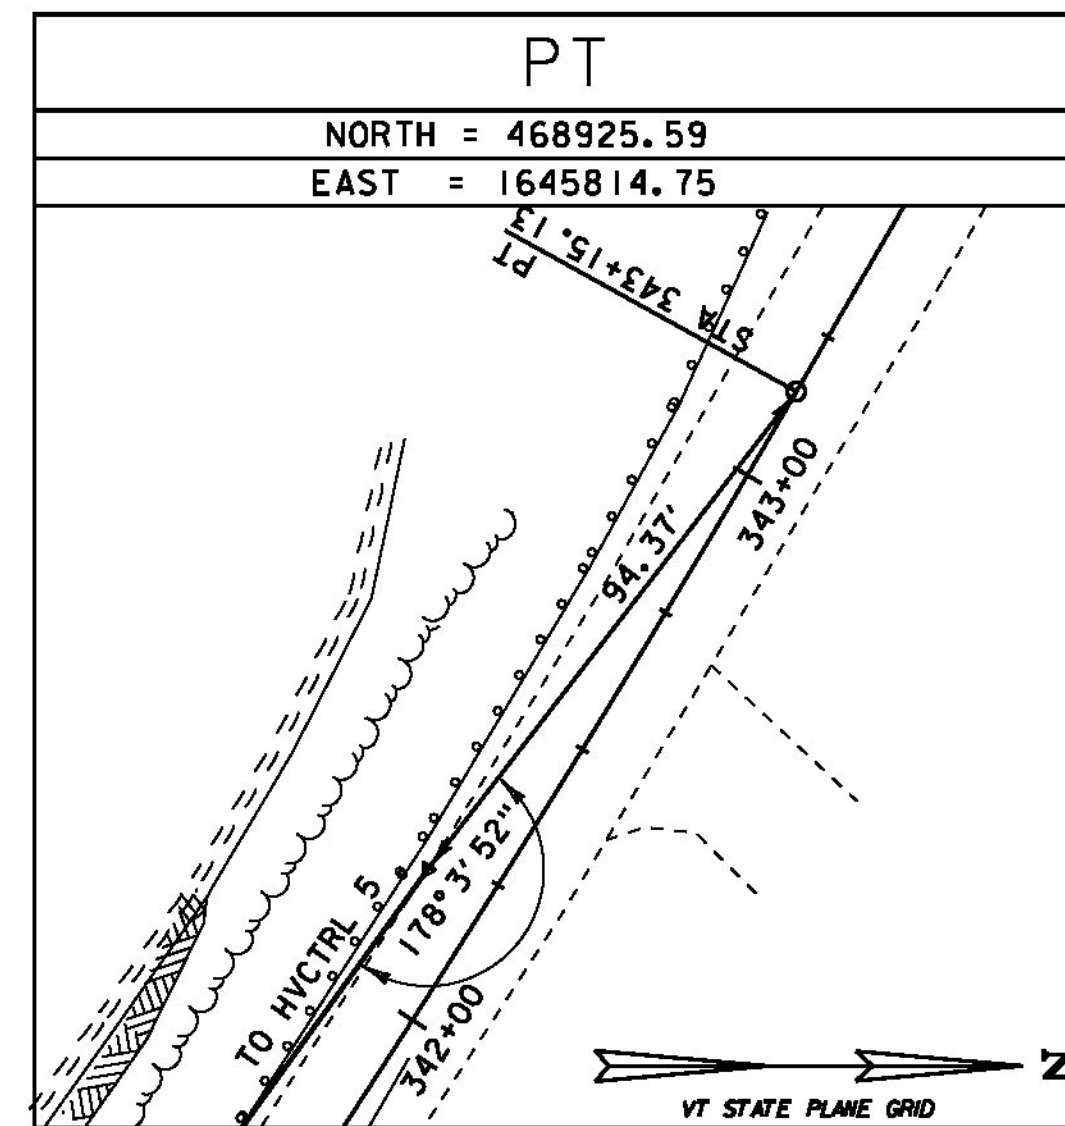


ALIGNMENT TIES

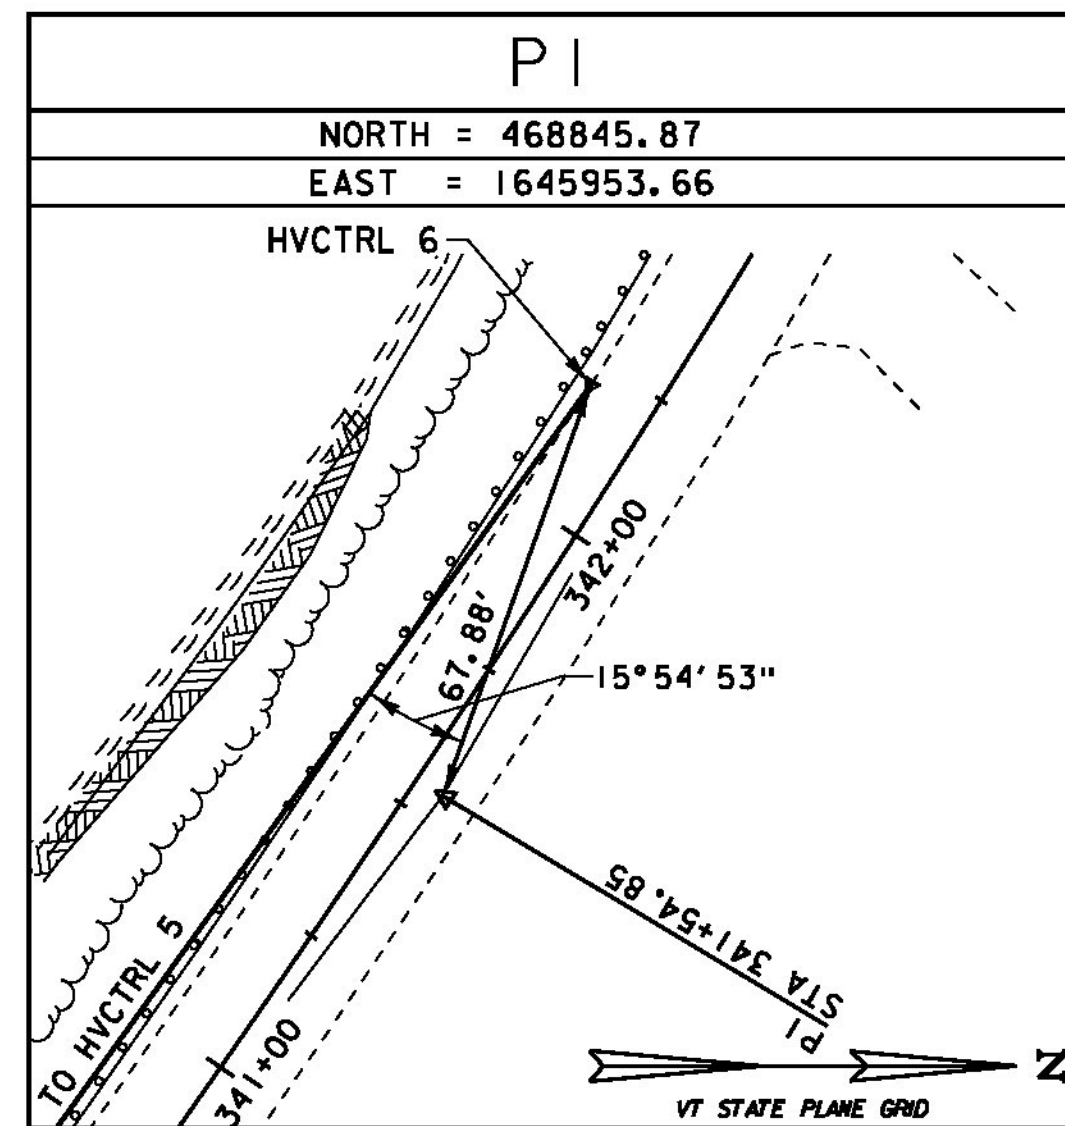


ALIGNMENT TIES

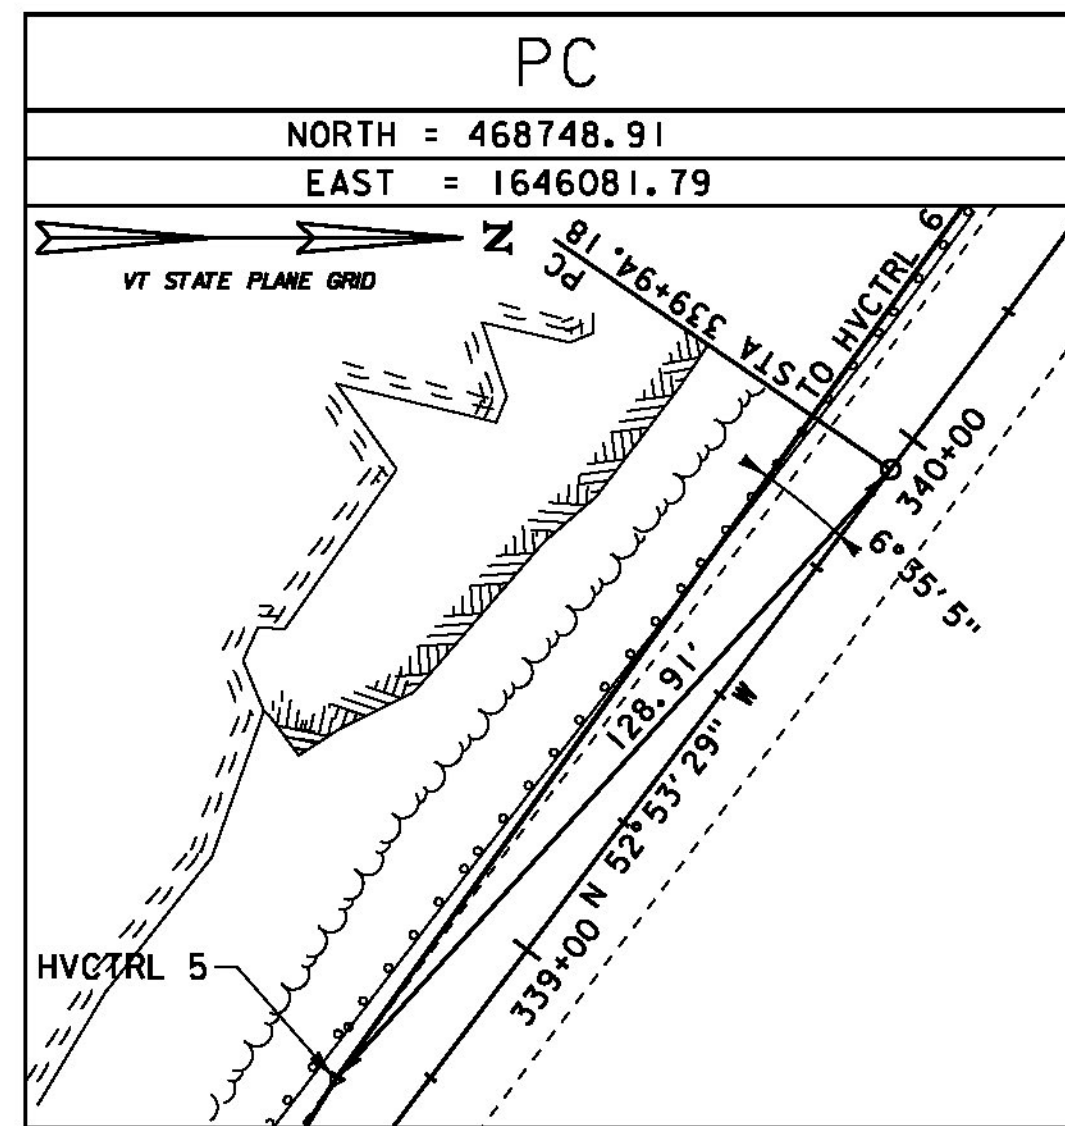

ALIGNMENT TIES

DATUM	
VERTICAL	NAVD 88
HORIZONTAL	NAD 83 (2011)
ADJUSTMENT	NONE

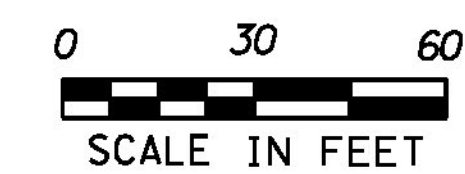

PROJECT NAME:	SHARON	PLOT DATE:	3/31/2015
PROJECT NUMBER:	ER STP 0147 (20)	DRAWN BY:	B. MACK
FILE NAME:	z12c410tie.dgn	CHECKED BY:	A. SANZ
PROJECT LEADER:	J. TUCKER	TIE SHEET	2
DESIGNED BY:	B. BRESLEND	SHEET	10 OF 66