


HVCTRL 2
 N: 468115.150
 E: 1647236.280
 ELEV. 447.08

SOIL INFORMATION:
 HINCKLEY SANDY LOAM
 K-FACTOR = 0.15/0.20, 0-8% SLOPES
 HYDROLOGIC SOIL GROUP: A

SOIL INFORMATION:
 TUNBRIDGE-LYMAN COMPLEX
 K-FACTOR = 0.22/0.27, 35-60% SLOPES
 HYDROLOGIC SOIL GROUP: C/D

MATCHLINE STA. 328+25 SEE NEXT SHEET

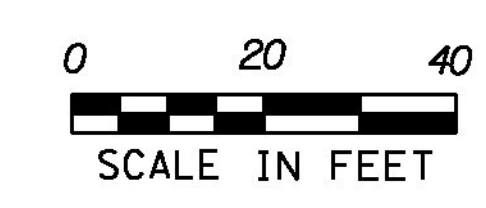

PROJECT NAME: SHARON	PLLOT DATE: 3/31/2015
PROJECT NUMBER: ER STP 0147 (20)	DRAWN BY: B. MACK
FILE NAME: z12c410EPSC_bdr.dgn	CHECKED BY: J. TUCKER
PROJECT LEADER: J. TUCKER	SHEET 35 OF 66
DESIGNED BY: B. BRESLEND	
EPSC EXISTING COND. PLAN SHEET 1	