


SOIL INFORMATION:  
 TUNBRIDGE-LYMAN COMPLEX  
 K-FACTOR = 0.22/0.27, 35=60% SLOPES  
 HYDROLOGIC SOIL GROUP: C/D

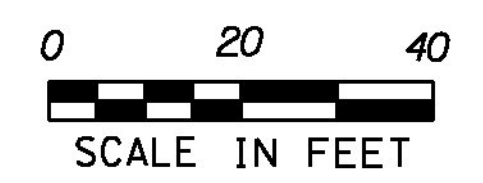

PROJECT NAME:	SHARON	FILE NAME:	z12c410EPSC_bdr.dgn	PLOT DATE:	3/31/2015
PROJECT NUMBER:	ER STP 0147 (20)	PROJECT LEADER:	J. TUCKER	DRAWN BY:	B. MACK
		DESIGNED BY:	B. BRESLEND	CHECKED BY:	J. TUCKER
		EPSC EXISTING COND.	PLAN SHEET 2	SHEET	36 OF 66