


MATCHLINE STA. 333+00 SEE PREVIOUS SHEET

MATCHLINE STA. 337+25 SEE NEXT SHEET

SOIL INFORMATION:  
 TUNBRIDGE-LYMAN COMPLEX  
 K-FACTOR = 0.22/0.27, 35=60% SLOPES  
 HYDROLOGIC SOIL GROUP: C/D

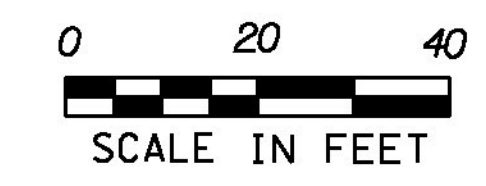

PROJECT NAME: SHARON	PROJECT NUMBER: ER STP 0147 (20)
FILE NAME: z12c410EPSC_bdr.dgn	PLOT DATE: 3/31/2015
PROJECT LEADER: J. TUCKER	DRAWN BY: B. MACK
DESIGNED BY: B. BRESLEND	CHECKED BY: J. TUCKER
EPSC EXISTING COND. PLAN SHEET 3	SHEET 37 OF 66