


- BARRIER FENCE**
- STA. 333+00.00 - STA. 333+16.00 RT
- STA. 333+00.00 - STA. 333+94.00 LT
- STA. 333+96.00 - STA. 337+25.00 RT
- STA. 335+34.00 - STA. 337+25.00 LT
- GEOTEXTILE FOR SILT FENCE, WOVEN WIRE REINFORCED**
- STA. 333+00.00 - STA. 334+00.00 LT
- STA. 335+44.00 - STA. 337+25.00 LT
- GEOTEXTILE FOR FILTER CURTAIN**
- STA. 333+90.00 - STA. 335+40.00 LT
- INLET PROTECTION DEVICE, TYPE I**
- STA. 334+65.00 RT
- TEMPORARY STONE CHECK DAM, TYPE I**
- STA. 335+00.00 - STA. 337+25.00 RT

- SEED**
- STA. 333+00.00 - STA. 333+05.00 LT
- STA. 333+00.00 - STA. 333+16.00 RT
- STA. 333+47.75 - STA. 337+25.00 LT
- STA. 333+95.50 - STA. 337+25.00 RT
- FERTILIZER**
- STA. 333+00.00 - STA. 333+05.00 LT
- STA. 333+00.00 - STA. 333+16.00 RT
- STA. 333+47.75 - STA. 337+25.00 LT
- STA. 333+95.50 - STA. 337+25.00 RT
- AGRICULTURAL LIMESTONE**
- STA. 333+00.00 - STA. 333+05.00 LT
- STA. 333+00.00 - STA. 333+16.00 RT
- STA. 333+47.75 - STA. 337+25.00 LT
- STA. 333+95.50 - STA. 337+25.00 RT
- TEMPORARY EROSION MATTING**
- STA. 333+00.00 - STA. 333+05.00 LT
- STA. 333+00.00 - STA. 333+16.00 RT
- STA. 333+47.75 - STA. 337+25.00 LT
- STA. 333+95.50 - STA. 337+25.00 RT

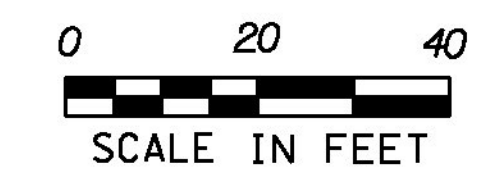

PROJECT NAME: SHARON	PLOT DATE: 3/31/2015
PROJECT NUMBER: ER STP 0147 (20)	DRAWN BY: B. MACK
FILE NAME: z12c410EPSC_bdr.dgn	CHECKED BY: J. TUCKER
PROJECT LEADER: J. TUCKER	SHEET 41 OF 66
DESIGNED BY: B. BRESLEND	
EPSC CONSTRUCTION PLANS SHEET 3	