


MATCHLINE STA. 333+00 SEE PREVIOUS SHEET

MATCHLINE STA. 337+25 SEE NEXT SHEET

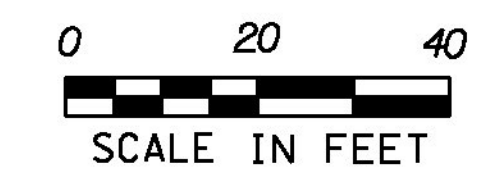

PROJECT NAME: SHARON	PLLOT DATE: 3/31/2015
PROJECT NUMBER: ER STP 0147 (20)	DRAWN BY: B. MACK
FILE NAME: z12c410EPSC_bdr.dgn	CHECKED BY: J. TUCKER
PROJECT LEADER: J. TUCKER	SHEET 45 OF 66
DESIGNED BY: B. BRESLEND	
EPSC FINAL CONDITIONS PLAN SHEET 3	