


331+00

332+00

331+00 - 332+50

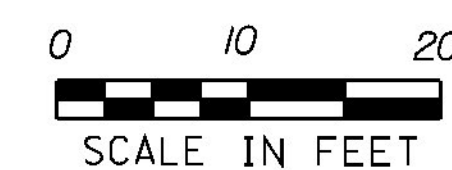

PROJECT NAME: SHARON	PLOT DATE: 3/31/2015
PROJECT NUMBER: ER STP 0147 (20)	DRAWN BY: B. MACK
FILE NAME: z12c410xs.dgn	CHECKED BY: A. SANZ
PROJECT LEADER: J. TUCKER	SHEET 55 OF 66
DESIGNED BY: B. BRESLEND	
VT 14 CROSS SECTION SHEET 5	