


343+00

STA. 343+00
 END APPROACH
 MATCH EXISTING

343+00 - 343+00

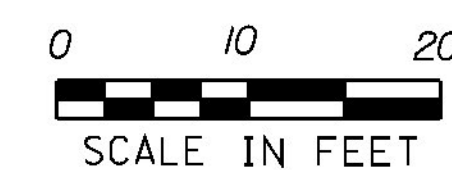

PROJECT NAME: SHARON	PROJECT NUMBER: ER STP 0147 (20)
FILE NAME: z12c410xs.dgn	PLOT DATE: 3/31/2015
PROJECT LEADER: J. TUCKER	DRAWN BY: B. MACK
DESIGNED BY: B. BRESLEND	CHECKED BY: A. SANZ
VT 14 CROSS SECTION SHEET 11	SHEET 61 OF 66