


5 STA. 341+51.13 RT 21' TO
 STA. 341+52.08 LT 29'
 REPLACE EXISTING 15" RCP
 WITH NEW 24" CPEP (SL)
 LENGTH = 50'-0"
 INV. IN = 447.89'
 INV. OUT = 442.96'
 ASKEW ANGLE = 83.9°LT
 CONSTRUCT INLET PROTECTION PAD
 STONE FILL, TYPE I

341+52
 CULVERT #5

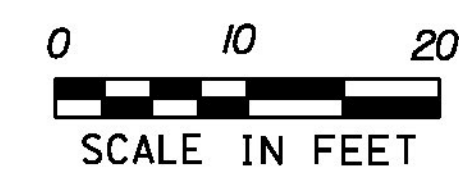

PROJECT NAME: SHARON
 PROJECT NUMBER: ER STP 0147 (20)

FILE NAME: z12c410culvert.txs.dgn PLOT DATE: 3/31/2015
 PROJECT LEADER: J. TUCKER DRAWN BY: B. MACK
 DESIGNED BY: B. BRESLEND CHECKED BY: A. SANZ
 VT14 CULVERT CROSS SECTION SHEET 2 SHEET 63 OF 66