


ROADWAY TYPICAL SECTION
 NOT TO SCALE
 STA. 257+25.00 TO STA. 258+25.00

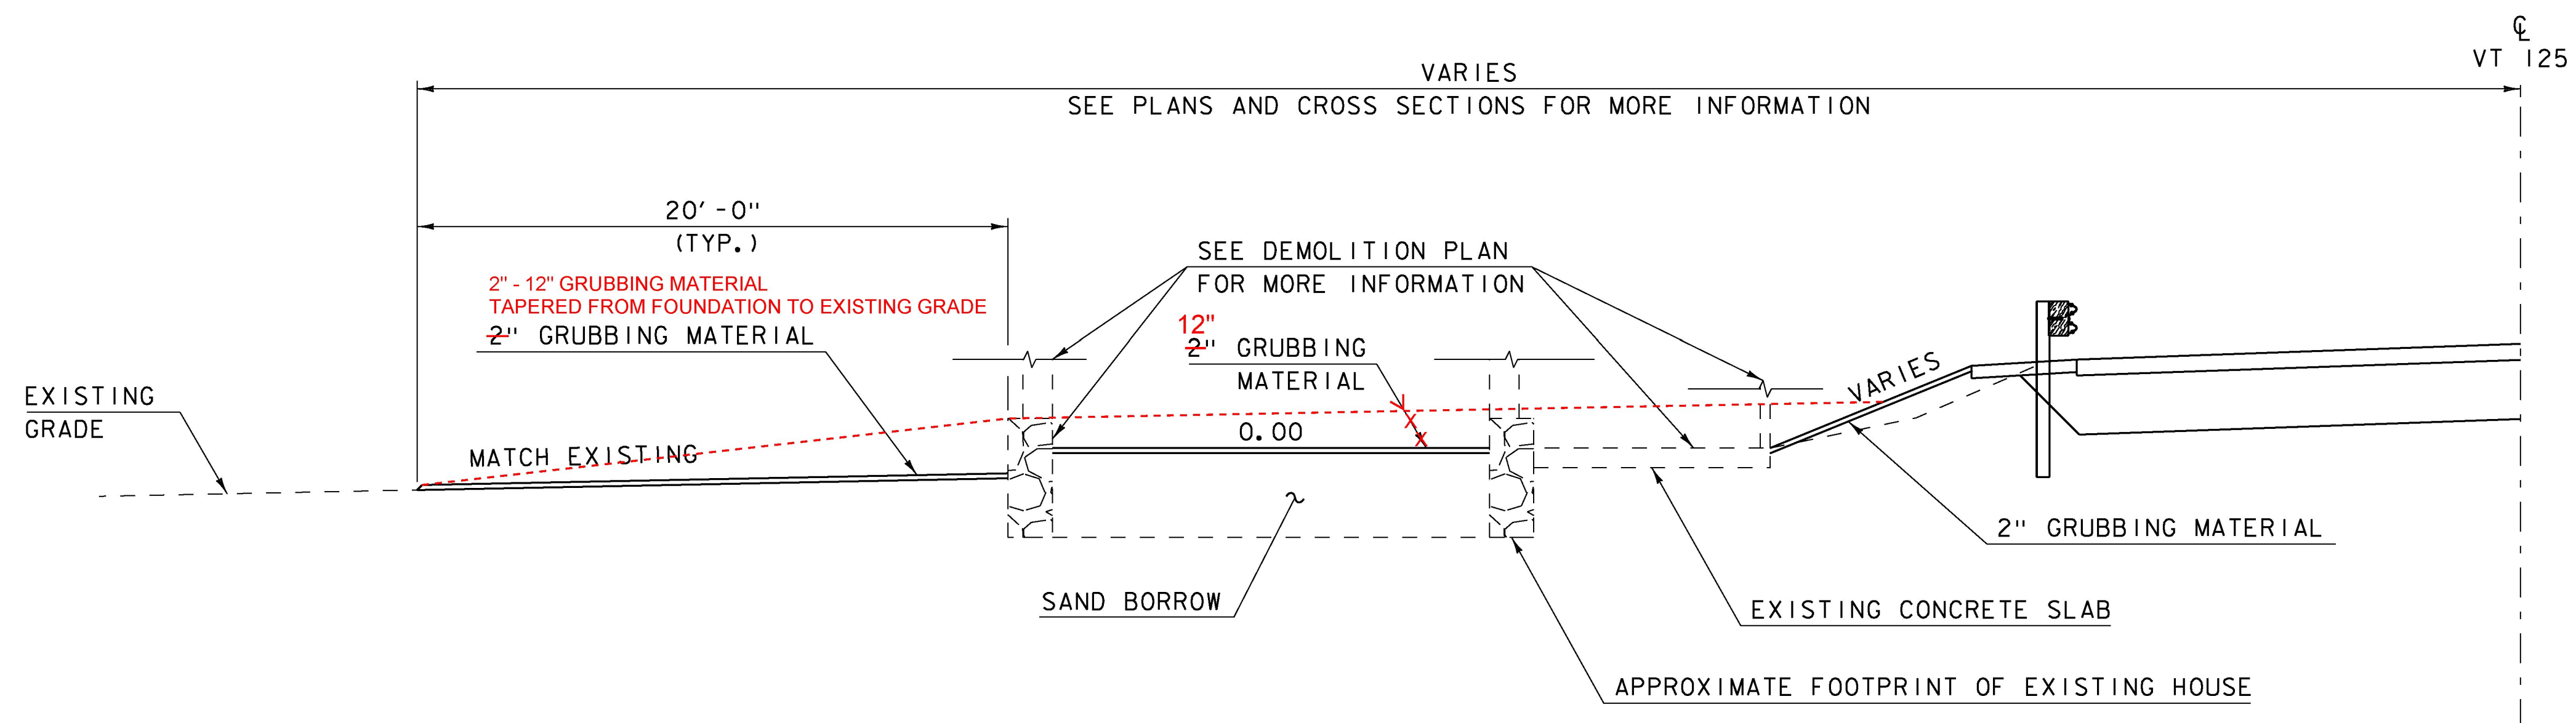

SITE TYPICAL SECTION
 NOT TO SCALE
 STA. 256+50.00 TO STA. 257+80.00

TOLERANCES :
 PAVEMENT : +/- 1/4" (TOTAL PAVEMENT THICKNESS)
 SUBBASE : +/- 1" (TOTAL CRUSHED STONE THICKNESS)

REV	DATE	DESCRIPTION
△	12/5/16	PAY ITEM CHANGE
△	12/5/16	PAY ITEM CHANGE

PROJECT NAME: HANCOCK	
PROJECT NUMBER: ER STP 0174(18)	
FILE NAME: z12c412typ.dgn	PLOT DATE: 10/11/2016
PROJECT LEADER: J. TUCKER	DRAWN BY: O. DALMER
DESIGNED BY: B. BRESLEND	CHECKED BY: P. BERO
TYPICAL SECTION SHEET 1	SHEET 4 OF 42