


**TRANSITION AREA FOR GRAVEL SIDE ROADS**

HANCOCK  
LEGAL TOWN TRAIL STA. 257+00 RT  
TH17 STA. 257+95 RT

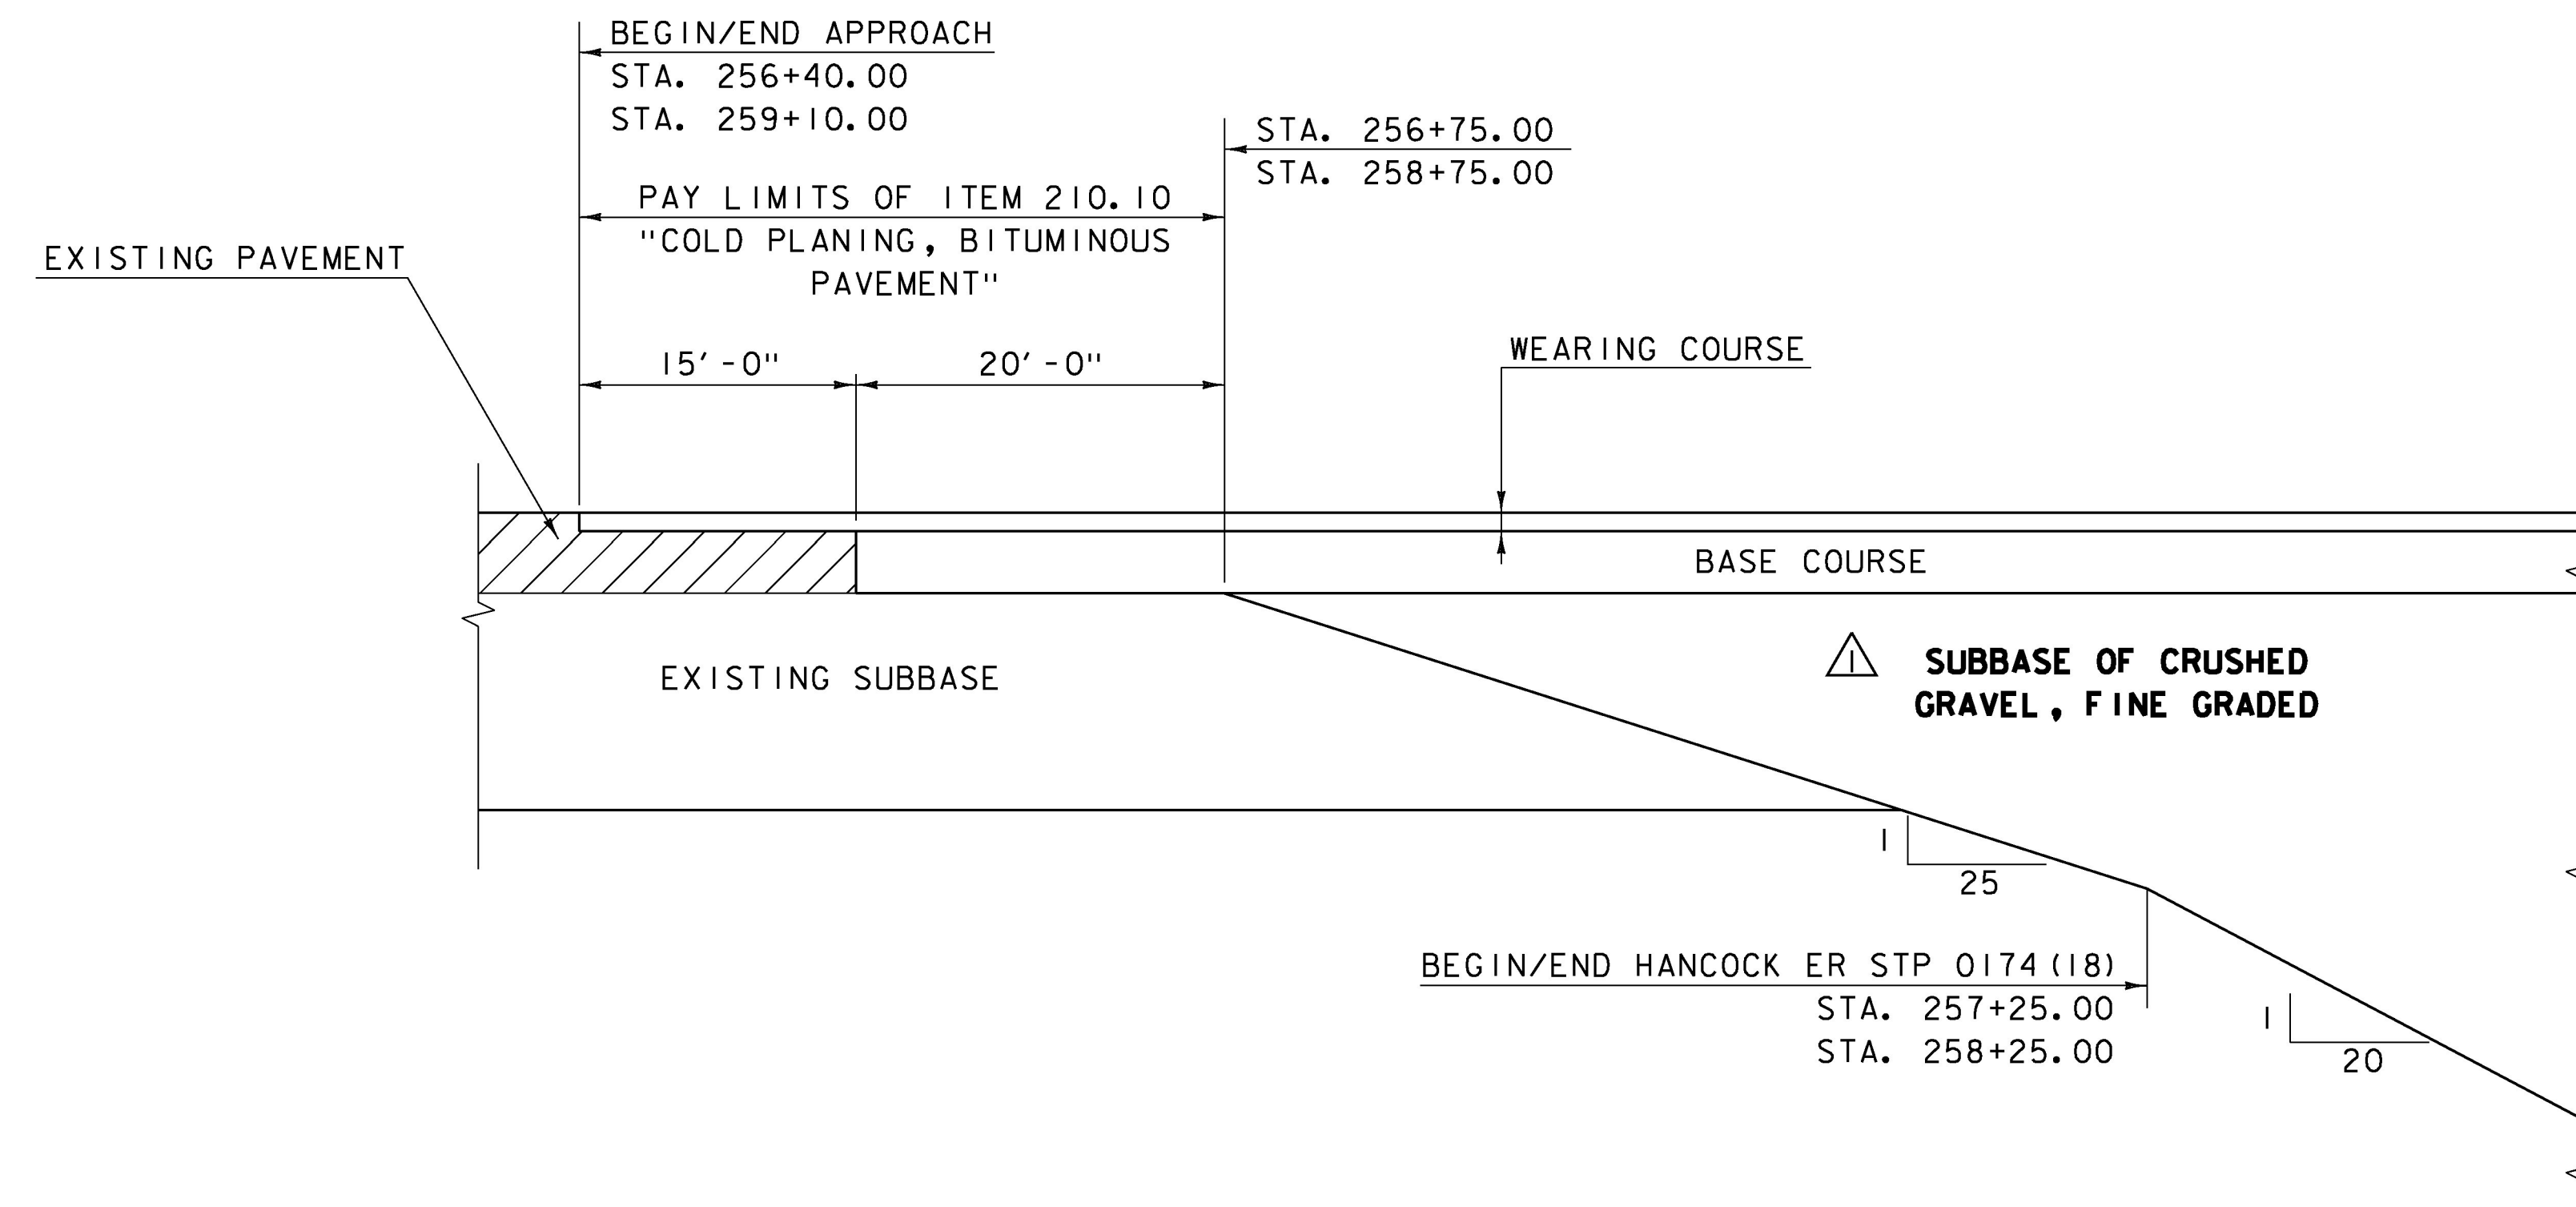

**MATERIAL TRANSITION DETAIL**

NOT TO SCALE

REV	DATE	DESCRIPTION
△	12/5/16	PAY ITEM CHANGE

PROJECT NAME: HANCOCK	
PROJECT NUMBER: ER STP 0174(18)	
FILE NAME: z12c412detail.dgn	PLOT DATE: 10/11/2016
PROJECT LEADER: J. TUCKER	DRAWN BY: O. DALMER
DESIGNED BY: B. BRESLEND	CHECKED BY: P. BERO
DETAIL SHEET	SHEET 6 OF 42