
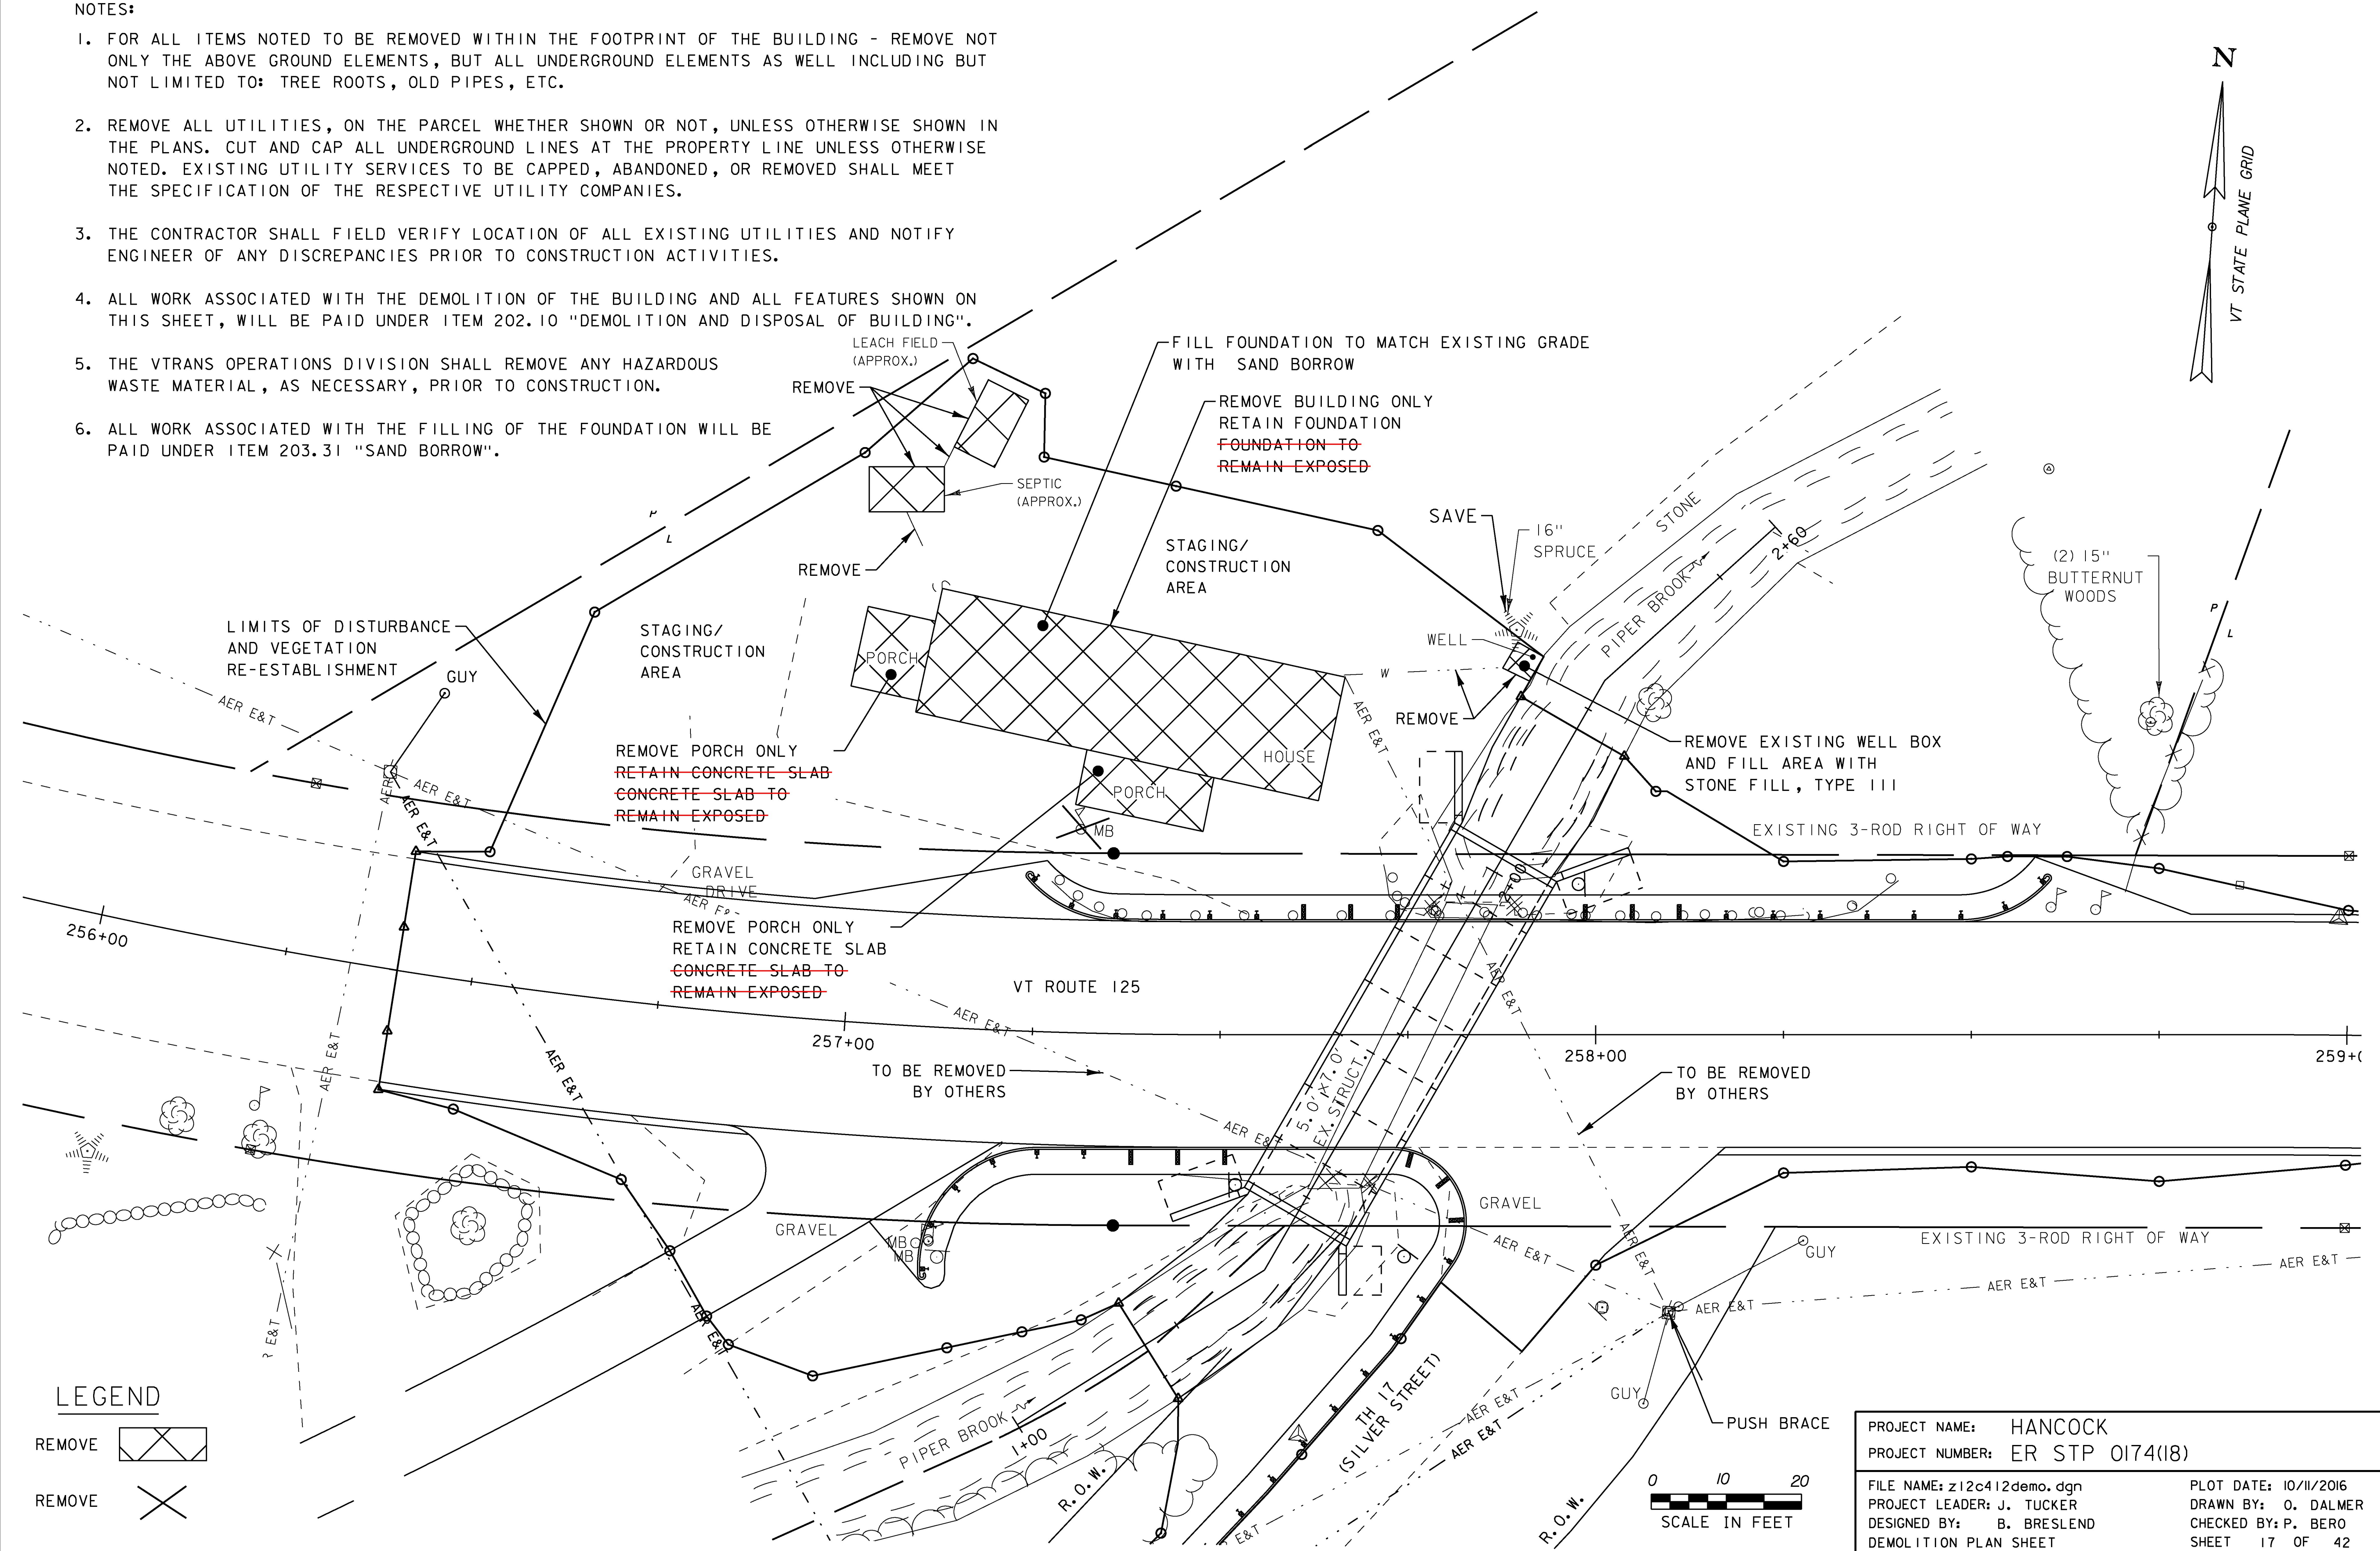


NOTES:

- FOR ALL ITEMS NOTED TO BE REMOVED WITHIN THE FOOTPRINT OF THE BUILDING - REMOVE NOT ONLY THE ABOVE GROUND ELEMENTS, BUT ALL UNDERGROUND ELEMENTS AS WELL INCLUDING BUT NOT LIMITED TO: TREE ROOTS, OLD PIPES, ETC.
- REMOVE ALL UTILITIES, ON THE PARCEL WHETHER SHOWN OR NOT, UNLESS OTHERWISE SHOWN IN THE PLANS. CUT AND CAP ALL UNDERGROUND LINES AT THE PROPERTY LINE UNLESS OTHERWISE NOTED. EXISTING UTILITY SERVICES TO BE CAPPED, ABANDONED, OR REMOVED SHALL MEET THE SPECIFICATION OF THE RESPECTIVE UTILITY COMPANIES.
- THE CONTRACTOR SHALL FIELD VERIFY LOCATION OF ALL EXISTING UTILITIES AND NOTIFY ENGINEER OF ANY DISCREPANCIES PRIOR TO CONSTRUCTION ACTIVITIES.
- ALL WORK ASSOCIATED WITH THE DEMOLITION OF THE BUILDING AND ALL FEATURES SHOWN ON THIS SHEET, WILL BE PAID UNDER ITEM 202.10 "DEMOLITION AND DISPOSAL OF BUILDING".
- THE VTRANS OPERATIONS DIVISION SHALL REMOVE ANY HAZARDOUS WASTE MATERIAL, AS NECESSARY, PRIOR TO CONSTRUCTION.
- ALL WORK ASSOCIATED WITH THE FILLING OF THE FOUNDATION WILL BE PAID UNDER ITEM 203.31 "SAND BORROW".

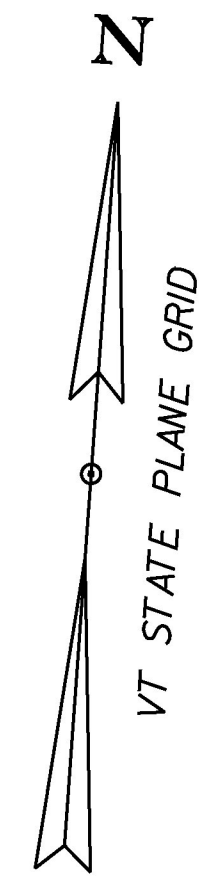

LEGEND

- REMOVE [Cross-hatch symbol]
- REMOVE [X symbol]

PROJECT NAME:	HANCOCK	PLOT DATE:	10/11/2016
PROJECT NUMBER:	ER STP 0174(18)	DRAWN BY:	O. DALMER
FILE NAME:	z12c412demo.dgn	DESIGNED BY:	B. BRESLEND
PROJECT LEADER:	J. TUCKER	CHECKED BY:	P. BERO
DEMOLITION PLAN SHEET			SHEET 17 OF 42