


PLAN

SCALE: 1/4" = 1'-0"

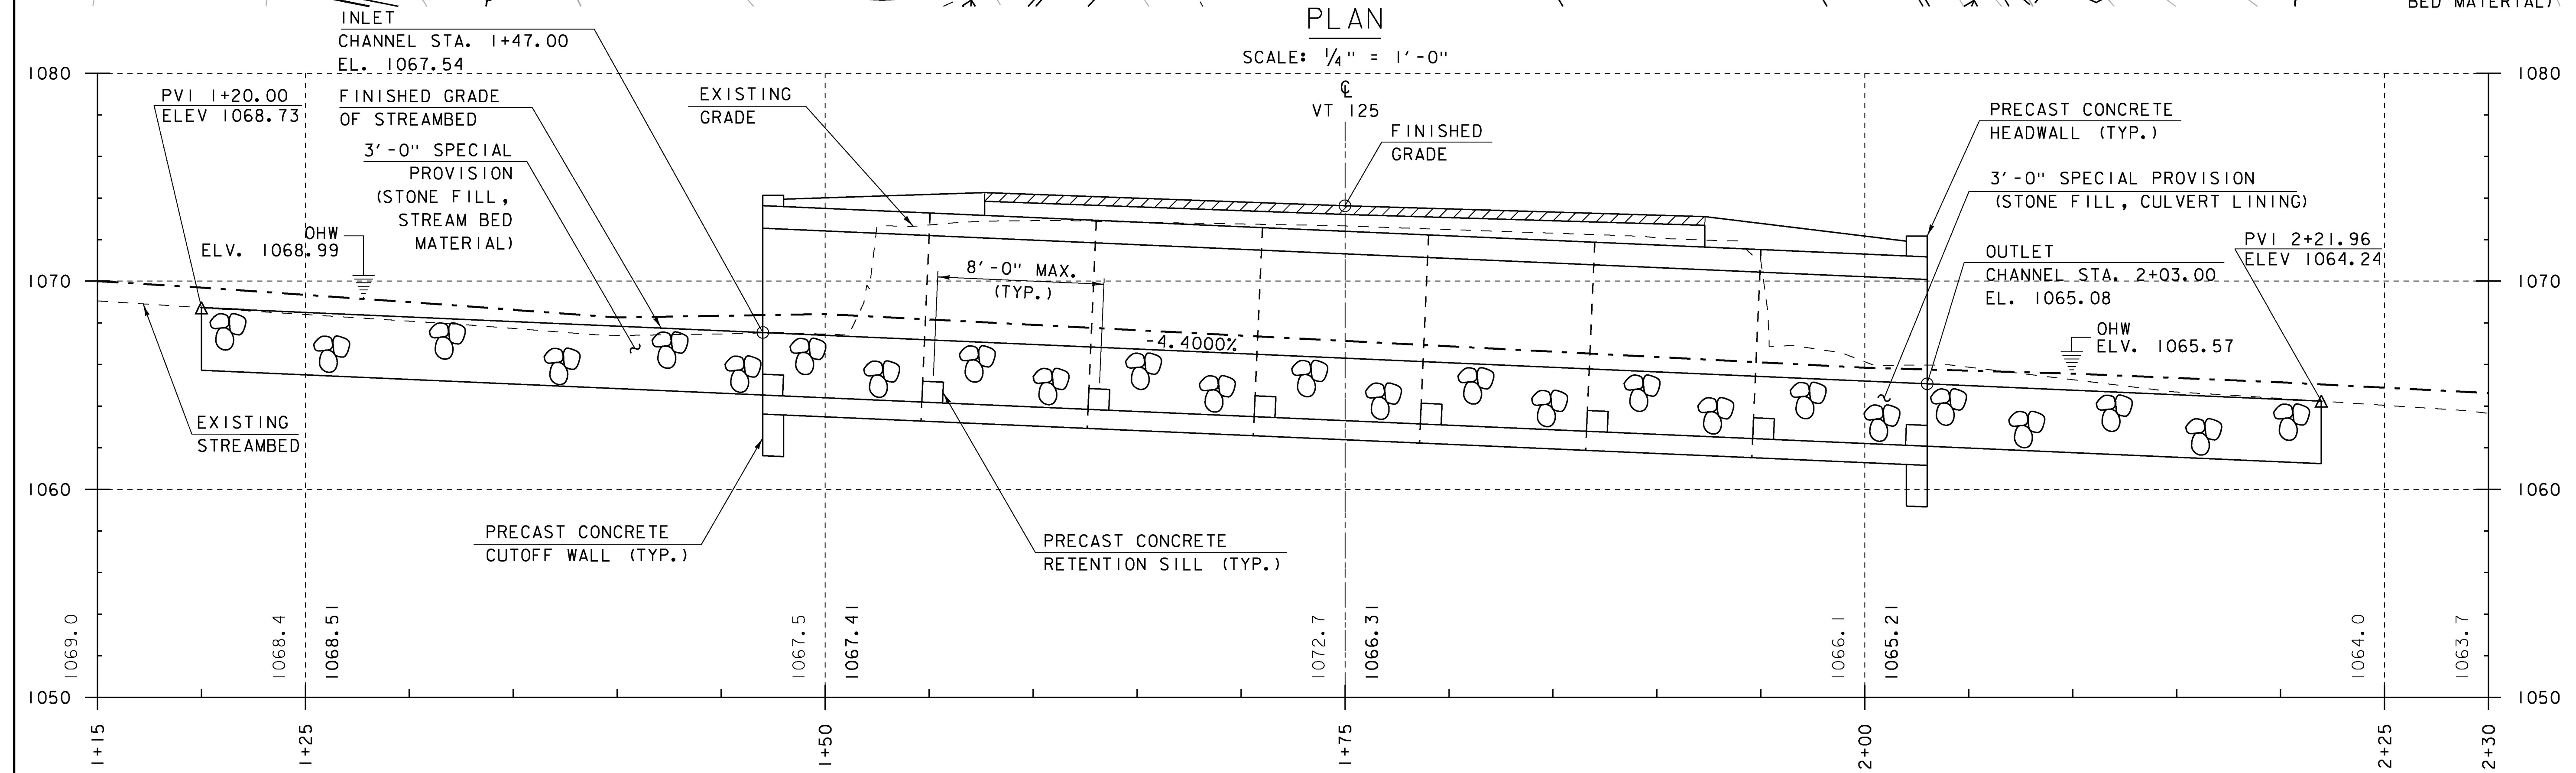

CHANNEL PROFILE

SCALE: 1/4" = 1'-0"

PROJECT NAME:	HANCOCK
PROJECT NUMBER:	ER STP 0174(18)
FILE NAME:	z12c412pe.dgn
PROJECT LEADER:	J. TUCKER
DESIGNED BY:	B. BRESLEND
PLAN AND CHANNEL PROFILE	
PLOT DATE:	10/11/2016
DRAWN BY:	O. DALMER
CHECKED BY:	P. BERO
SHEET	31 OF 42