


BEGIN APPROACH  
STA. 256+40.00


256+50

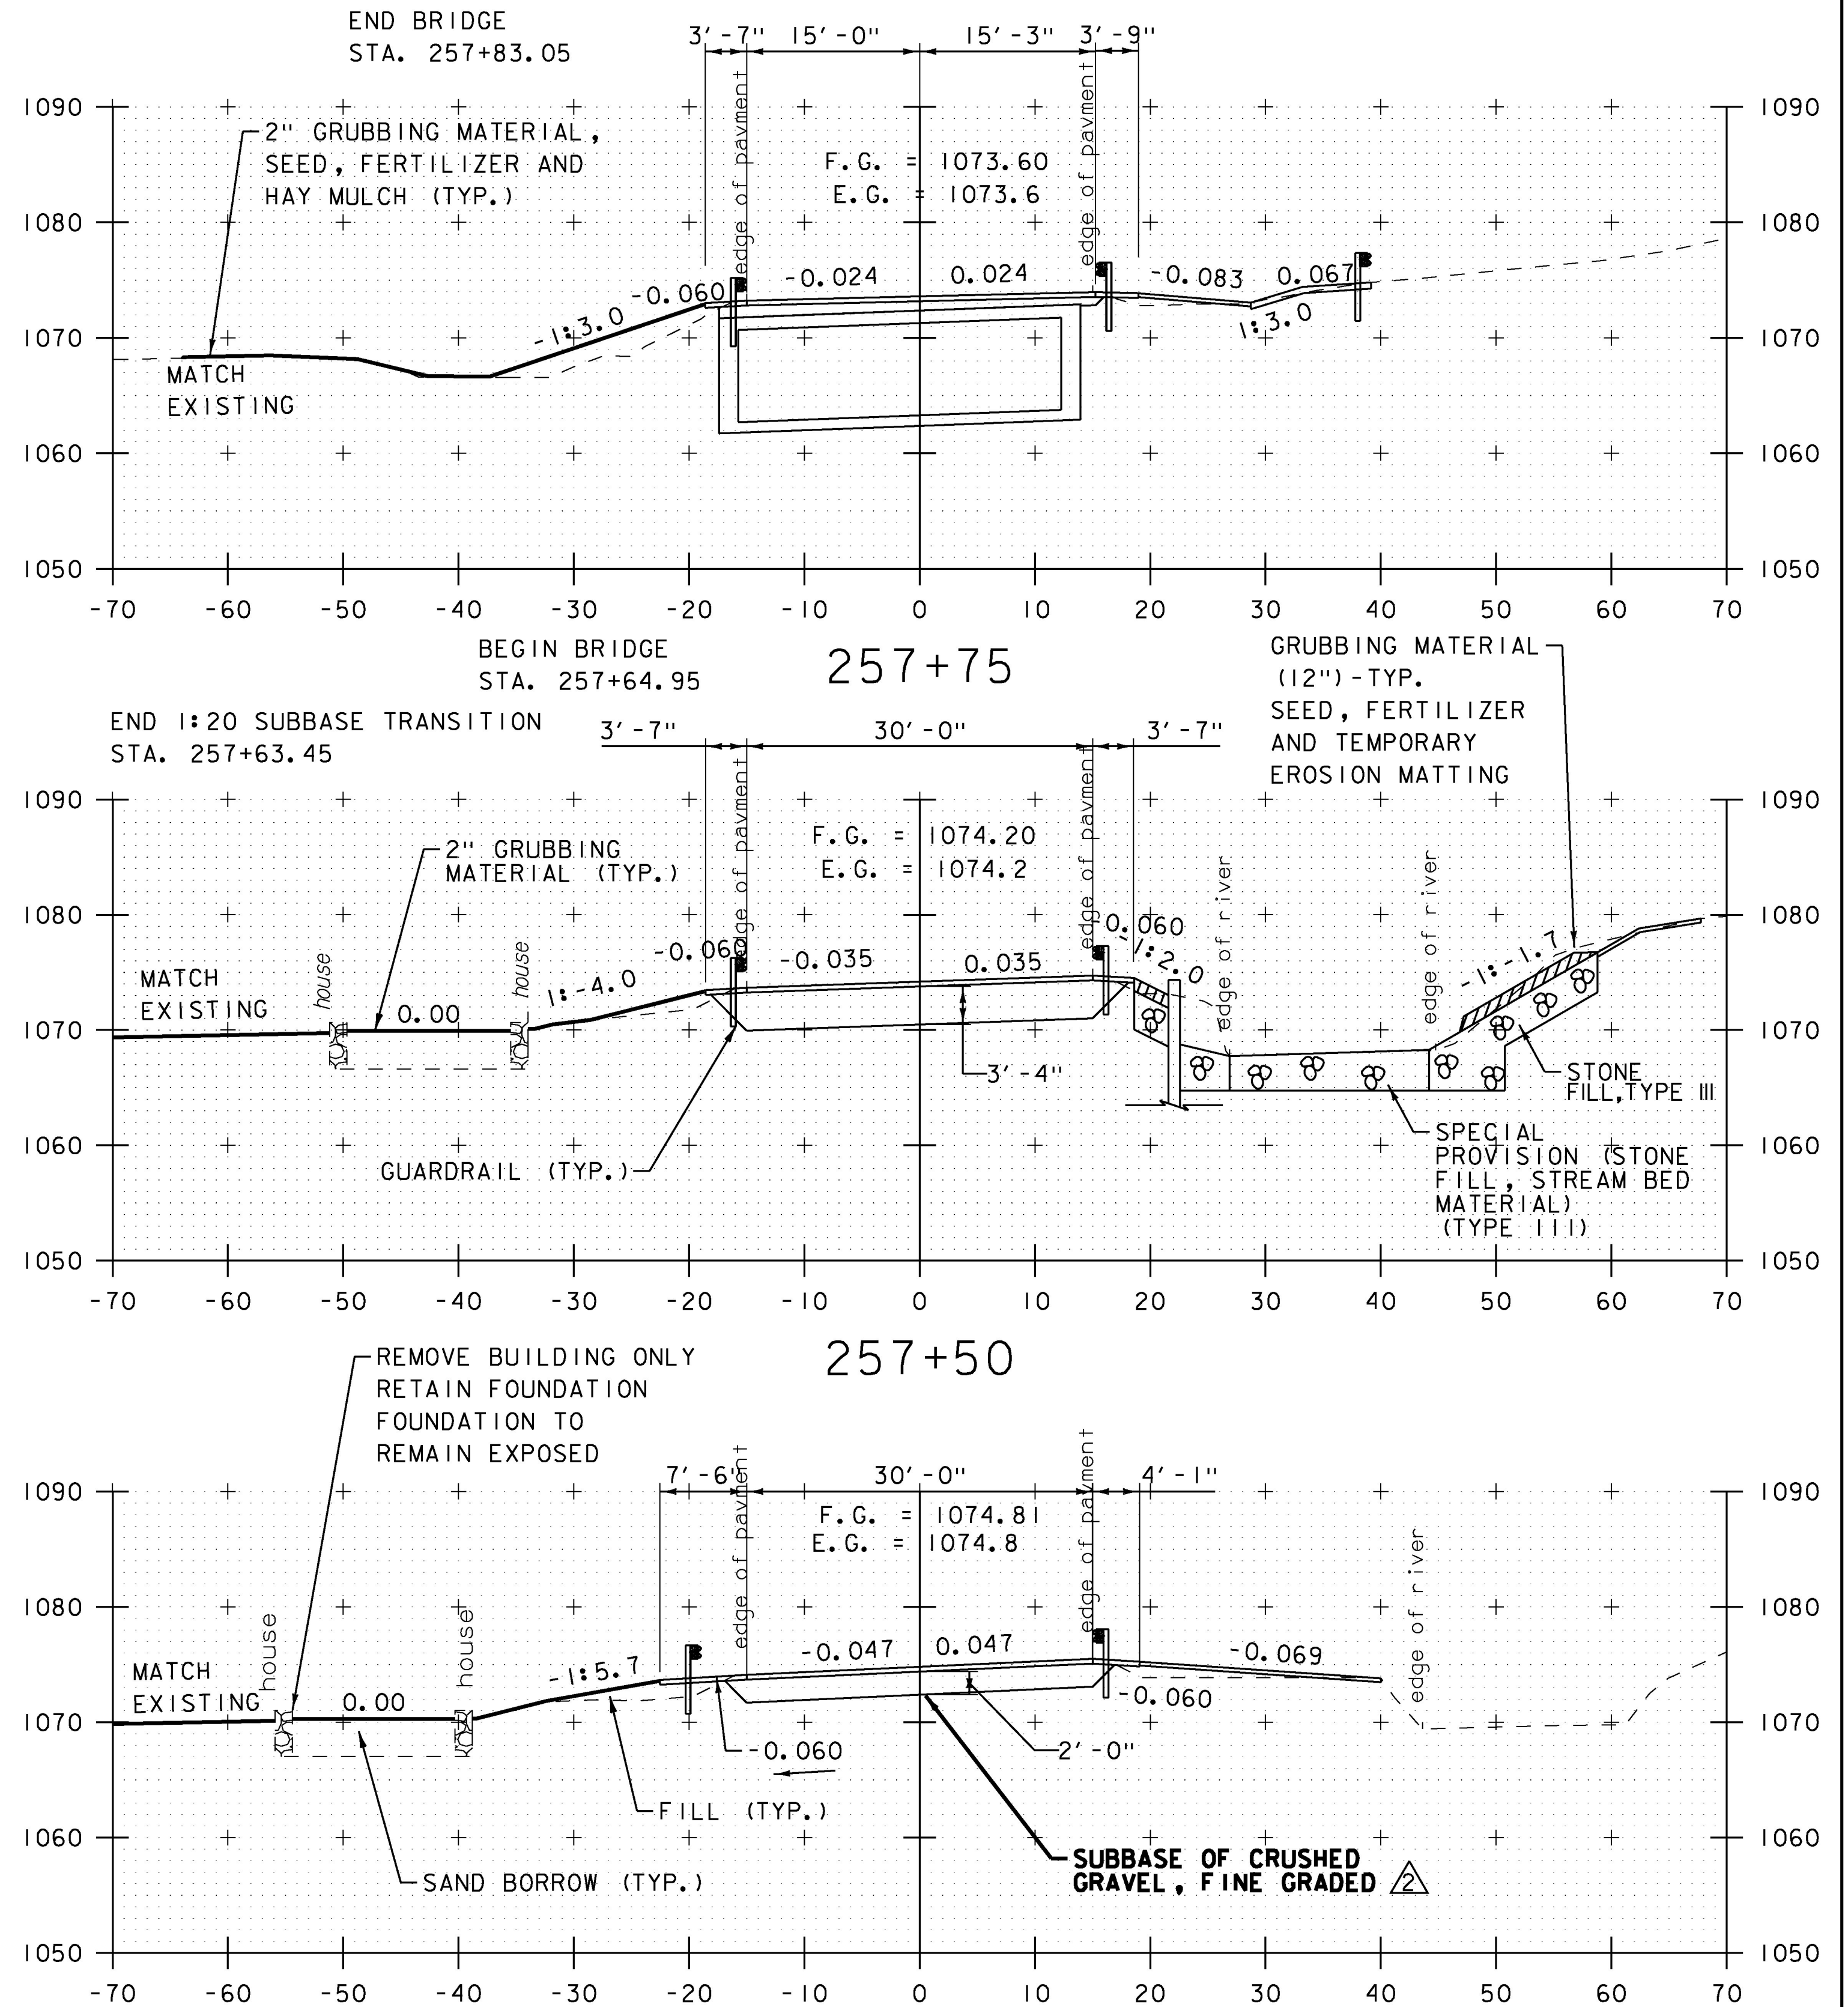

BEGIN PROJECT / BEGIN 1:20 SUBBASE TRANSITION  
STA. 257+25.00

257+25

STA. 256+50 TO STA. 257+75

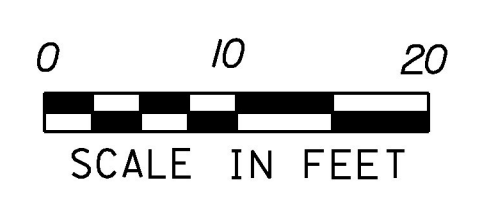

REV	DATE	DESCRIPTION
△	12/5/16	PAY ITEM CHANGE
△	12/5/16	PAY ITEM CHANGE

PROJECT NAME:	HANCOCK
PROJECT NUMBER:	ER STP 0174 (18)
FILE NAME:	z12c412xs1.dgn
PROJECT LEADER:	J. TUCKER
DESIGNED BY:	B. BRESLEND
ROADWAY CROSS SECTIONS SHEET 1	
PLOT DATE:	10/11/2016
DRAWN BY:	O. DALMER
CHECKED BY:	P. BERO
SHEET	35 OF 42