


STA. I+10 TO STA. I+40

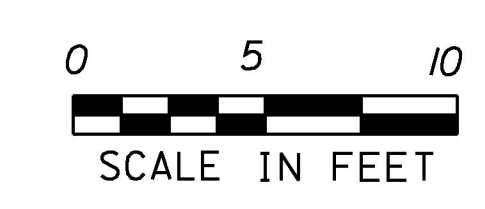

PROJECT NAME:	HANCOCK	PLOT DATE:	10/11/2016
PROJECT NUMBER:	ER STP 0174 (18)	DRAWN BY:	O. DALMER
FILE NAME:	z12c412xs1.dgn	DESIGNED BY:	B. BRESLEND
PROJECT LEADER:	J. TUCKER	CHECKED BY:	P. BERO
CHANNEL CROSS SECTIONS SHEET 1			SHEET 37 OF 42