


STA. 2+00 TO STA. 2+30

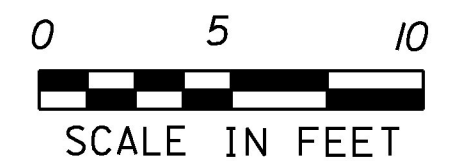

PROJECT NAME:	HANCOCK	PLOT DATE:	10/11/2016
PROJECT NUMBER:	ER STP 0174 (18)	DRAWN BY:	O. DALMER
FILE NAME:	z12c412xs1.dgn	DESIGNED BY:	B. BRESLEND
PROJECT LEADER:	J. TUCKER	CHECKED BY:	P. BERO
CHANNEL CROSS SECTIONS SHEET 3		SHEET	39 OF 42