


**TYPICAL SECTION**  
STA. 2+00 TO STA. 2+33

**NOTES:**

1. STONE FILL TO BE PLACED ON SLOPES STEEPER THAN 1:2.00.
2. SEE CROSS SECTIONS FOR SLOPES AND DIMENSIONS AT INDIVIDUAL SECTIONS.
3. ITEM 900.608 "SPECIAL PROVISION (GRANULAR BORROW)" SHALL BE PLACED IN 150 MM (6 INCH) MAXIMUM (LOOSE MEASURE) LAYERS AND COMPACTED AGAINST THE SLOPE WITH AN EXCAVATOR BUCKET.

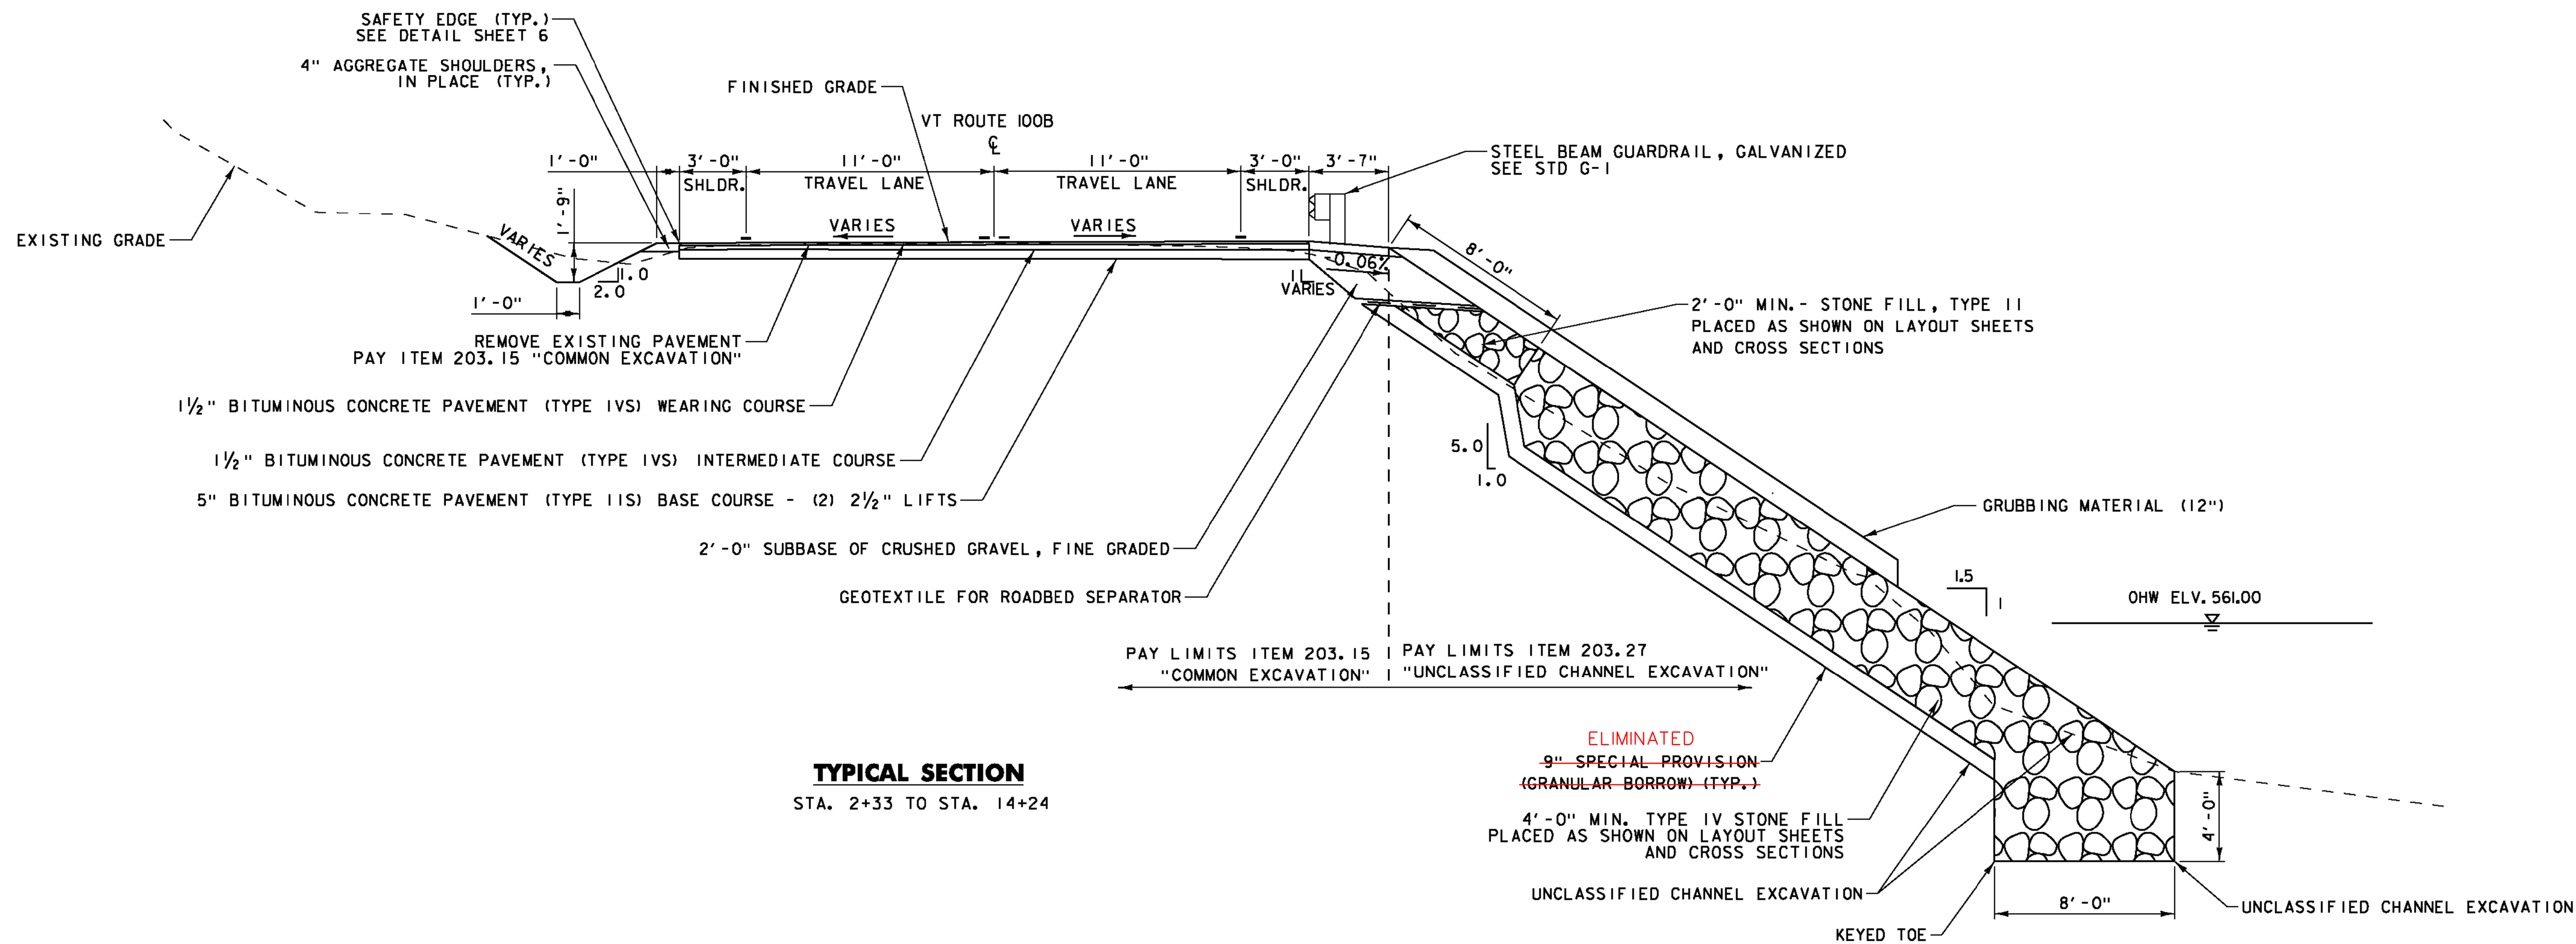

**TYPICAL SECTION**  
STA. 2+33 TO STA. 14+24

**TOLERANCES :**

PAVEMENT : +/- 1/4" TOTAL PAVEMENT THICKNESS  
SUBBASE : +/- 1" TOTAL CRUSHED STONE THICKNESS

**DETAILS ARE NOT TO SCALE**

PROJECT NAME: MORETOWN	PLOT DATE: 2/17/2015
PROJECT NUMBER: ER STP 0167 (15)	DRAWN BY: B. MACK
FILE NAME: z12c524 typ. dgn	CHECKED BY: A. SANZ
PROJECT LEADER: J. TUCKER	SHEET 4 OF 57
DESIGNED BY: B. BRESLEND	
TYPICAL SECTION SHEET 1	