

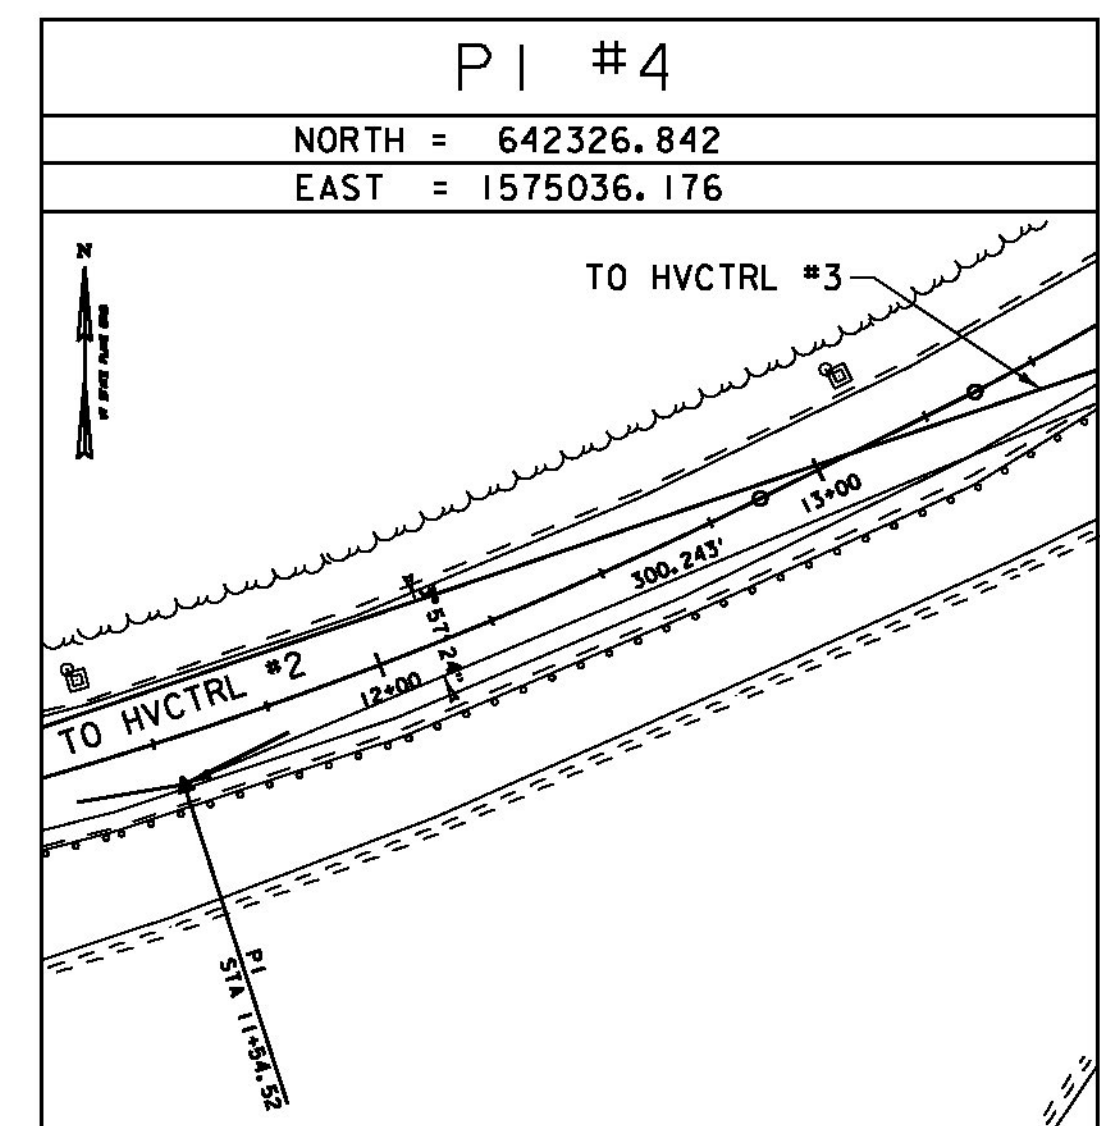
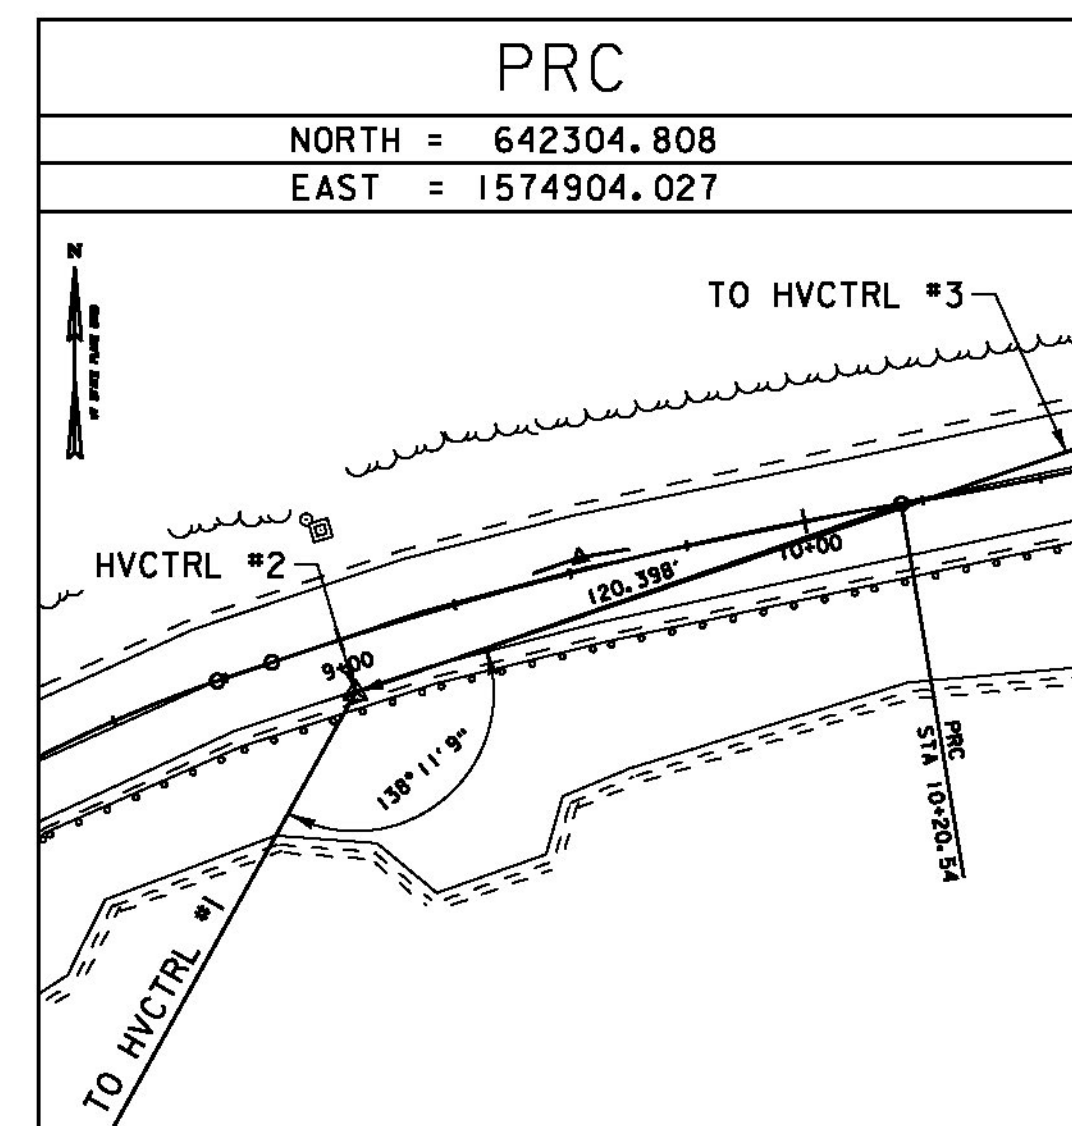
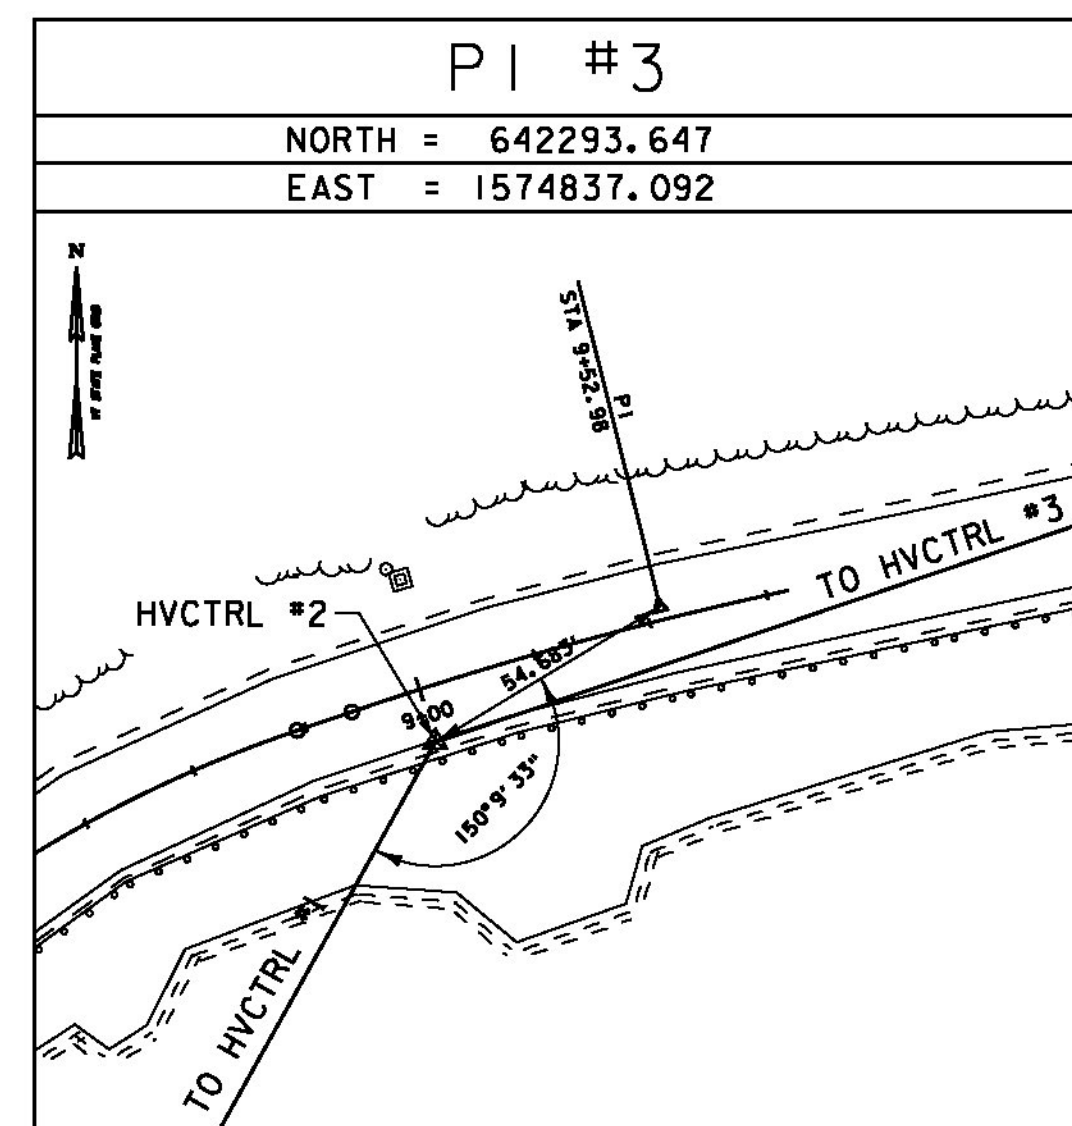
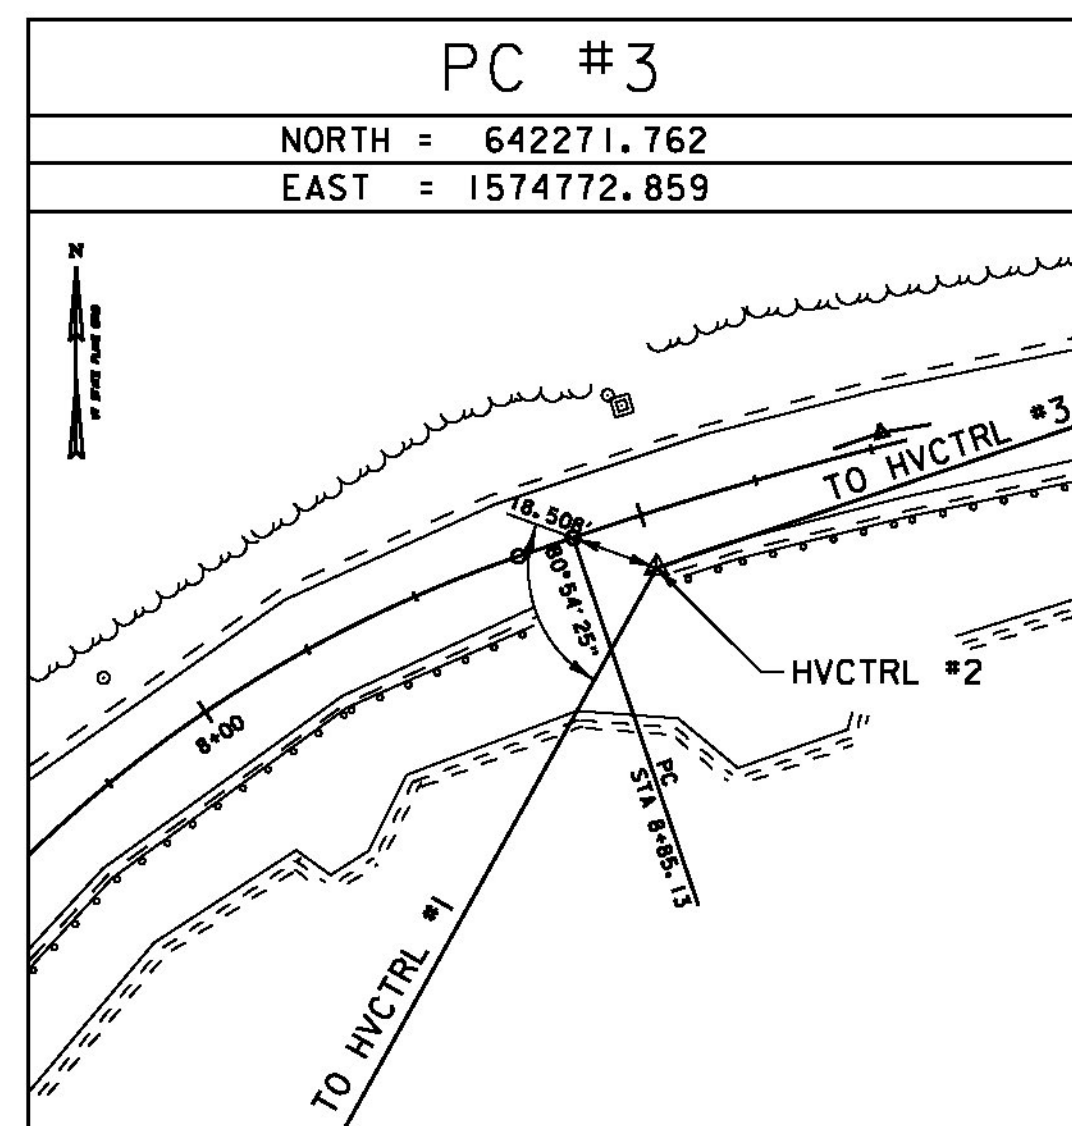
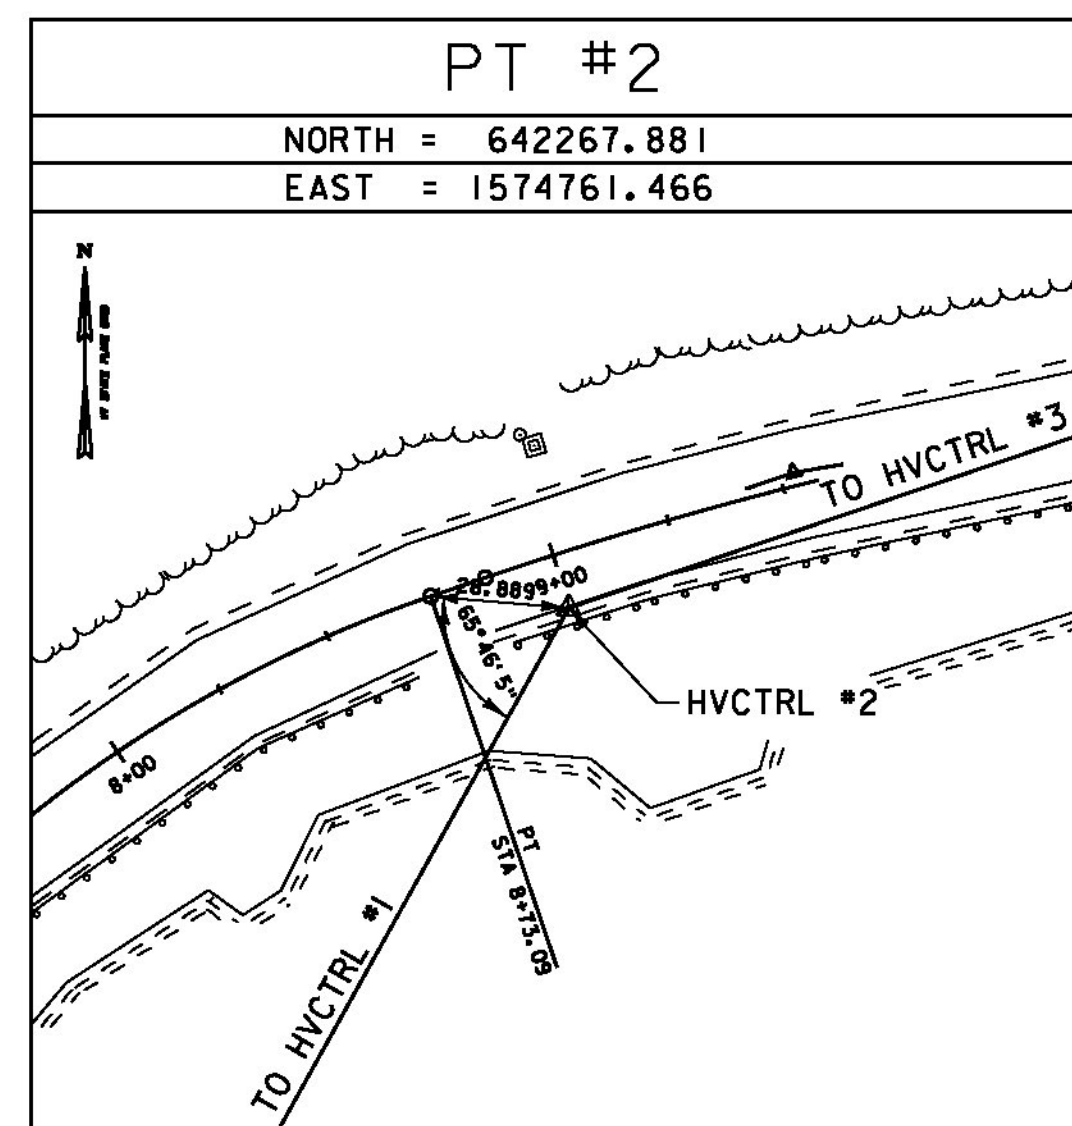
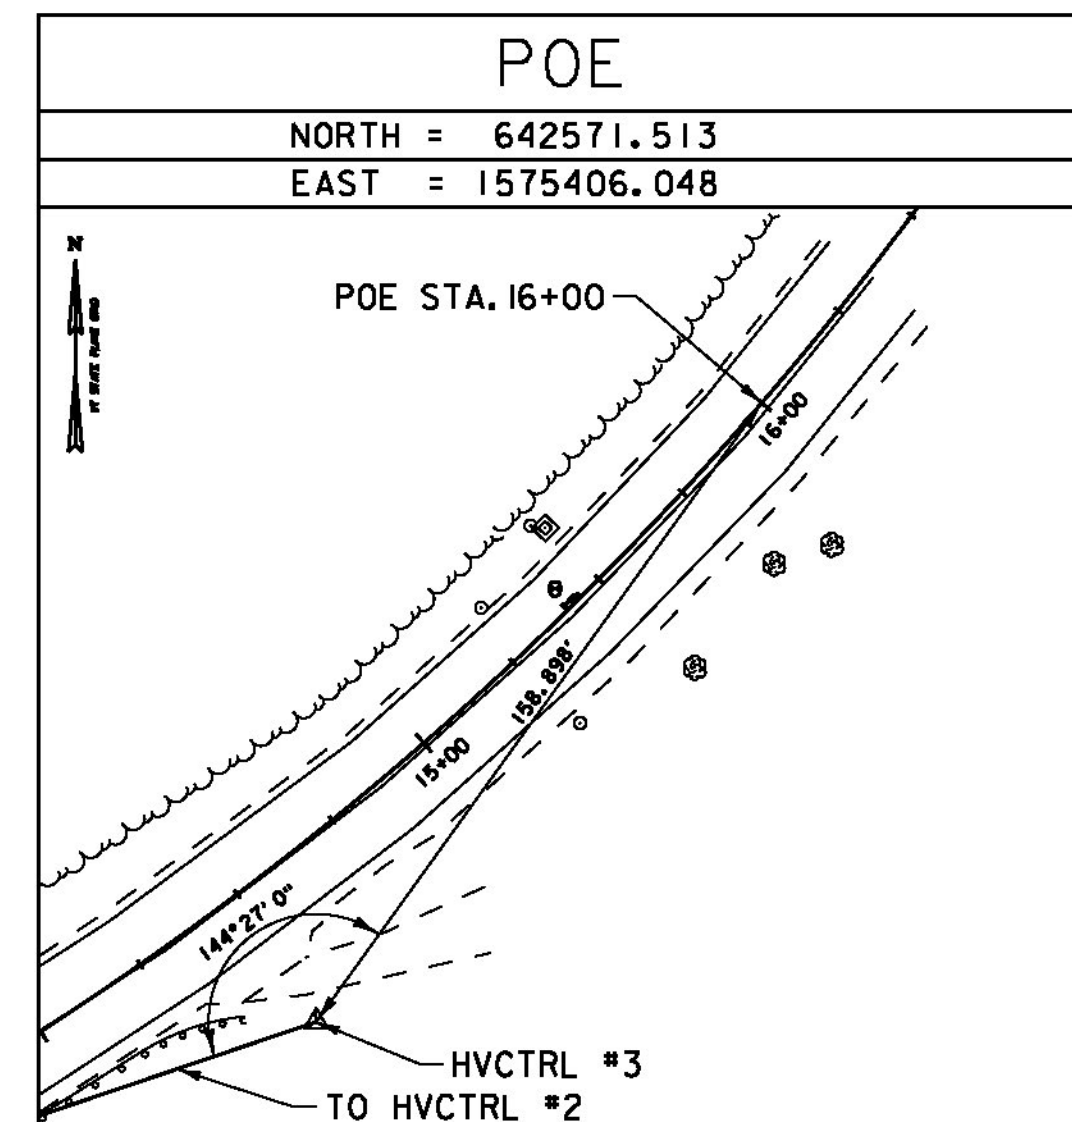
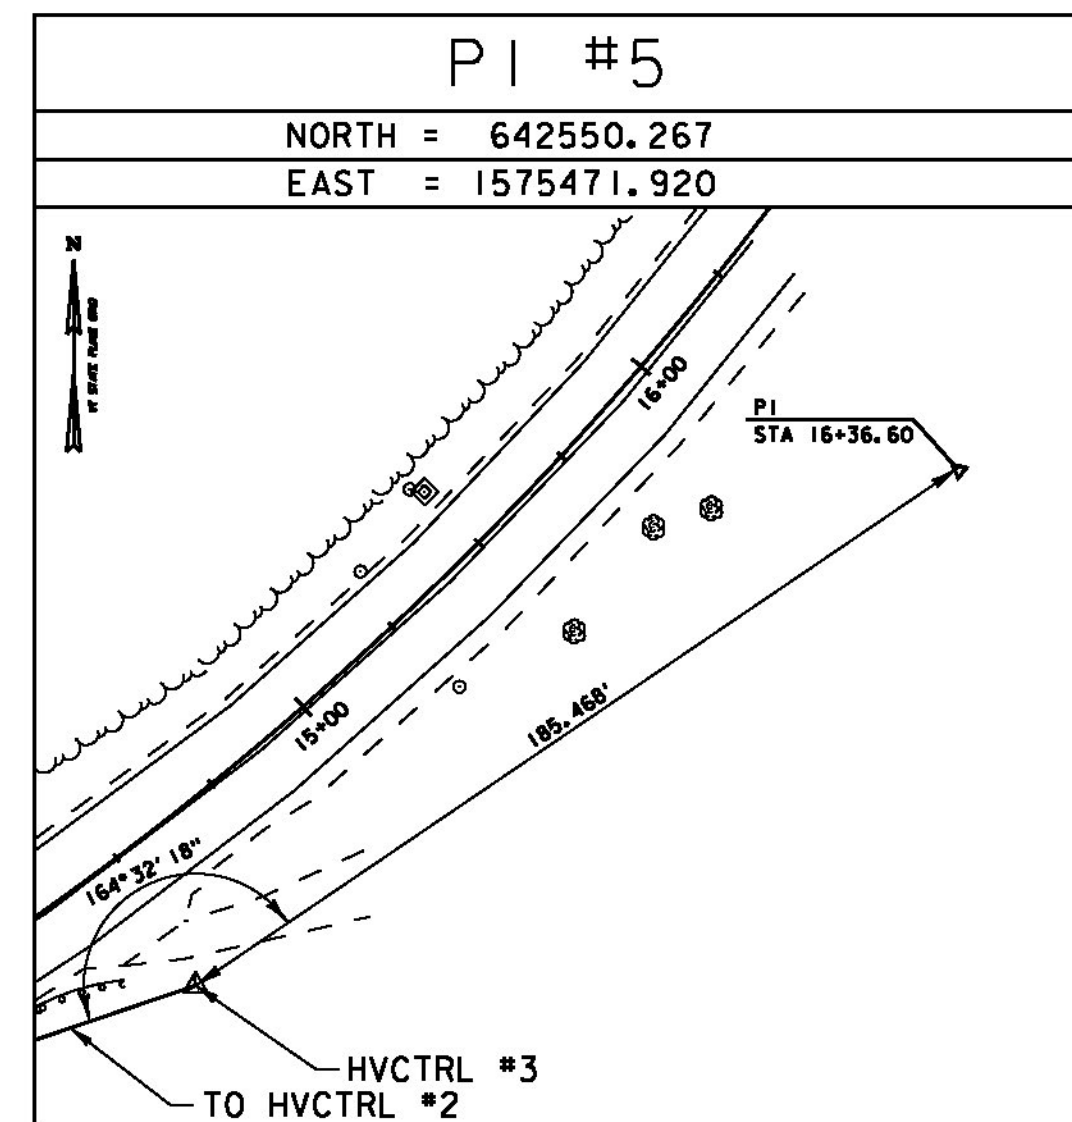


ALIGNMENT TIES

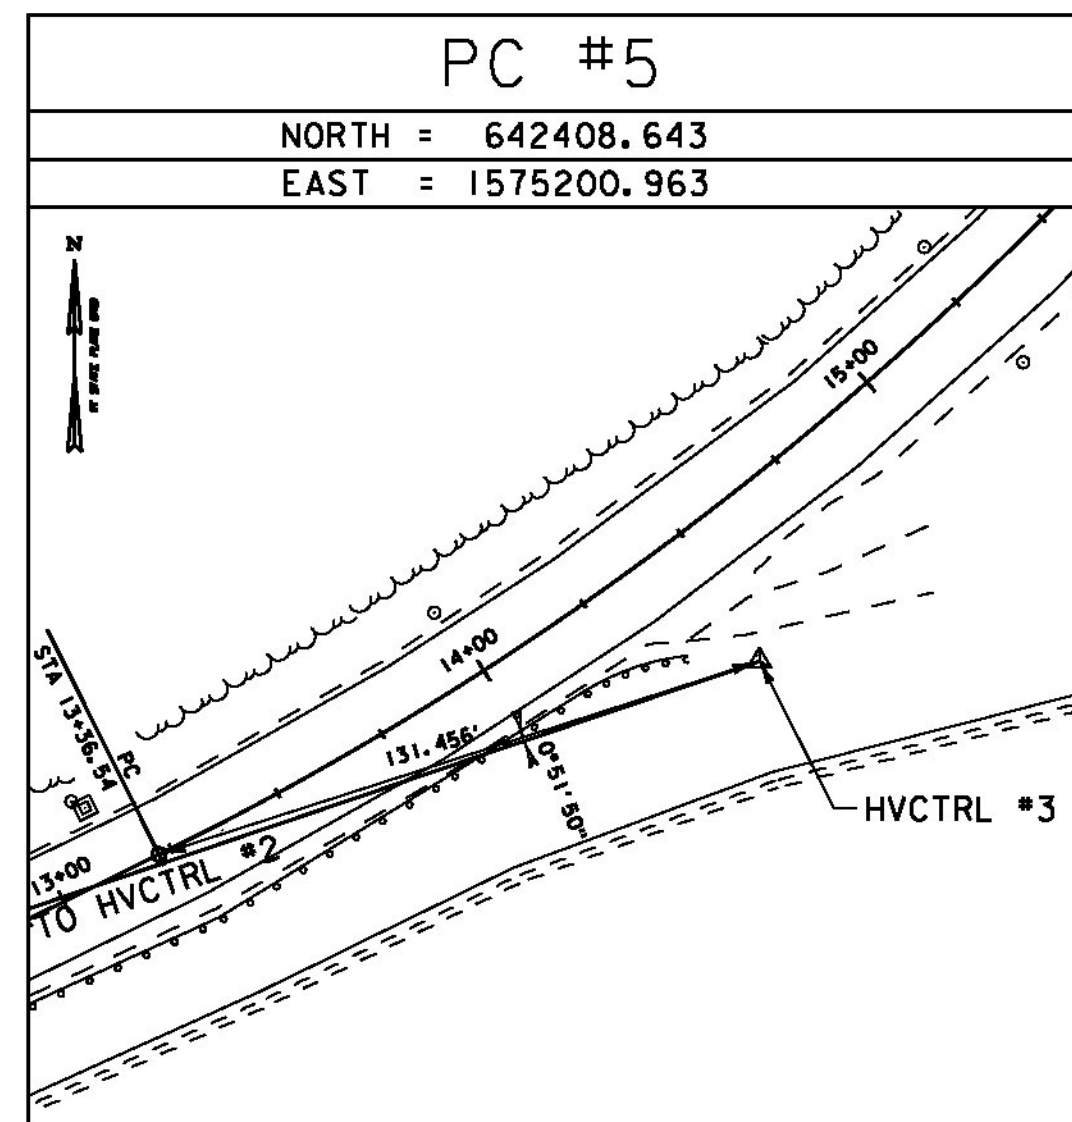

ALIGNMENT TIES

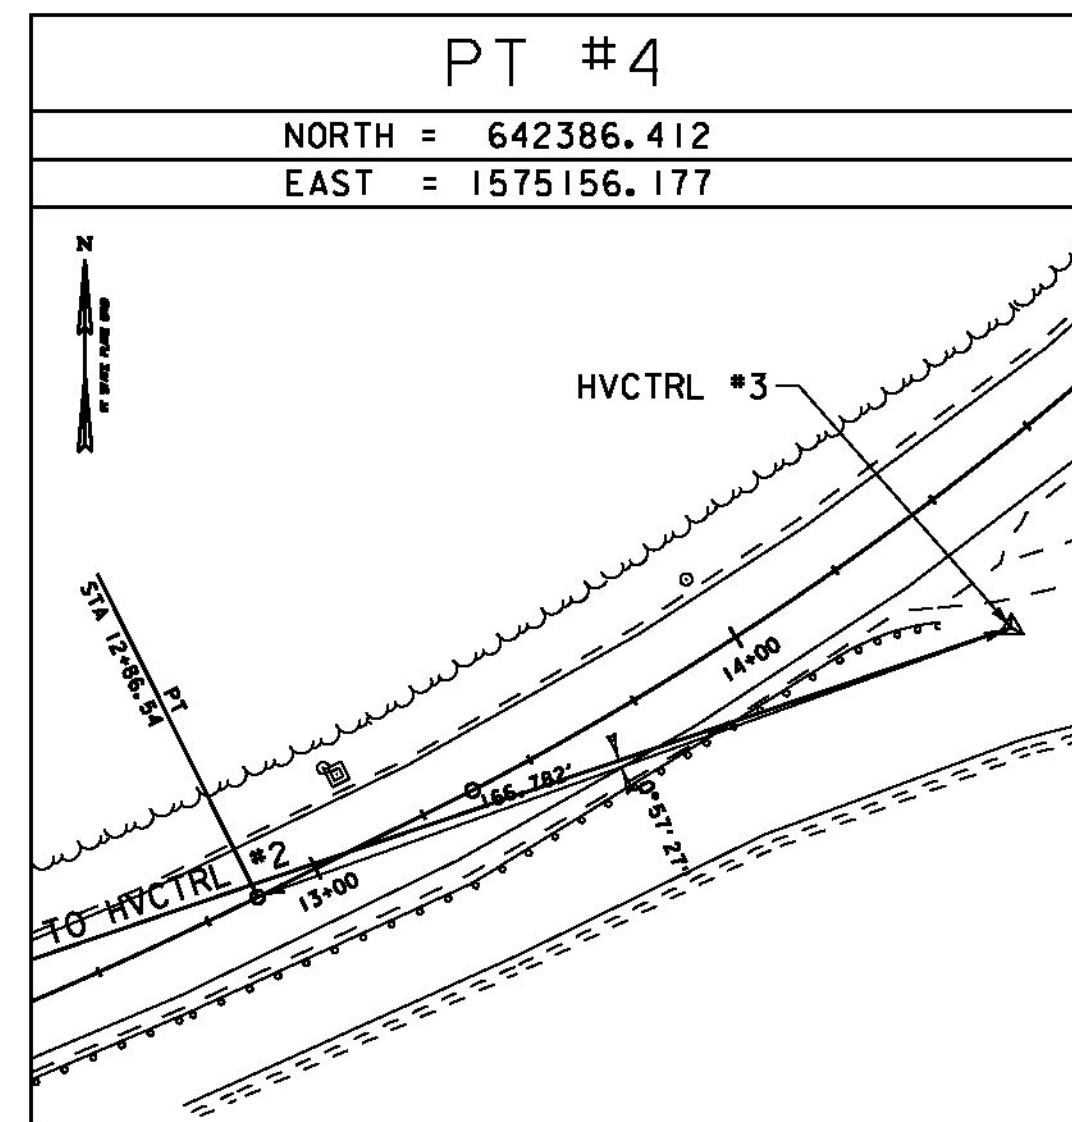

ALIGNMENT TIES

DATUM	
VERTICAL	NAVD 88
HORIZONTAL	NAD 83 (11)
ADJUSTMENT	COMPASS

PROJECT NAME:	MORETOWN
PROJECT NUMBER:	ER STP 0167 (15)
FILE NAME:	z12c5241i.dgn
PROJECT LEADER:	J. TUCKER
DESIGNED BY:	B. BRESLEND
TIE SHEET	2
PLOT DATE:	2/17/2015
DRAWN BY:	B. MACK
CHECKED BY:	A. SANZ
SHEET	8 OF 57

NOT TO SCALE