


SOIL INFORMATION:
 TUNBRIDGE-LYMAN COMPLEX
 K-FACTOR = 0.25, 8-15% SLOPES,
 VERY ROCKY
 HYDROLOGIC SOIL GROUP: C/D

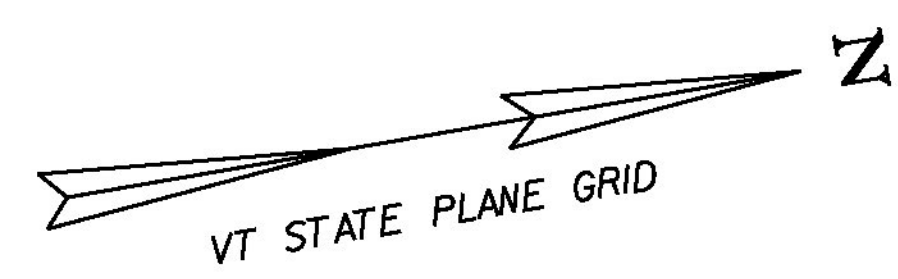

SPEED LIMIT
40

**ALLEN, THOMAS L.,
 VENEMA, STEPHANIE,
 SEGUIN, WILLIAM**


**FORTE, ANGELO F.,
 FORTE, LOUIS P.,
 FORTE, GEORGE M.,
 FORTE, JAMES P.**

30
 MPH

HVCTRL 1
 N: 641781.574
 E: 1574520.985
 ELEV. 572.63

**VENEMA, STEPHANIE & ALLEN, THOMAS L.
 trustees of the
 VENEMA-ALLEN JOINT TRUST**

**N/F
 WEXLER,
 DONALD H.**

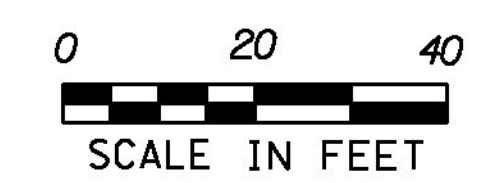

PROJECT NAME: MORETOWN	PLOT DATE: 2/17/2015
PROJECT NUMBER: ER STP 0167 (15)	DRAWN BY: B. MACK
FILE NAME: z12c524.EPSC.dgn	CHECKED BY: J. TUCKER
PROJECT LEADER: J. TUCKER	EPSC EXISTING CONDITIONS - SHEET 1
DESIGNED BY: B. BRESLEND	SHEET 32 OF 57

