

SEED
 STA. 11+25.00 - STA. 16+00.00 LT
 STA. 11+25.00 - STA. 16+00.00 RT

FERTILIZER
 STA. 11+25.00 - STA. 16+00.00 LT
 STA. 11+25.00 - STA. 16+00.00 RT

TEMPORARY EROSION MATTING
 STA. 11+25.00 - STA. 16+00.00 LT
 STA. 11+25.00 - STA. 16+00.00 RT

AGRICULTURAL LIMESTONE
 STA. 11+25.00 - STA. 16+00.00 LT
 STA. 11+25.00 - STA. 16+00.00 RT



BARRIER FENCE
 STA. 11+25.00 - STA. 16+16.00 LT
GEOTEXTILE FOR SILT FENCE, WOVEN WIRE REINFORCED
 STA. 15+32.00 - STA. 16+16.00 RT
 PROVIDE 20' OPENING IN FENCE FOR ACCESS TO FIELD

VEHICLE TRACKING PAD
 STA. 15+87.00 LT

TEMPORARY STONE CHECK DAM, TYPE I
 STA. 11+25.00 - STA. 11+37.00 LT
 STA. 11+50.00 - STA. 13+11.00 LT
 STA. 13+15.00 - STA. 15+45.00 LT

INLET PROTECTION DEVICE, TYPE I
 STA. 11+37.78 LT
 STA. 13+13.14 LT
 STA. 15+50.87 LT

GEOTEXTILE FOR FILTER CURTAIN
 STA. 11+25.00 - STA. 14+10.00 RT

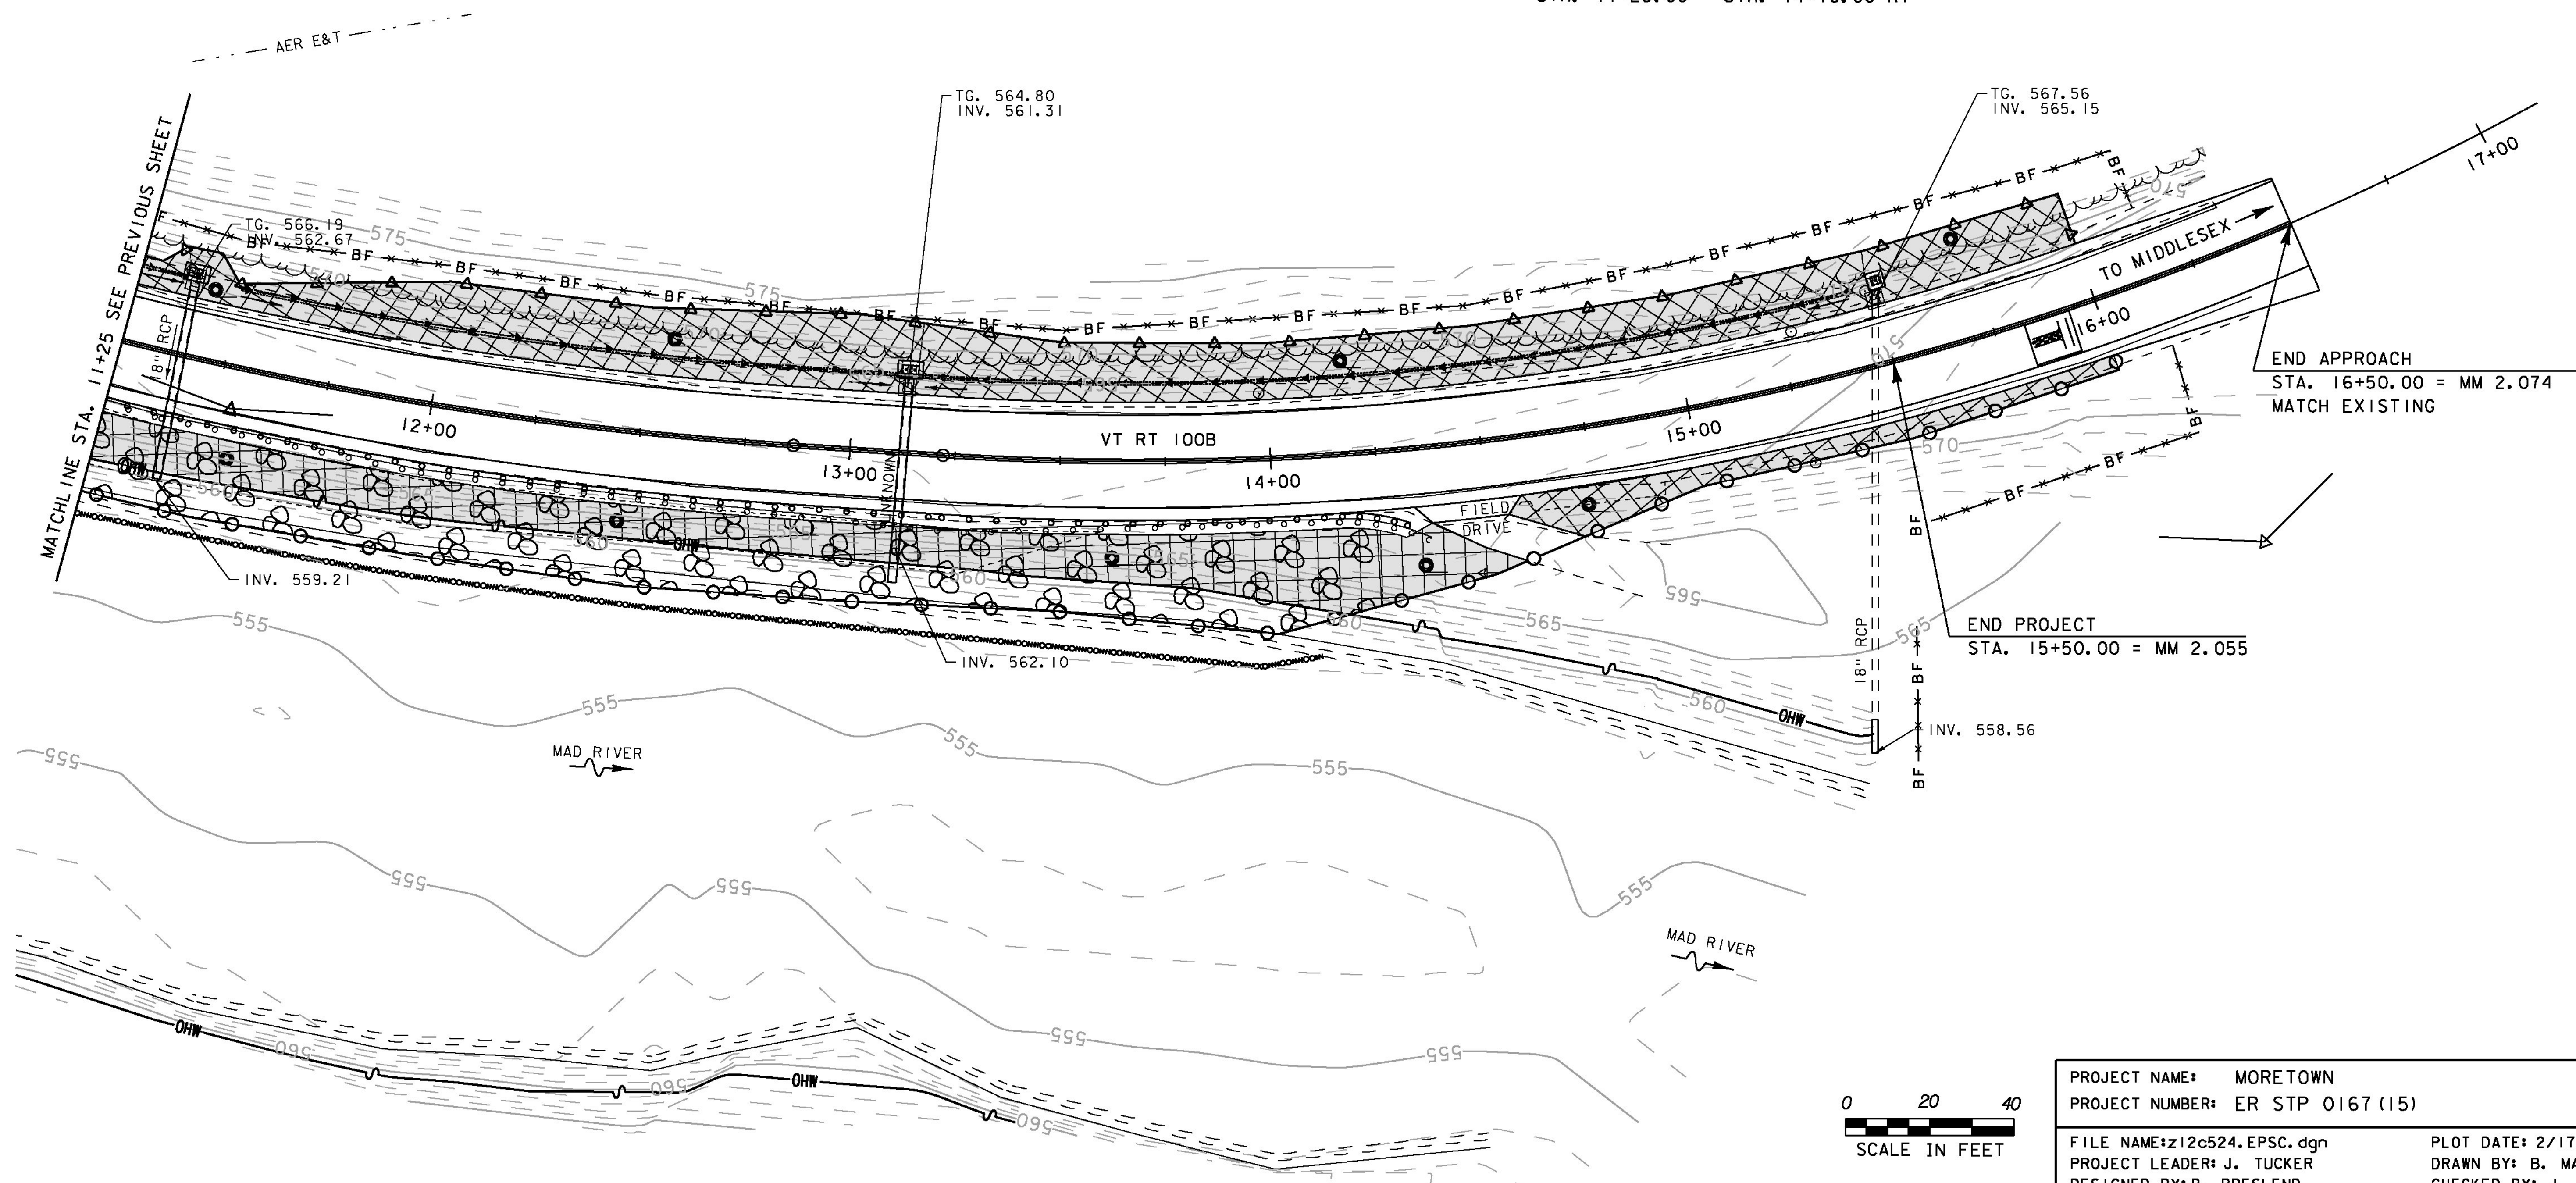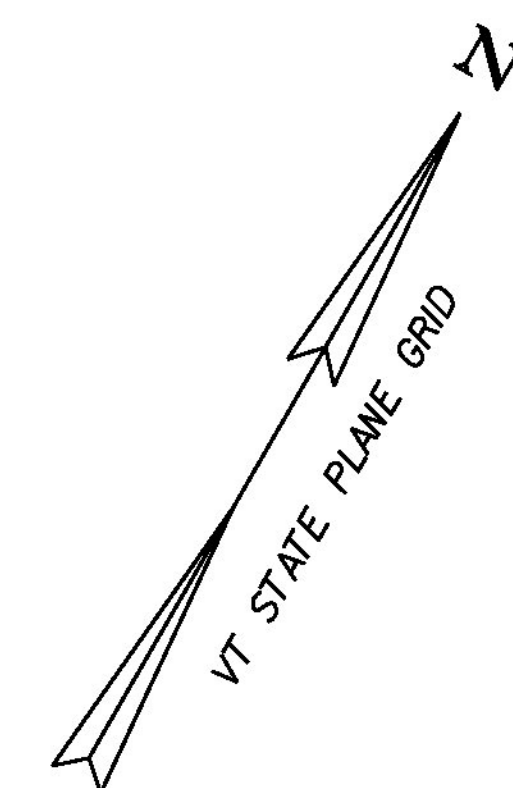

PROJECT NAME: MORETOWN	PLOT DATE: 2/17/2015
PROJECT NUMBER: ER STP 0167 (15)	DRAWN BY: B. MACK
FILE NAME: z12c524.EPSC.dgn	CHECKED BY: J. TUCKER
PROJECT LEADER: J. TUCKER	EPSC CONSTRUCTION COND. - SHEET 3
DESIGNED BY: B. BRESLEND	SHEET 37 OF 57