


BEGIN APPROACH
STA. 1+00.00 = MM 1.780
MATCH EXISTING

BEGIN PROJECT
STA. 2+00.00 = MM 1.799

MATCHLINE STA. 5+50 SEE NEXT SHEET

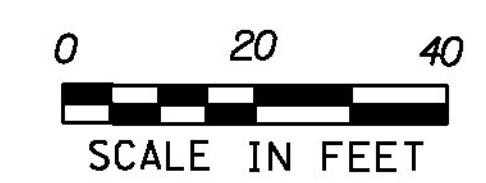

PROJECT NAME: MORETOWN	PLOT DATE: 2/17/2015
PROJECT NUMBER: ER STP 0167 (15)	DRAWN BY: B. MACK
FILE NAME: z12c524.EPSC.dgn	CHECKED BY: J. TUCKER
PROJECT LEADER: J. TUCKER	SHEET 38 OF 57
DESIGNED BY: B. BRESLEND	
EPSC FINAL CONDITIONS - SHEET 1	