



2+00

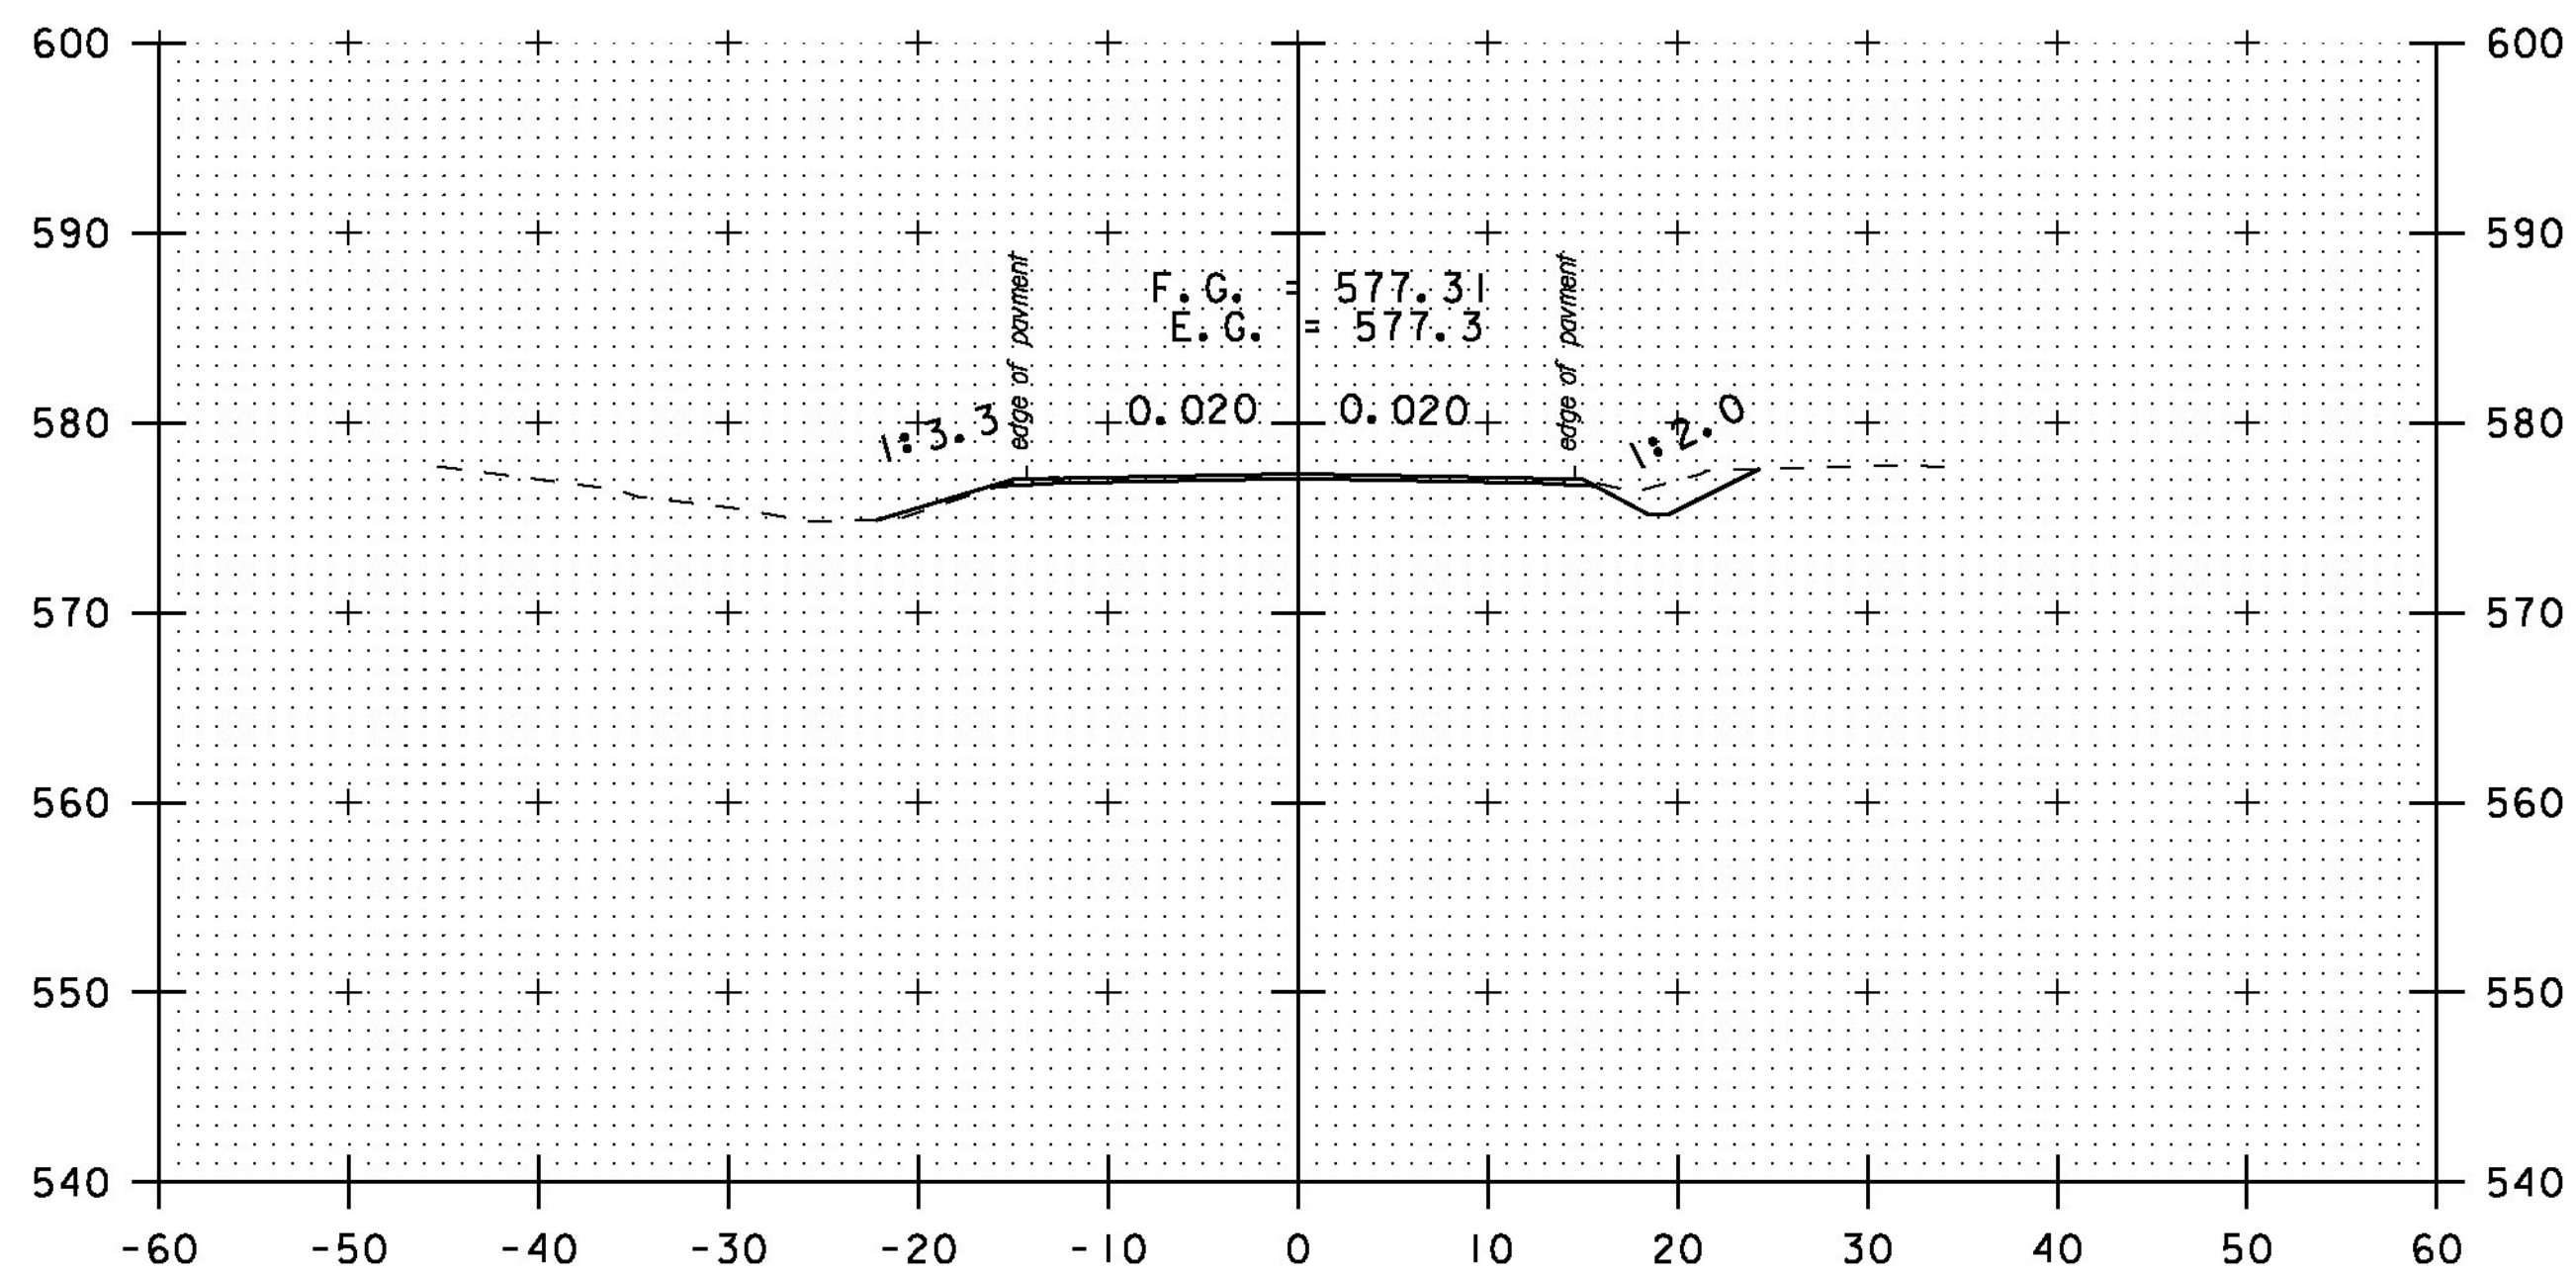


1+50


STA. 1+00.00  
BEGIN APPROACH  
MATCH EXISTING

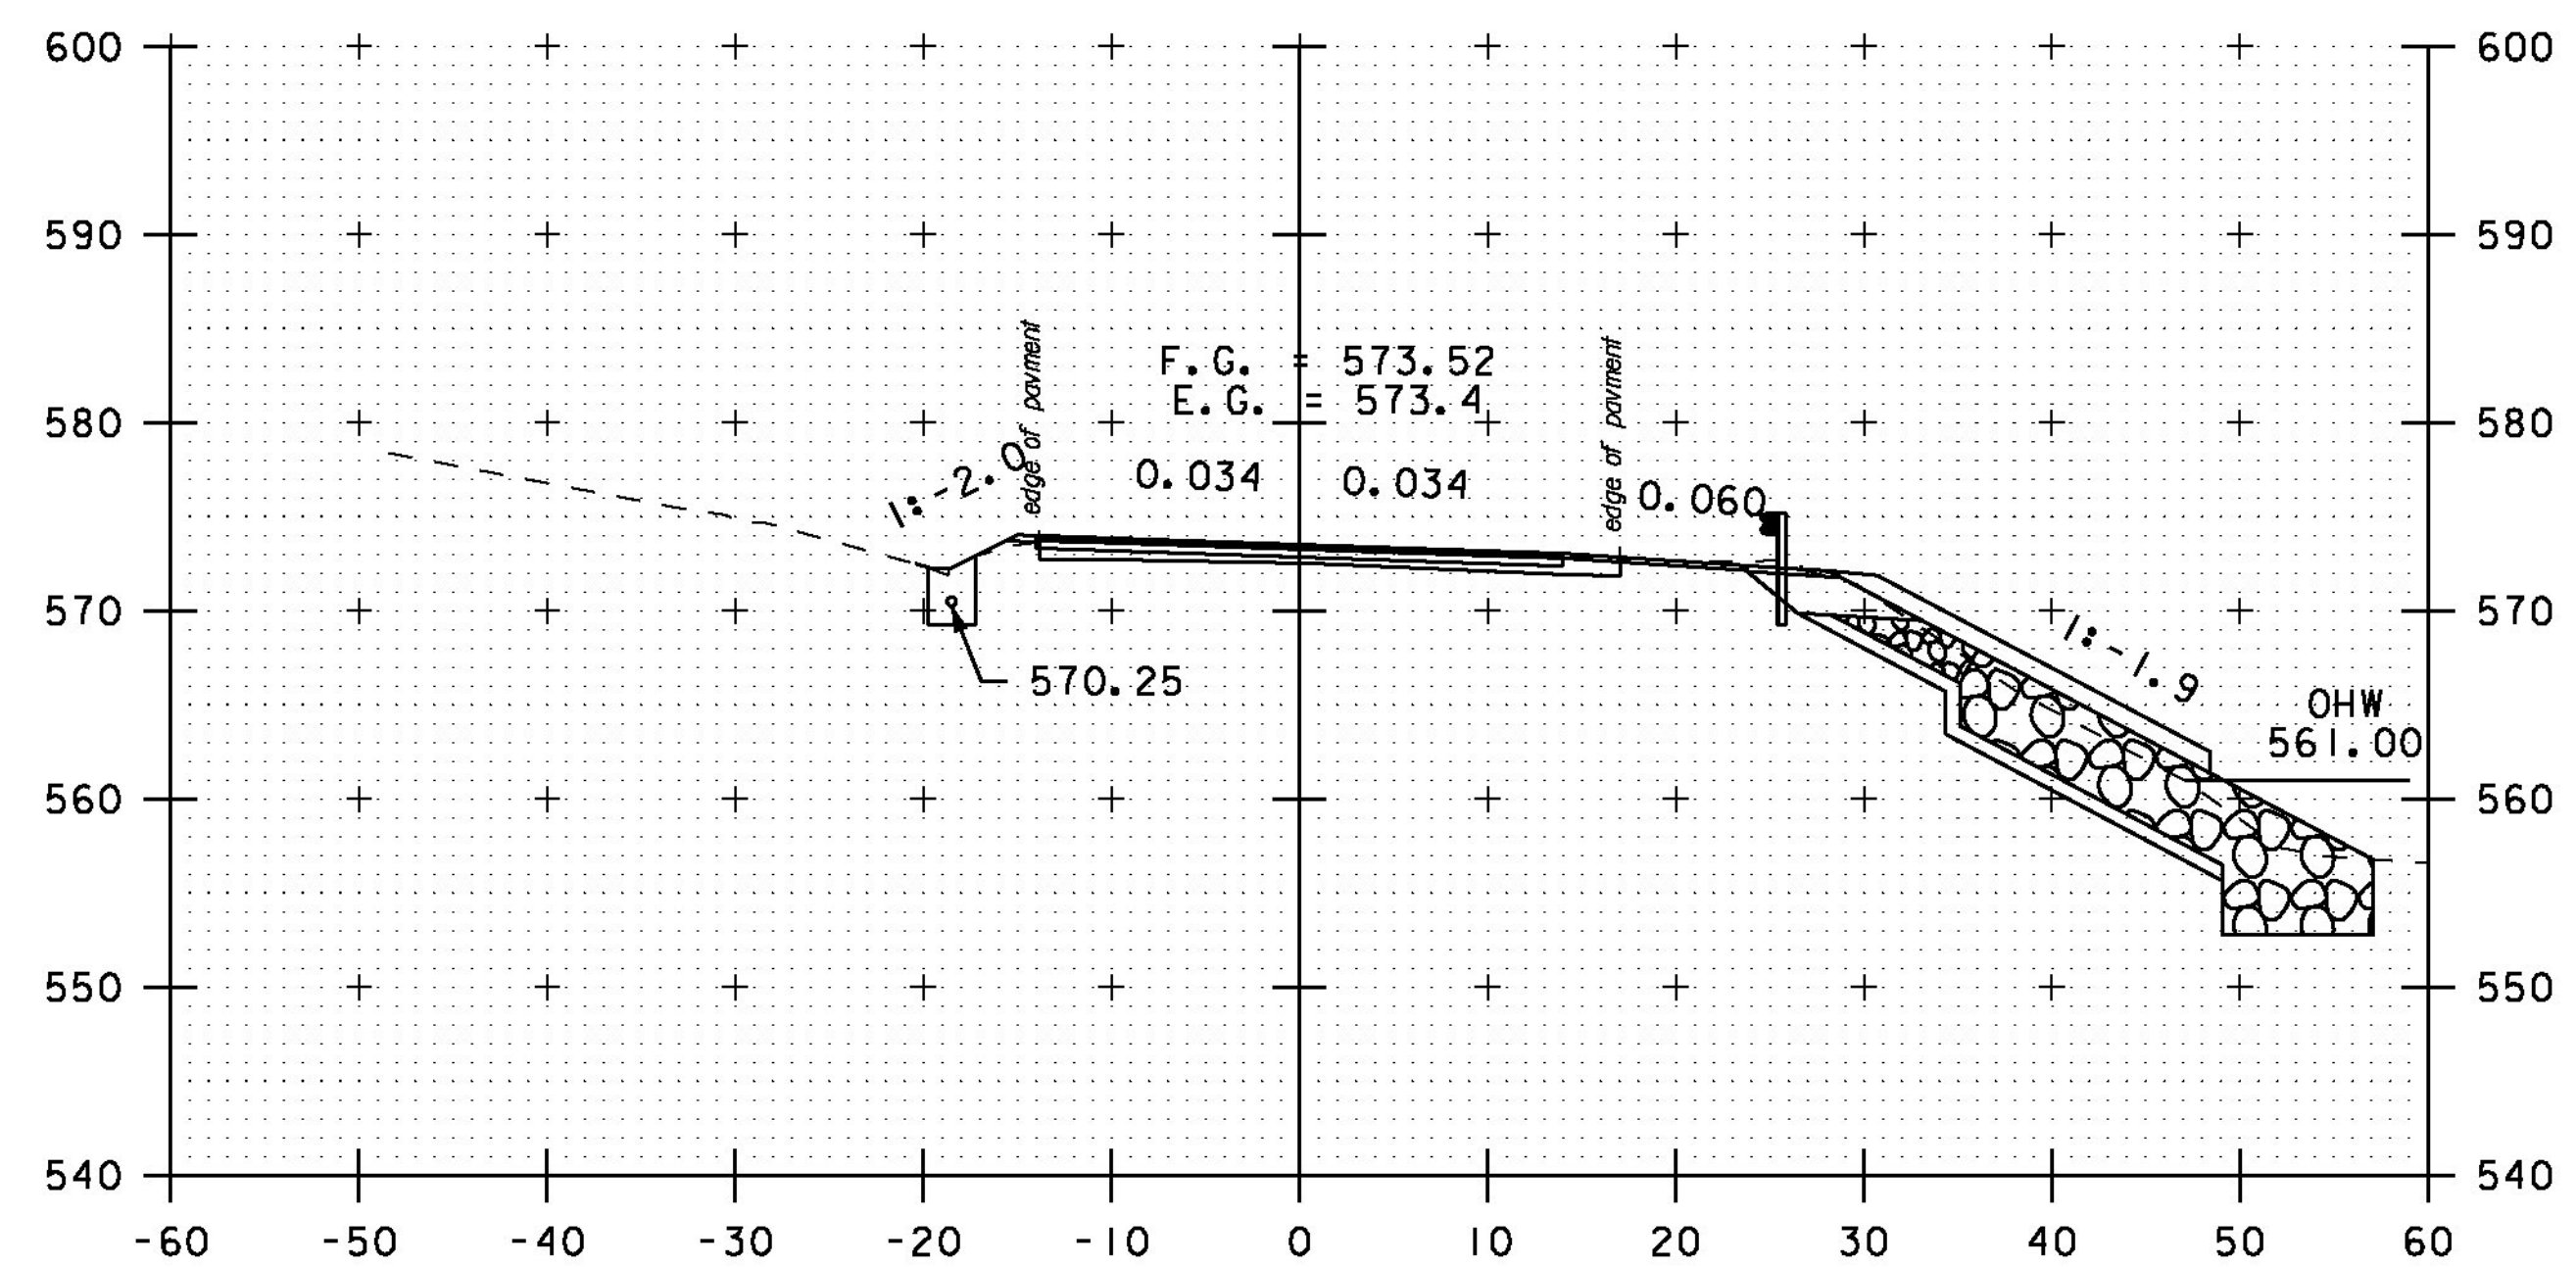

PULL OFF RT  
3+00

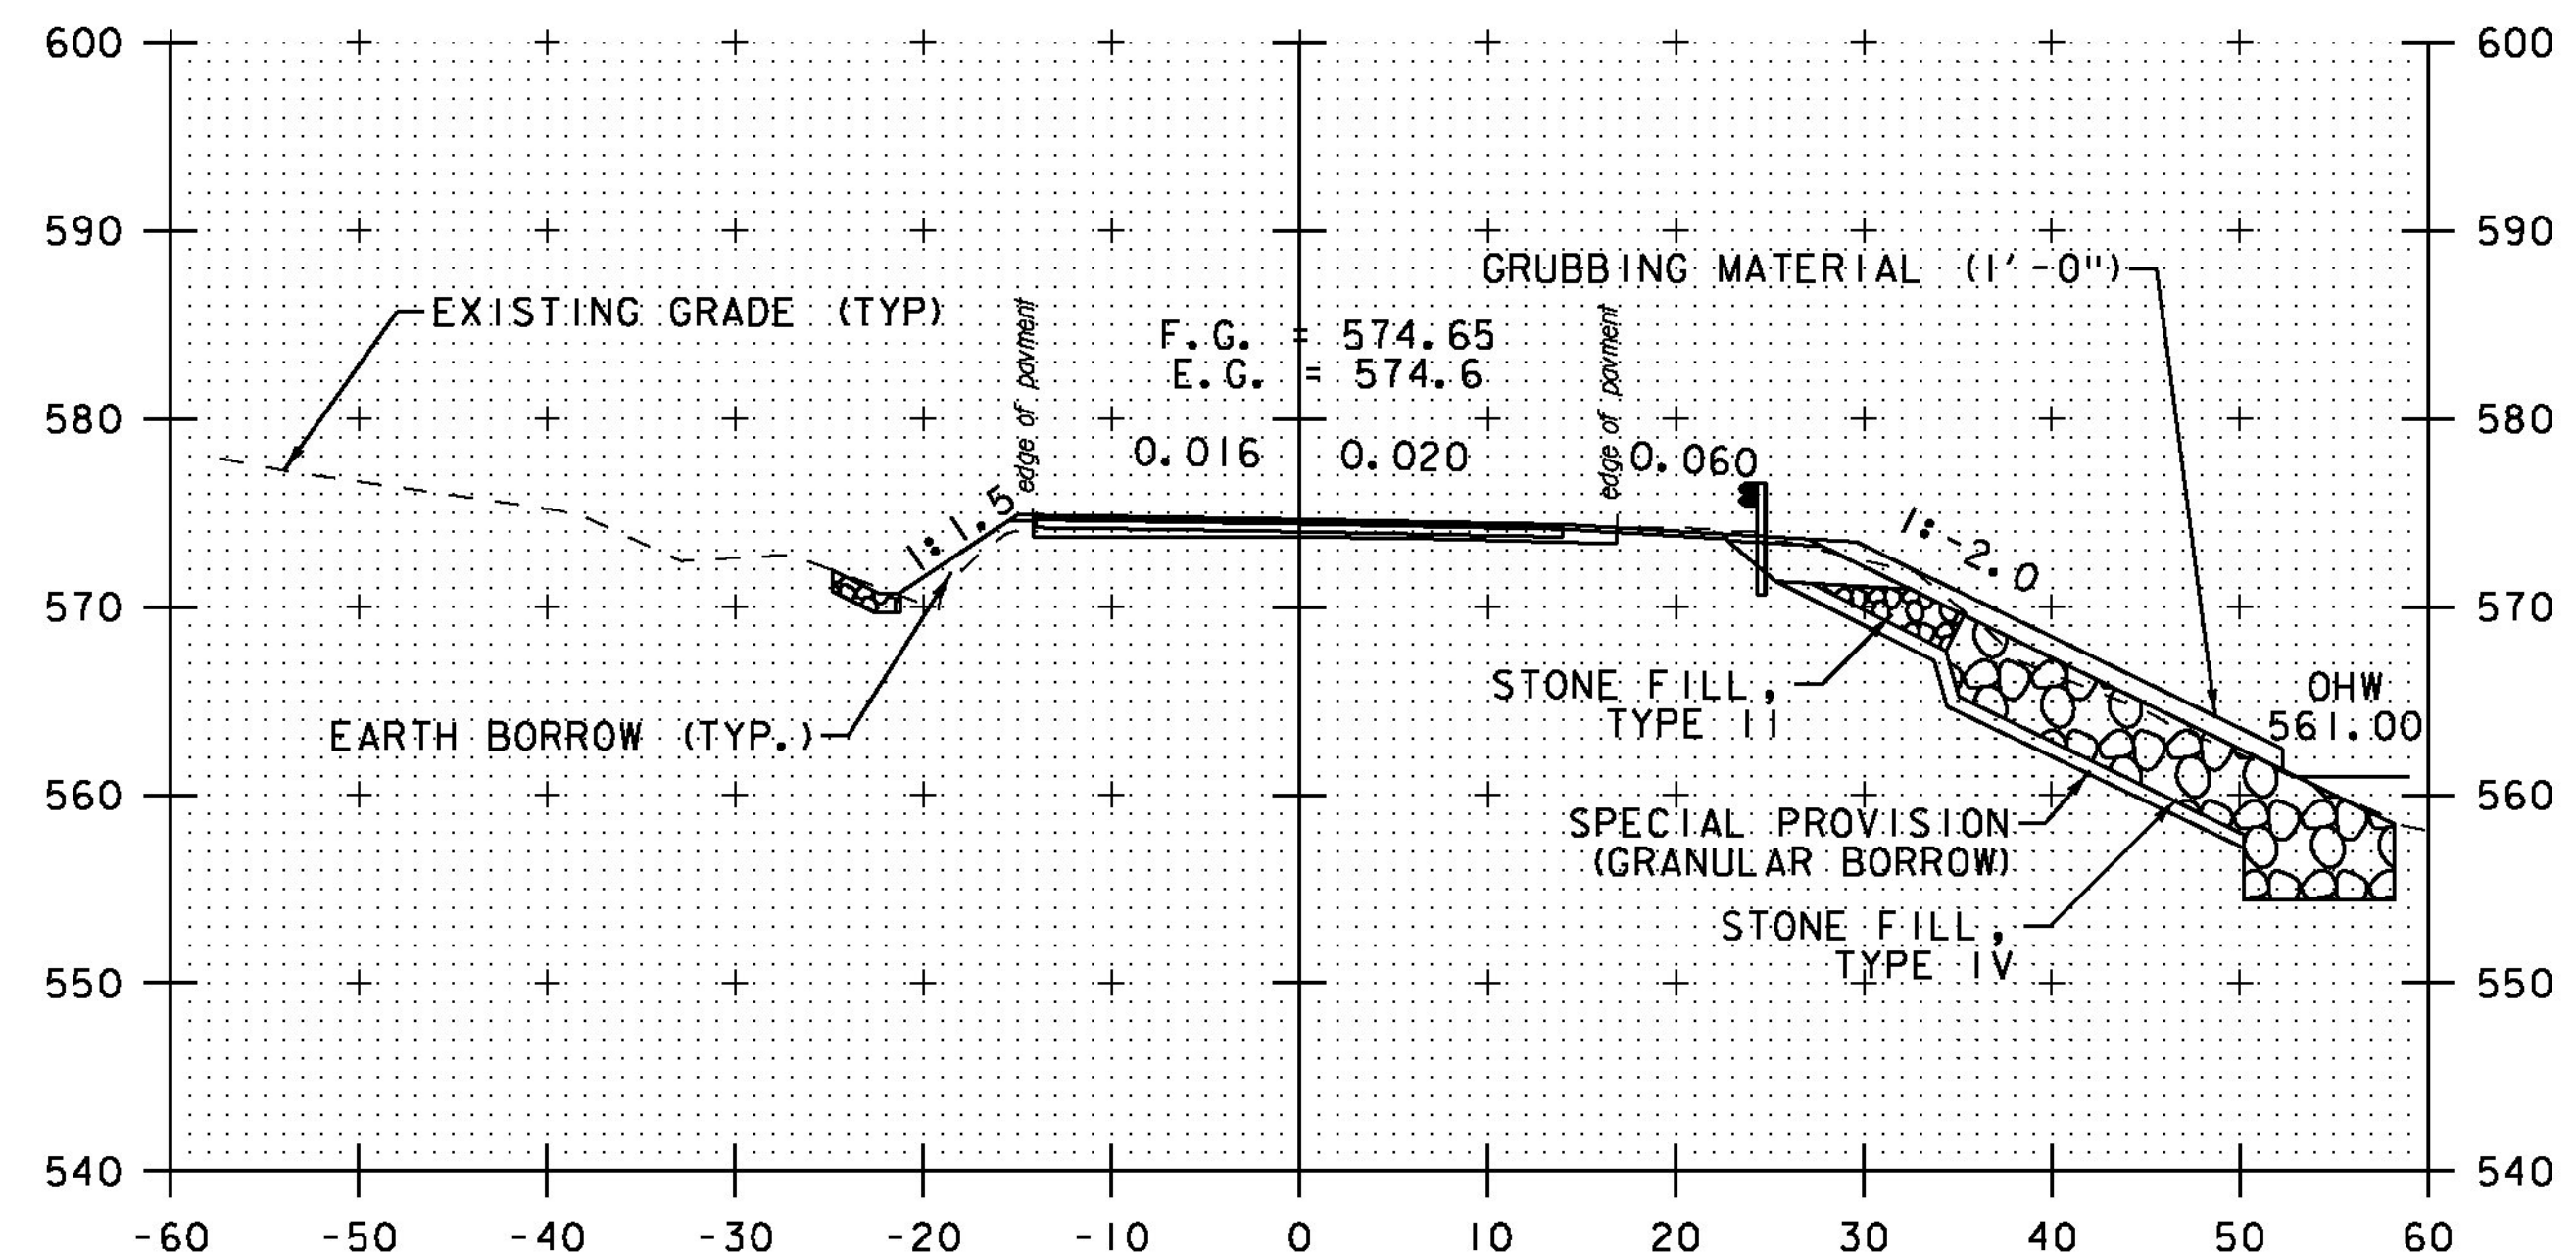

PULL OFF RT  
2+50

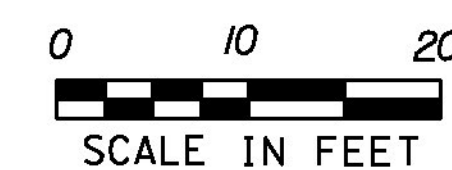

STA. 1+50 TO STA. 3+00

PROJECT NAME: MORETOWN  
PROJECT NUMBER: ER STP 0167 (15)

FILE NAME: z12c524xs.dgn  
PROJECT LEADER: J. TUCKER  
DESIGNED BY: B. BRESLEND  
VT 100B CROSS SECTION SHEET 1

PLOT DATE: 2/17/2015  
DRAWN BY: B. MACK  
CHECKED BY: A. SANZ  
SHEET 45 OF 57