




4+00

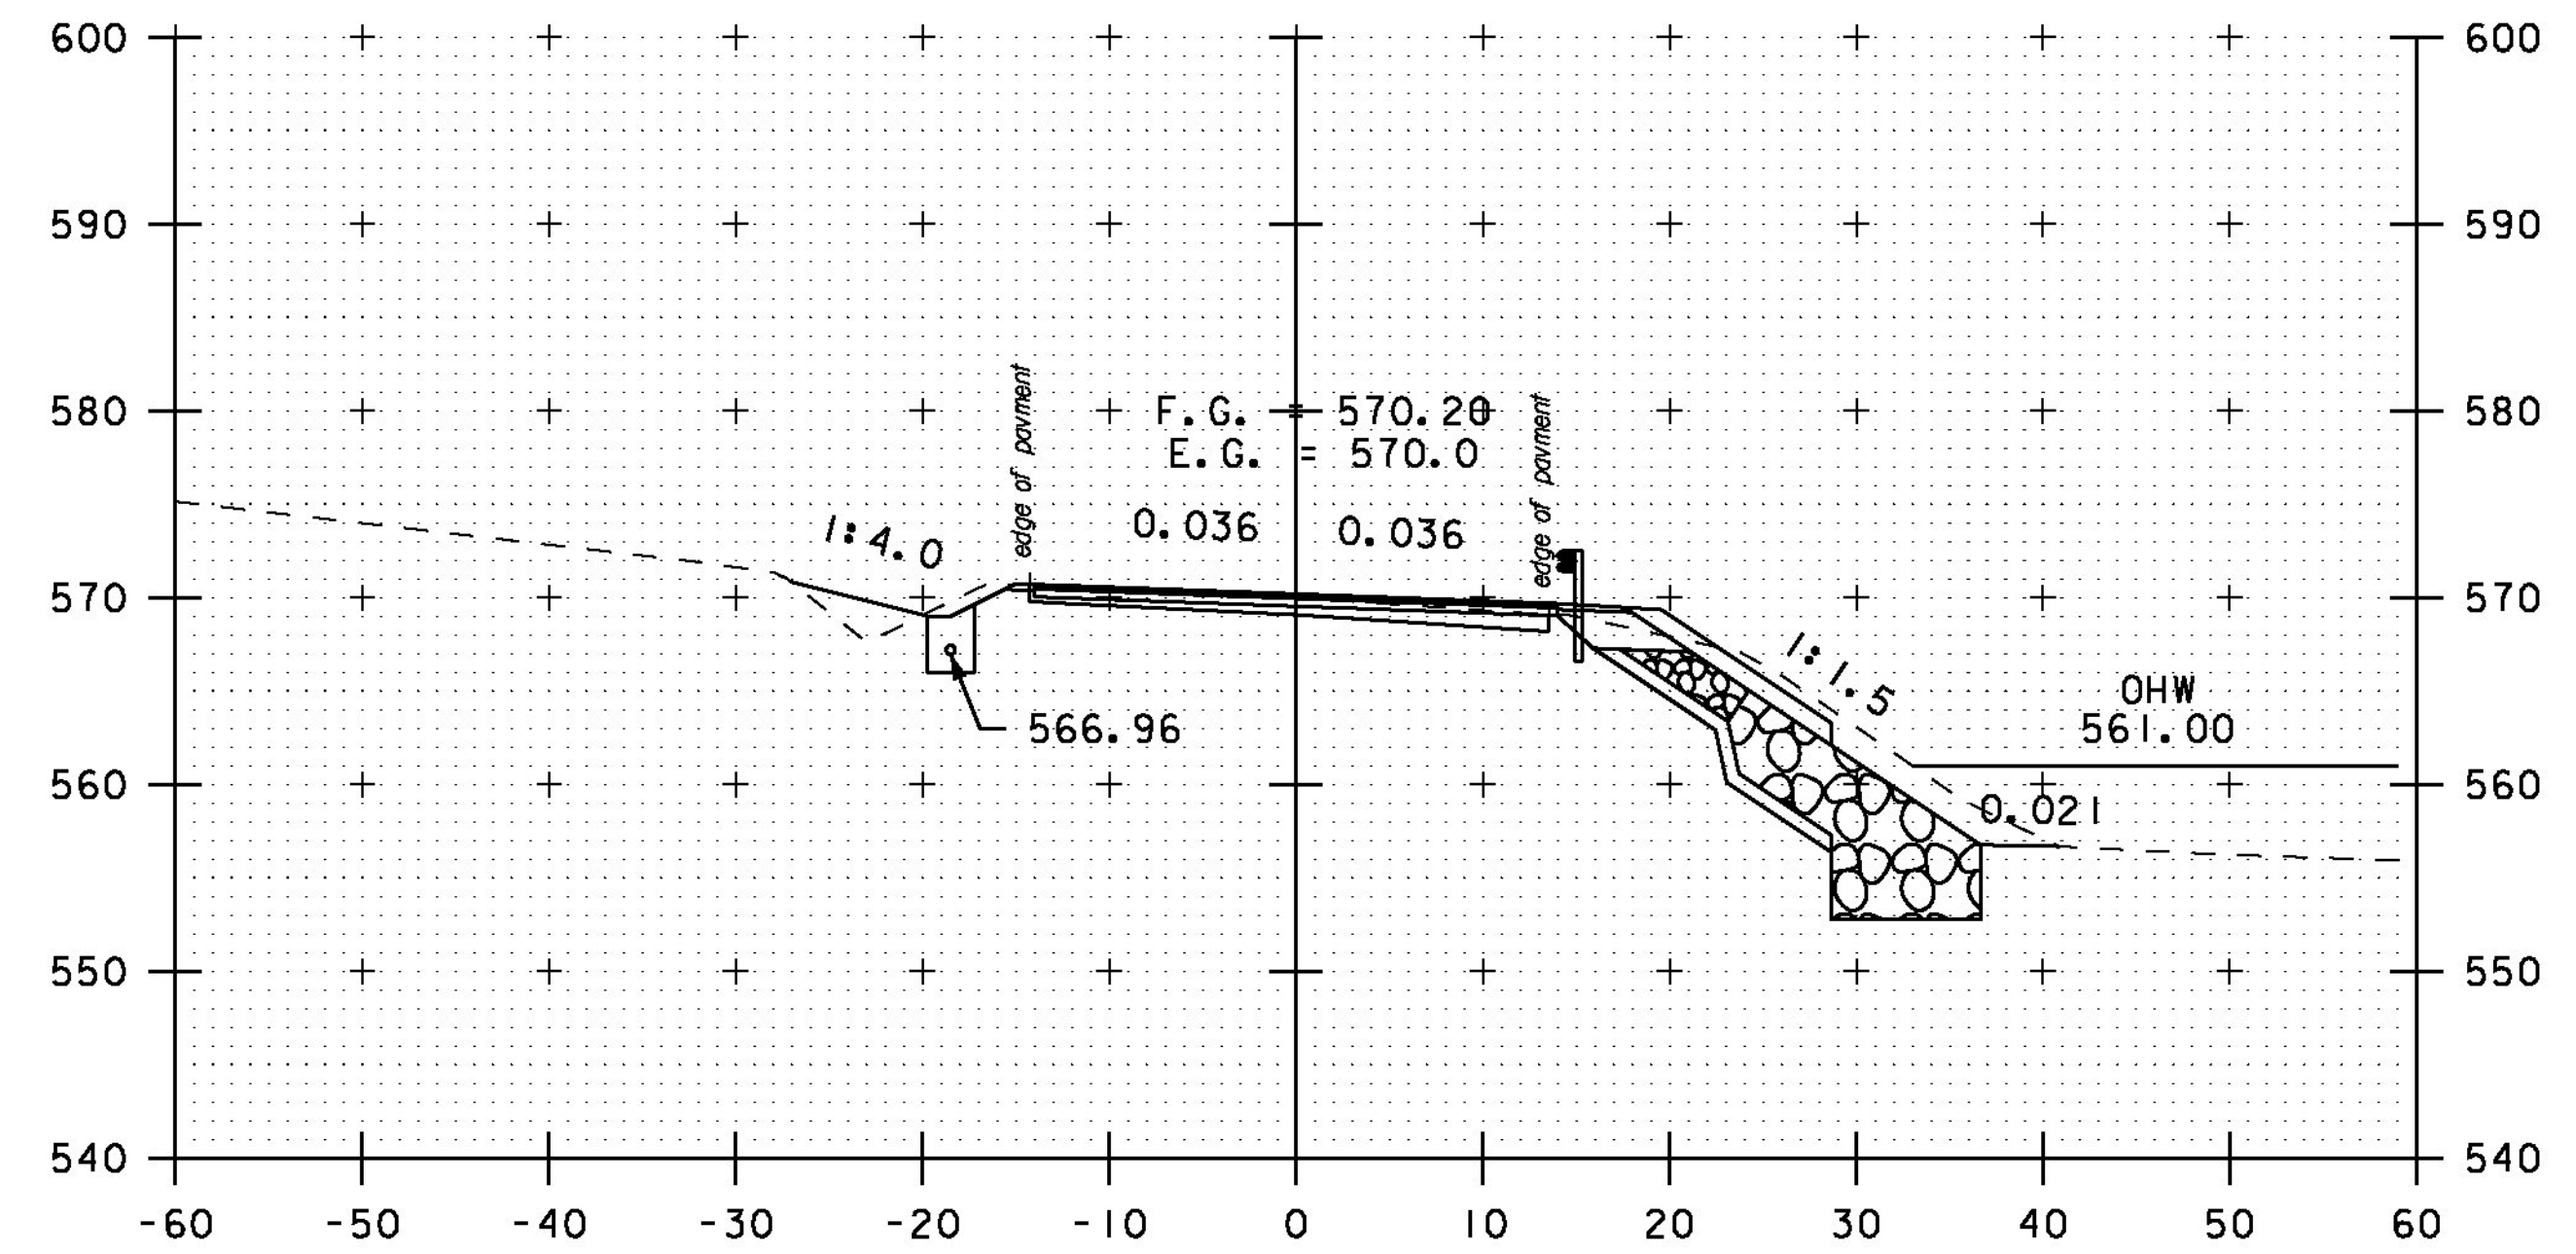

5+00

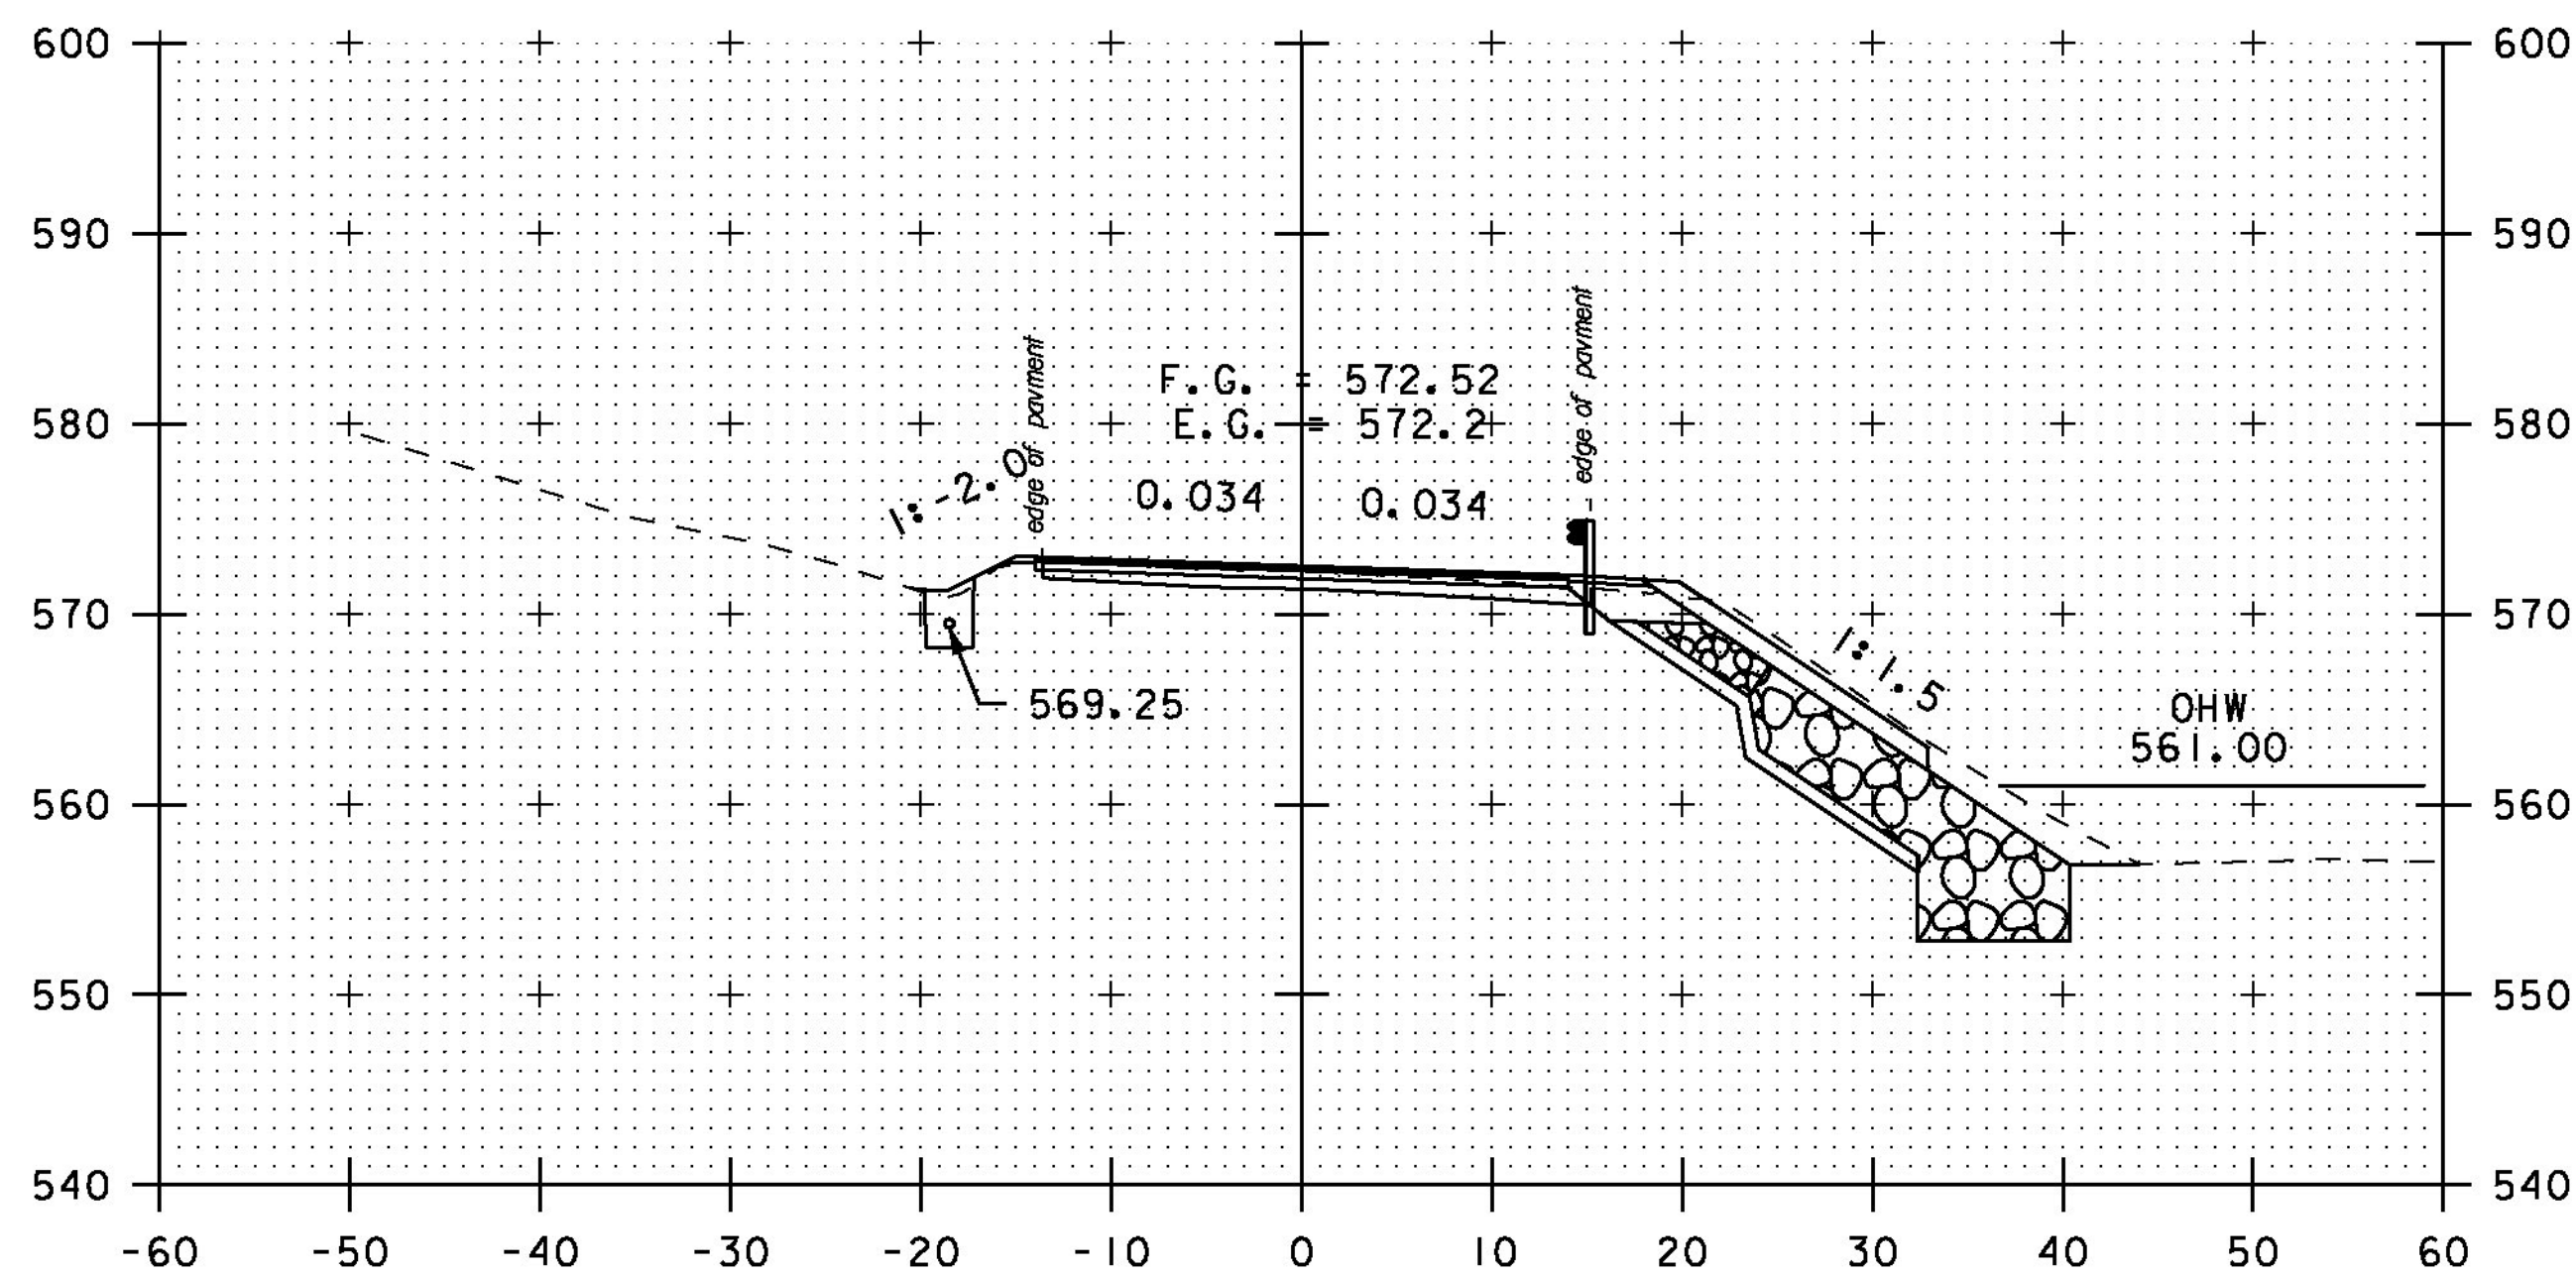

3+50

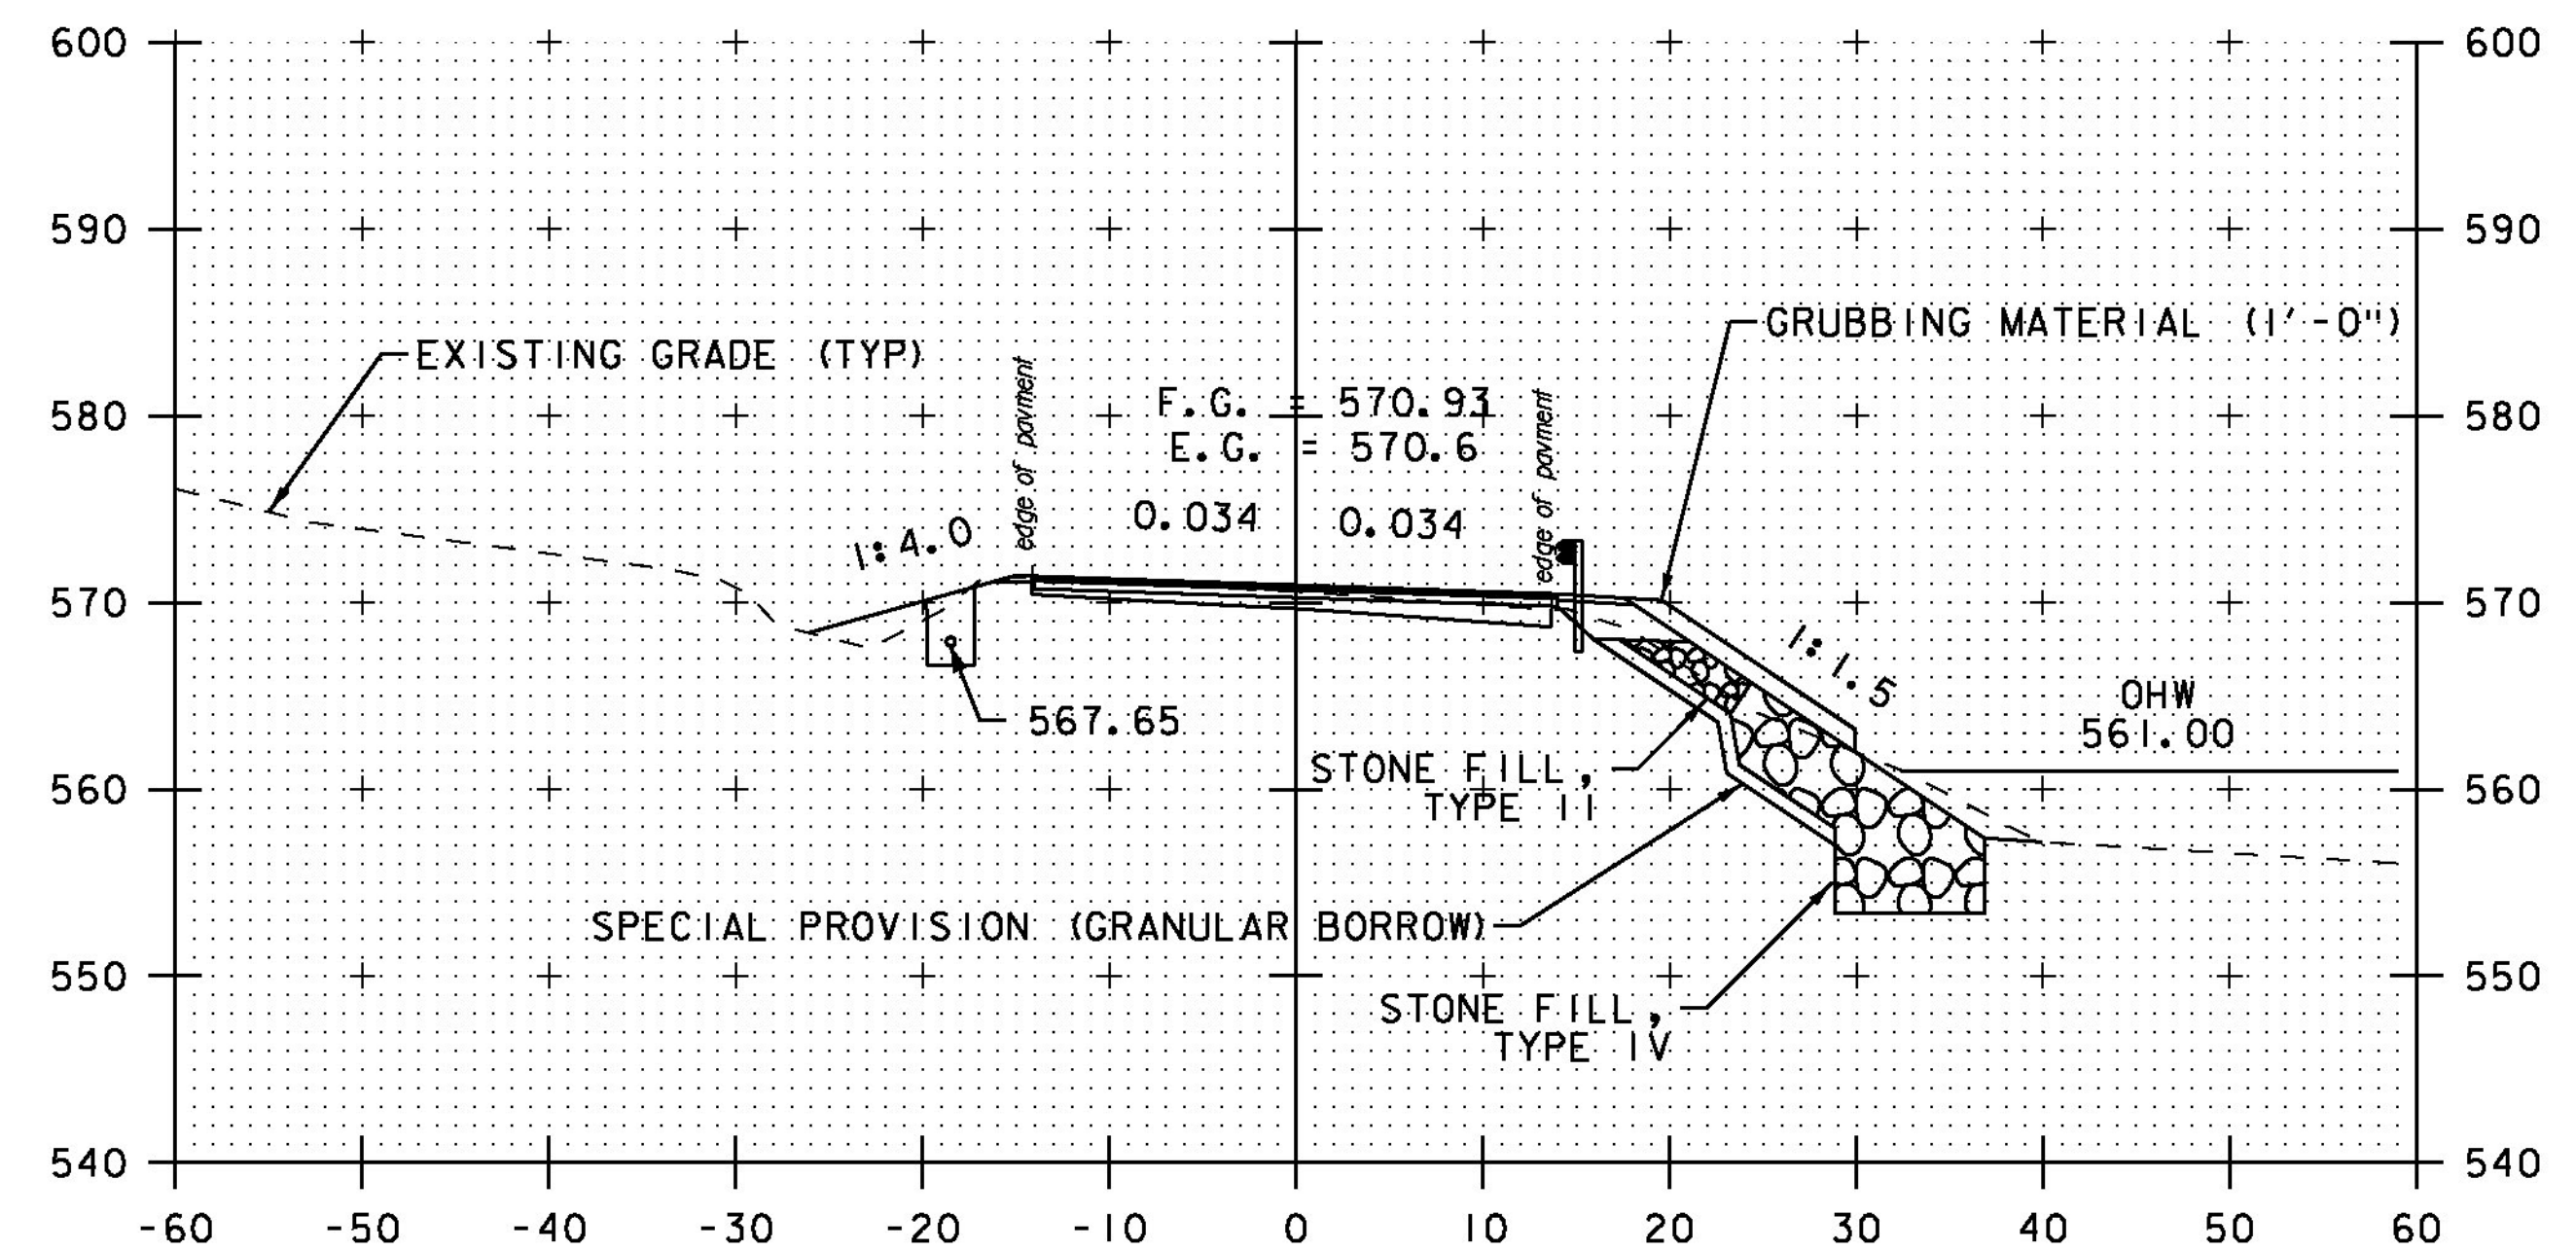

4+50

STA. 3+50 TO STA. 5+00

PROJECT NAME: MORETOWN  
 PROJECT NUMBER: ER STP 0167 (15)

FILE NAME: z12c524xs.dgn  
 PROJECT LEADER: J. TUCKER  
 DESIGNED BY: B. BRESLEND  
 VT 100B CROSS SECTION SHEET 2  
 PLOT DATE: 2/17/2015  
 DRAWN BY: B. MACK  
 CHECKED BY: A. SANZ  
 SHEET 46 OF 57

