




8+00

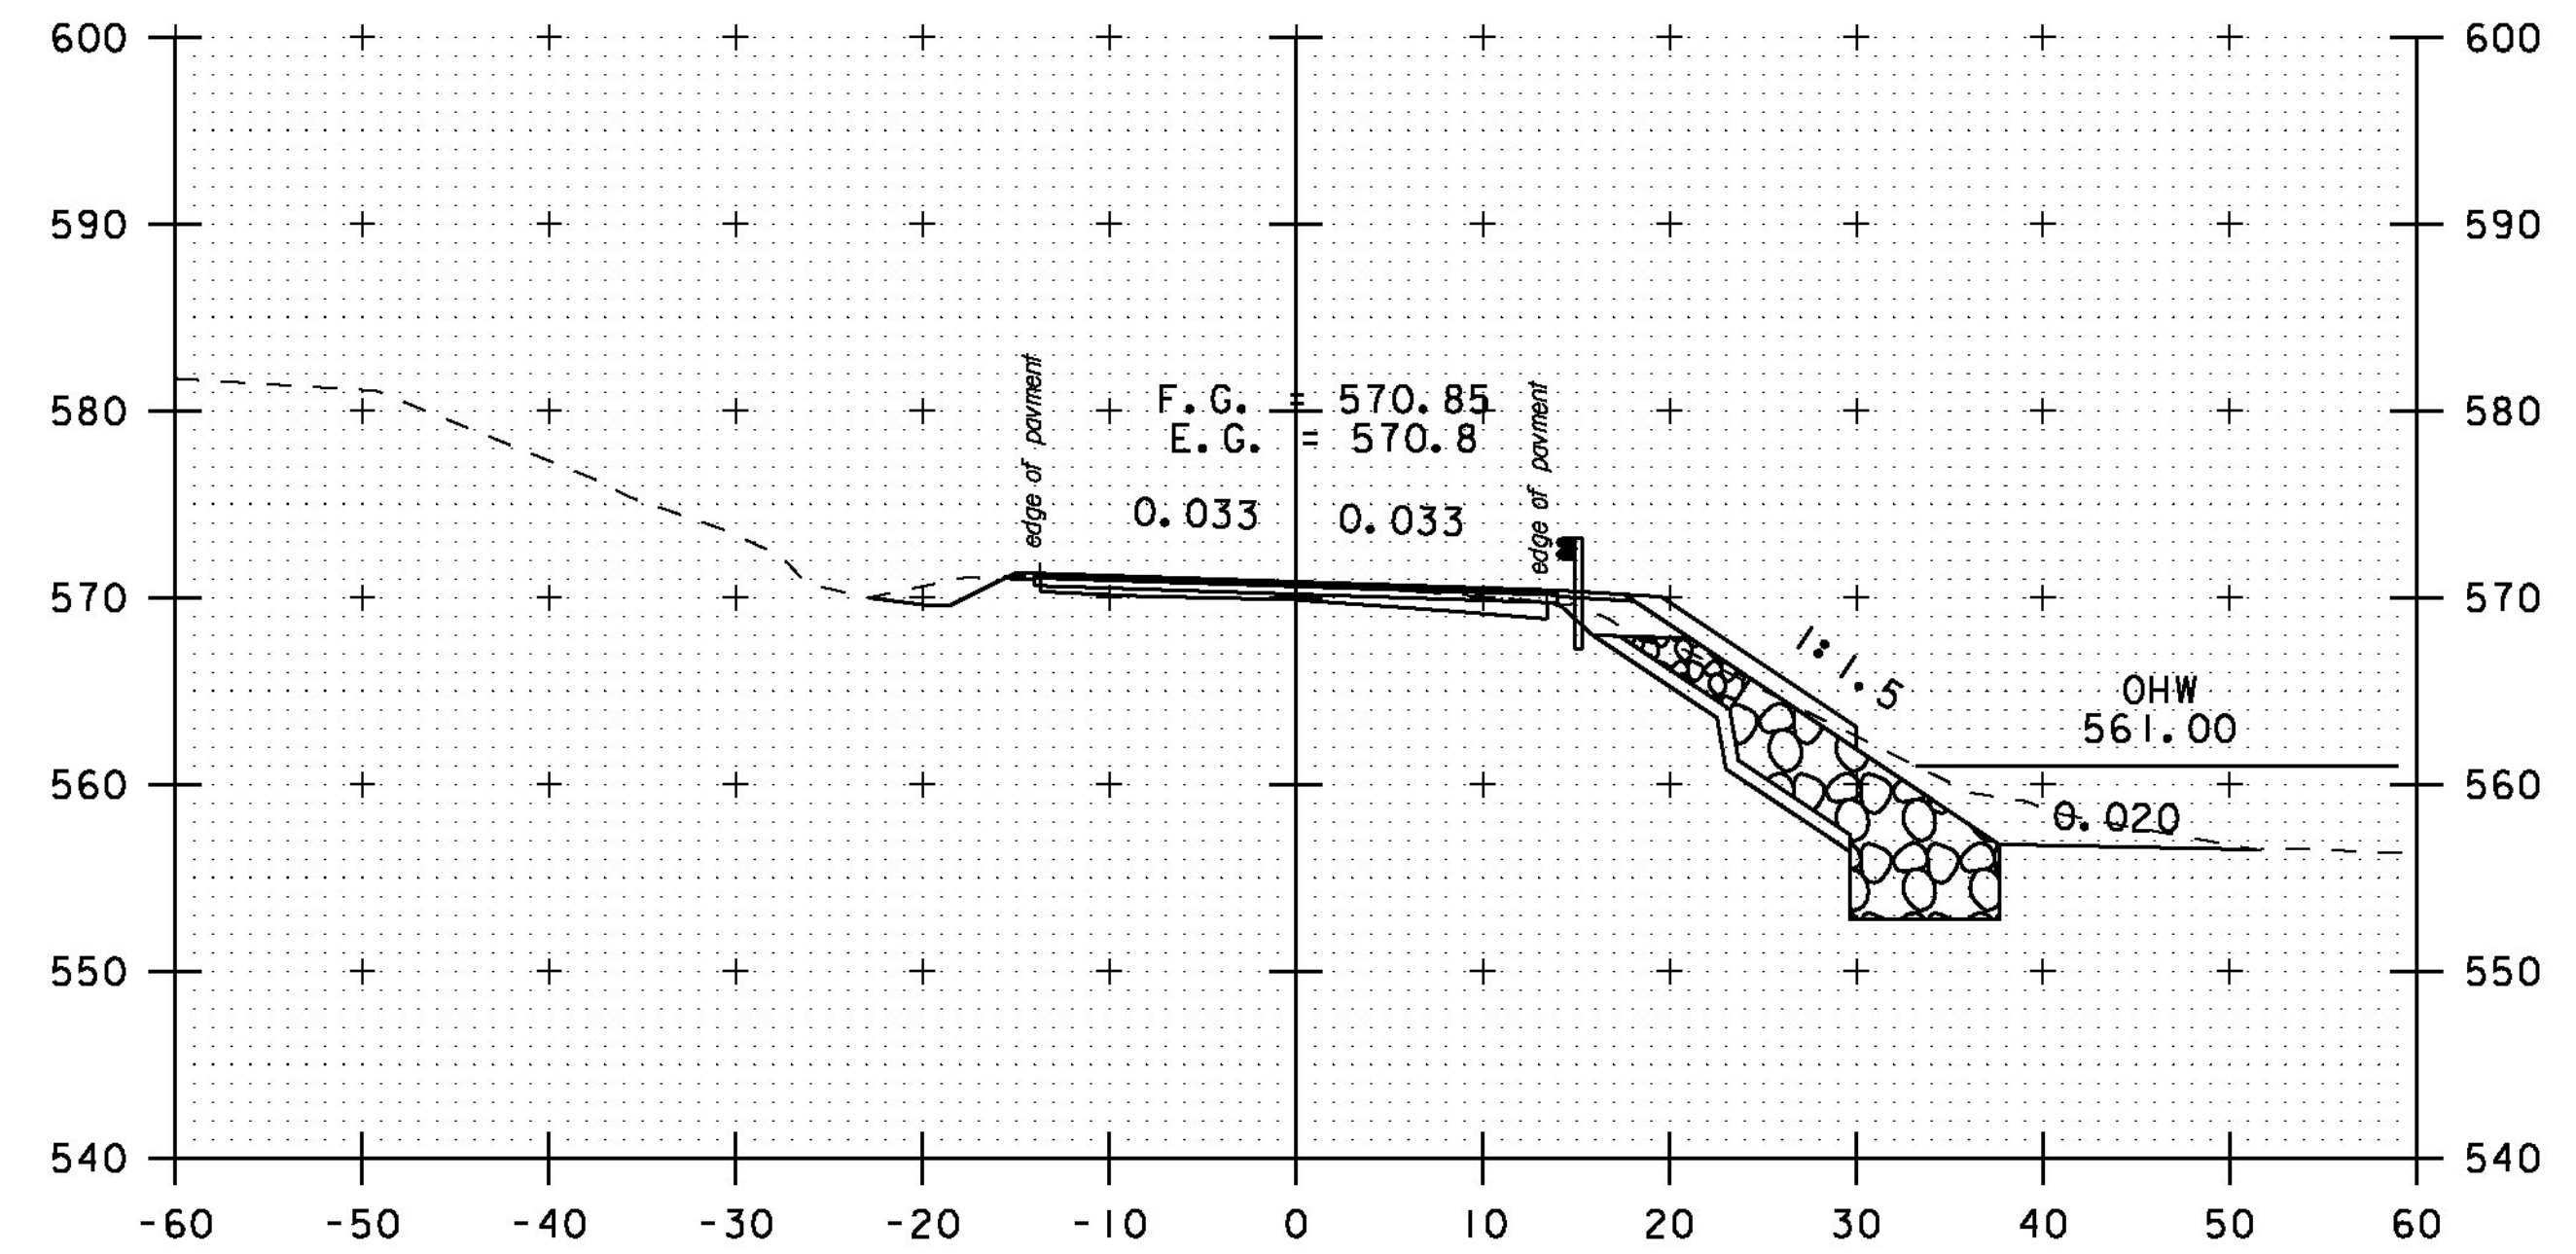


9+00

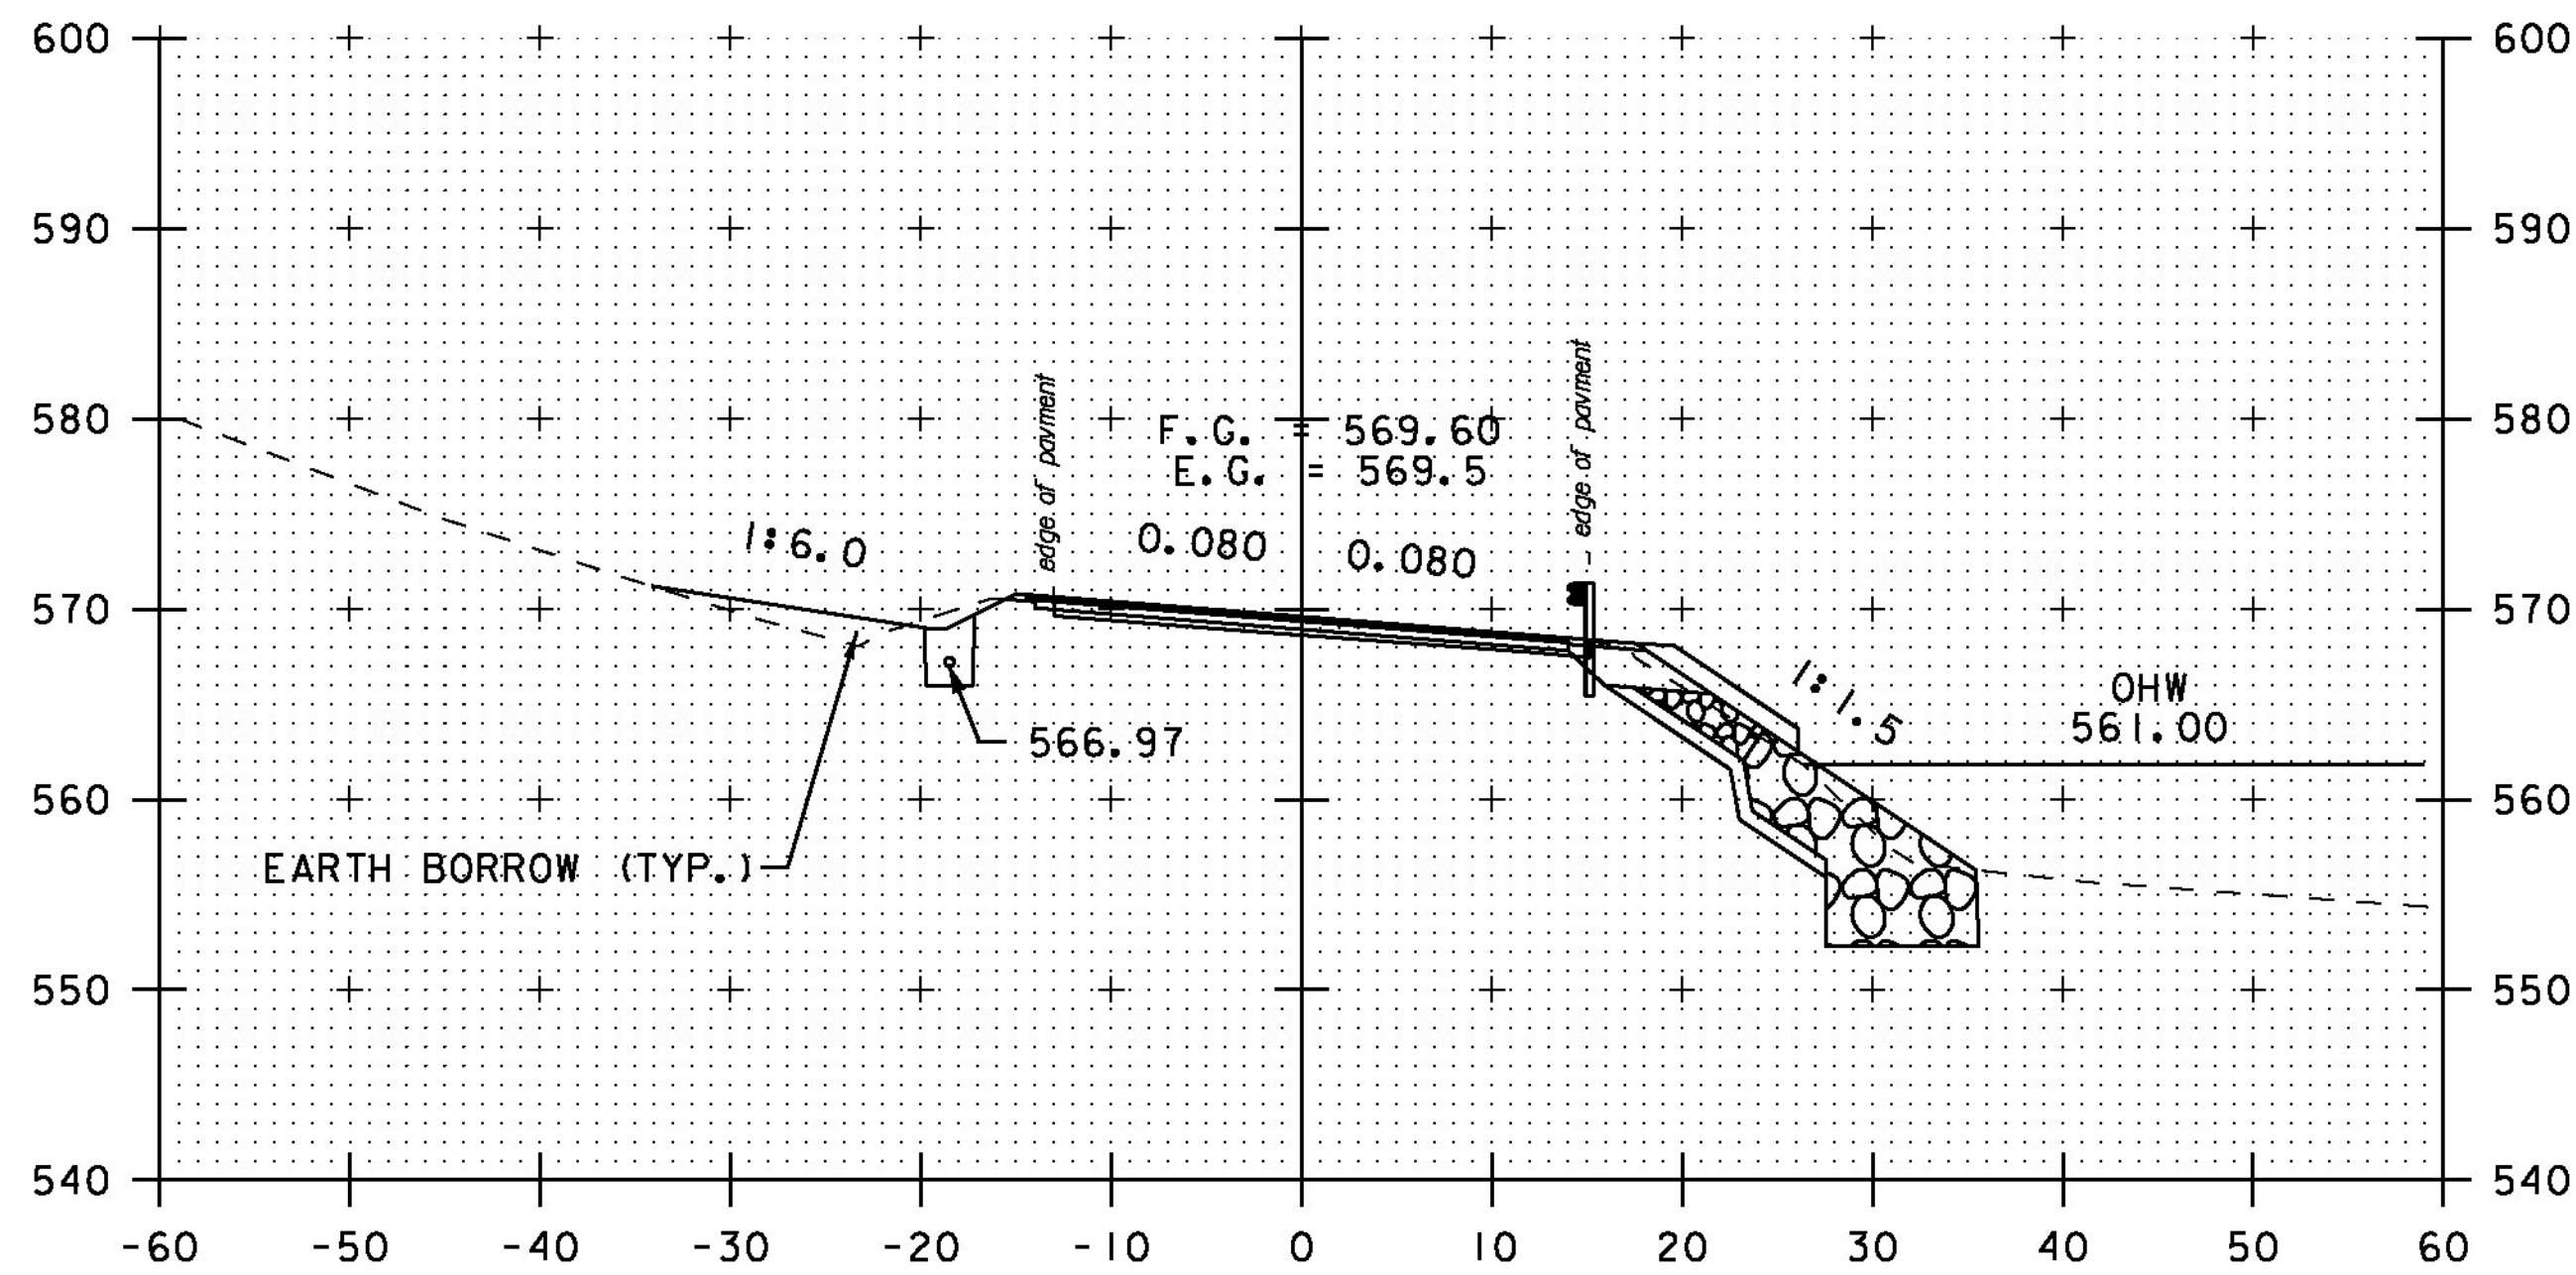

7+50

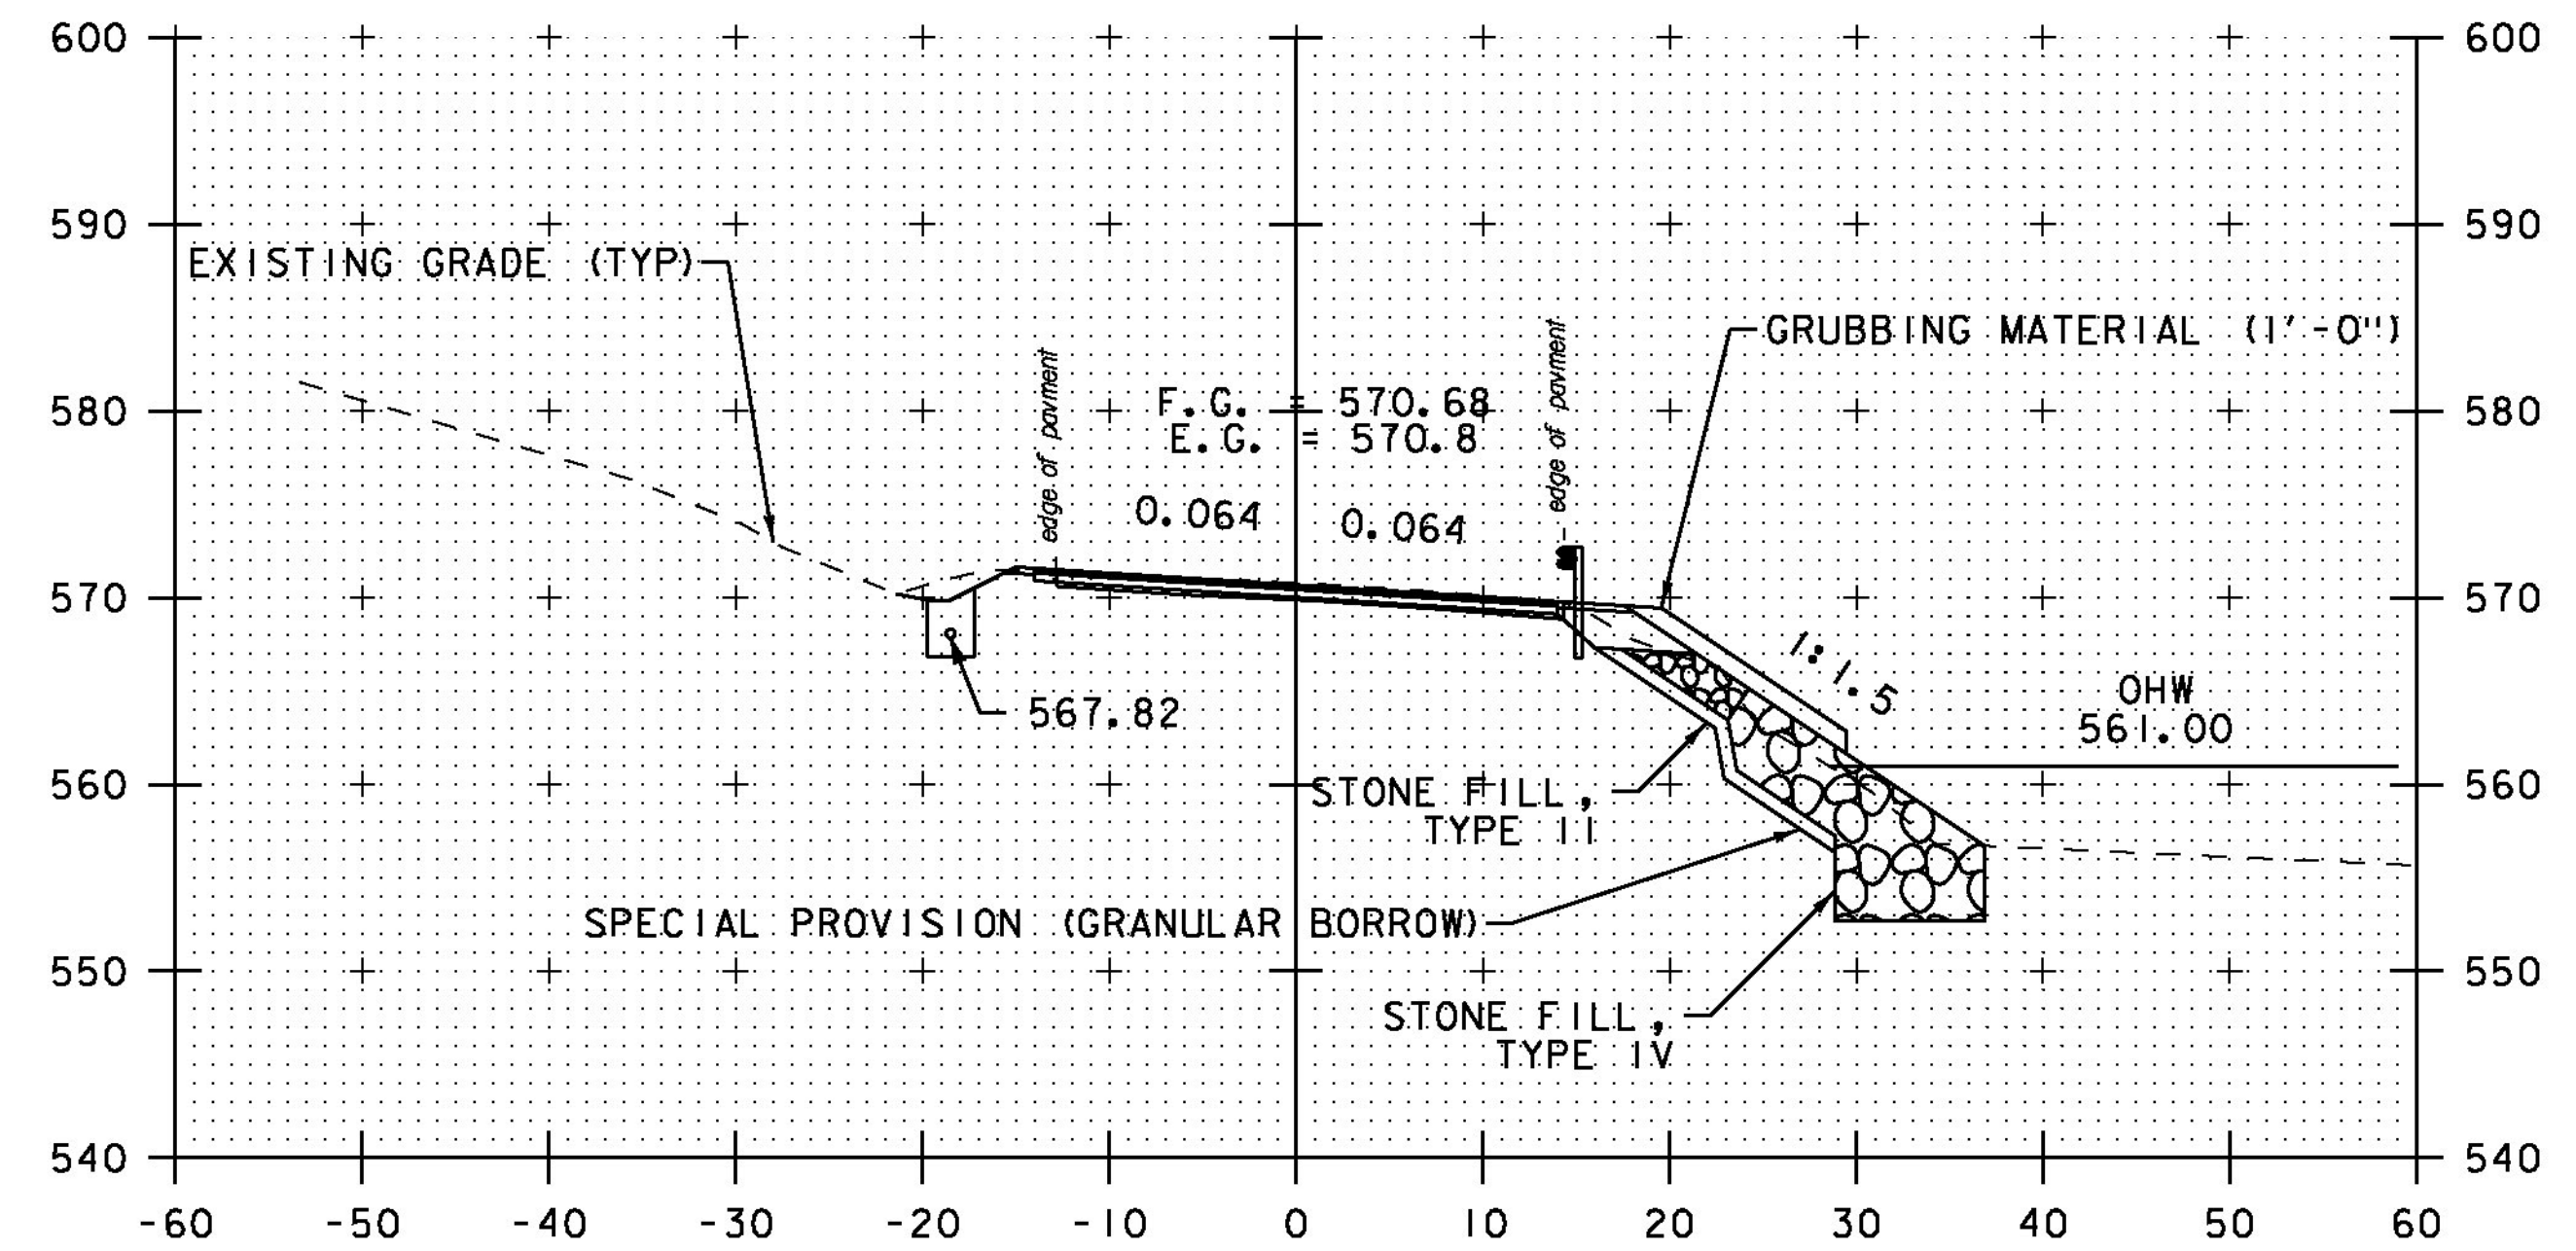

8+50

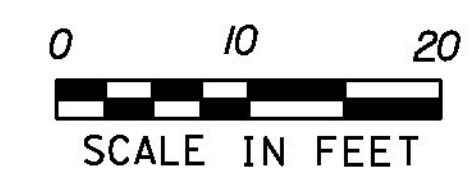

STA. 7+50 TO STA. 9+00

PROJECT NAME: MORETOWN
PROJECT NUMBER: ER STP 0167 (15)

FILE NAME: z12c524xs.dgn	PLOT DATE: 2/17/2015
PROJECT LEADER: J. TUCKER	DRAWN BY: B. MACK
DESIGNED BY: B. BRESLEND	CHECKED BY: A. SANZ
VT 100B CROSS SECTION SHEET 4	SHEET 48 OF 57