
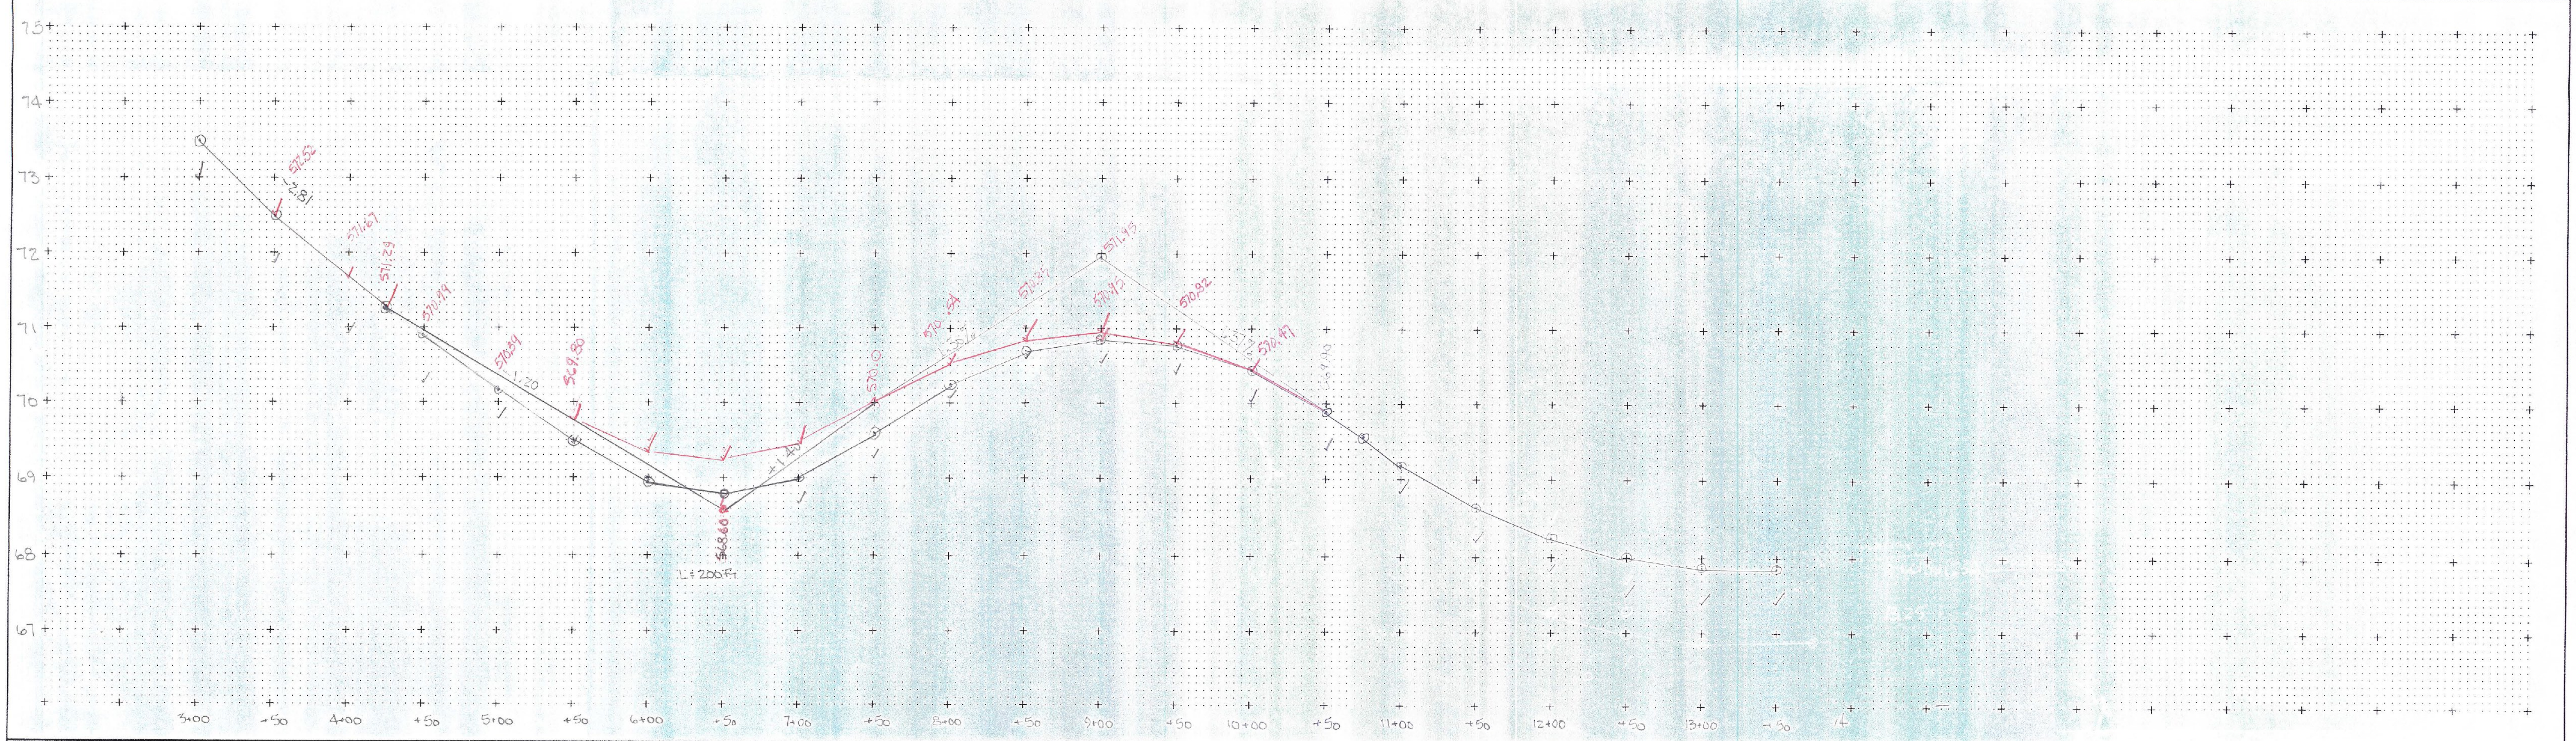


# PLAN & PROFILE SHEET

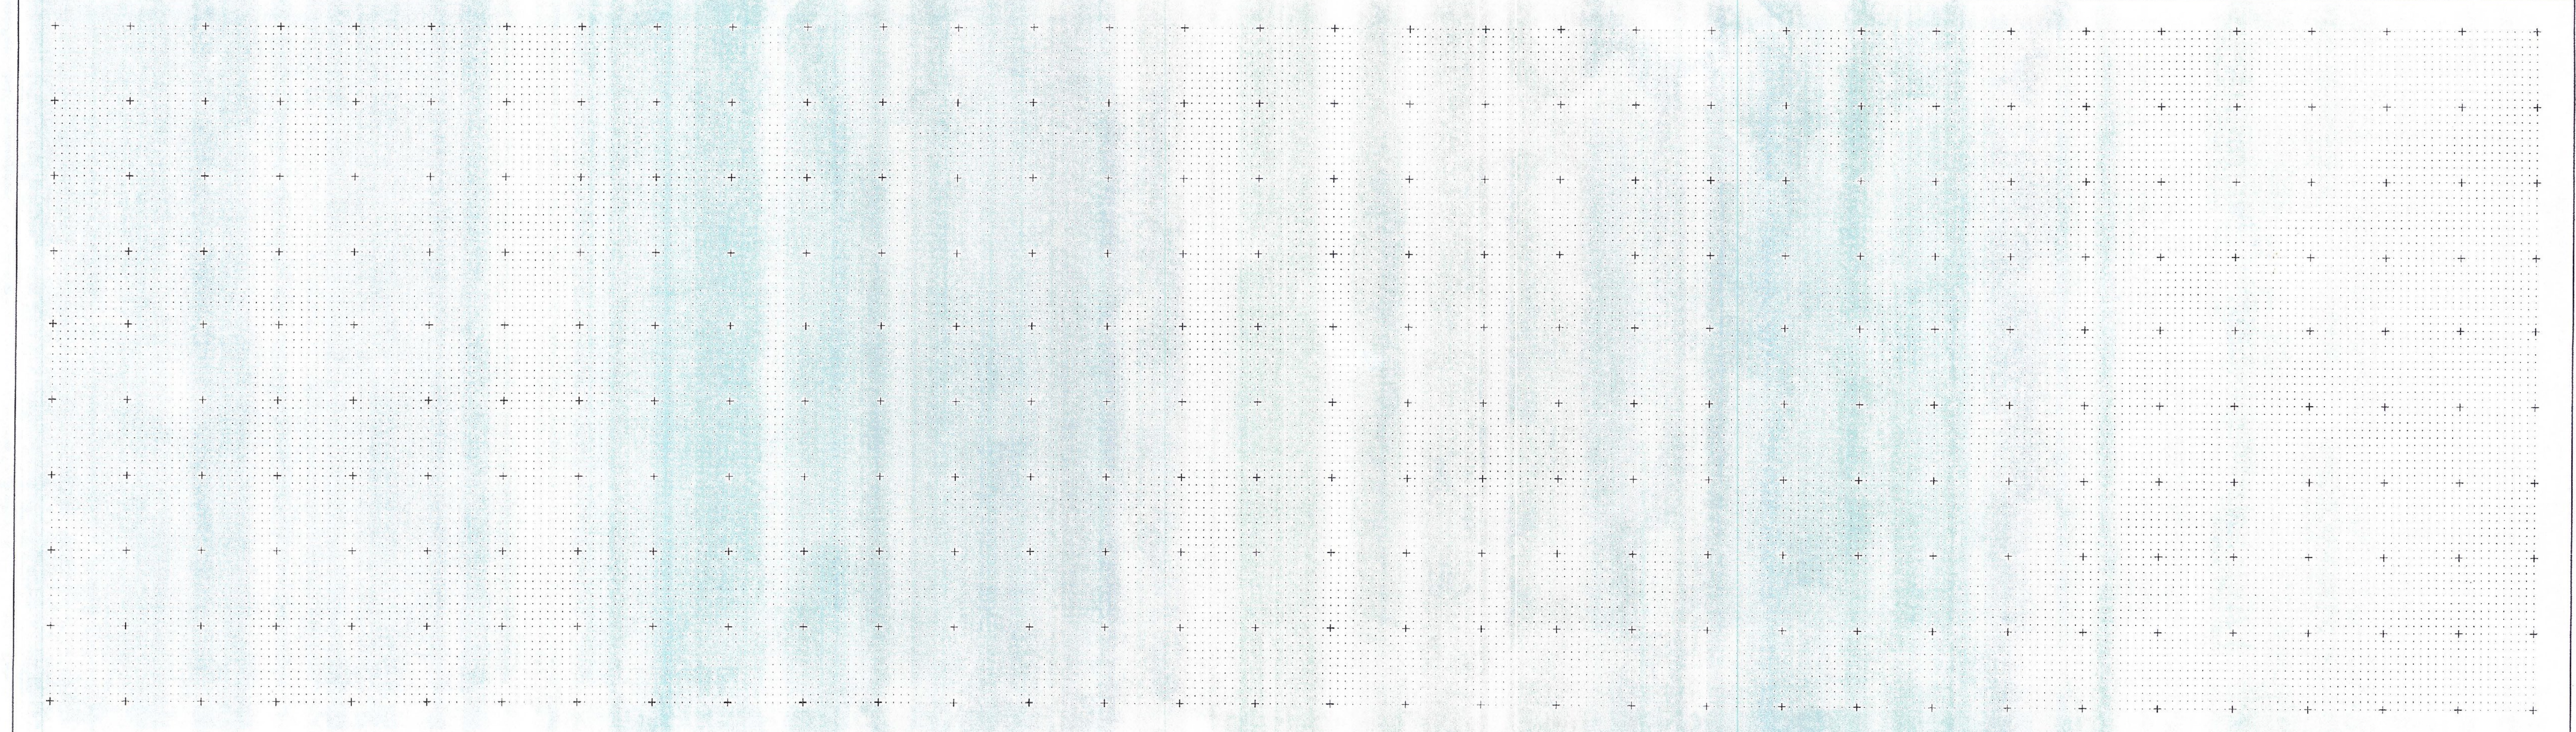

PROJECT NAME: Mosstown ER STP 0167 (15)  
 PROJECT NUMBER: \_\_\_\_\_  
 FILE NAME: T:\user\jason\mosstown PLOT DATE: 12-MAY-2005 16:0  
 PROJECT LEADER: \_\_\_\_\_ DRAWN BY: \_\_\_\_\_  
 DESIGNED BY: \_\_\_\_\_ CHECKED BY: \_\_\_\_\_  
 const: g:/common/cadd/e-xsection.dgn SHEET \_\_\_\_ OF \_\_\_\_