


BR 6 BRAINTREE MM 3.879 = STA. 204+81.12

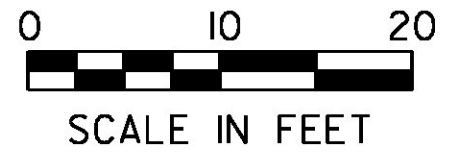

PROJECT NAME:	BRAINTREE
PROJECT NUMBER:	ER STP 0187(12)
FILE NAME:	z12c526typ.dgn
PROJECT LEADER:	G. EDWARDS
DESIGNED BY:	I. MAYNARD
BRIDGE 6 DETAIL SHEET 4	
PLOT DATE:	1/10/2014
DRAWN BY:	G. BURGMEIER
CHECKED BY:	M. FOISY
SHEET	28 OF 72